

Scale 4" = 1 Mile

Dec. 1


Permit: S 11529

Volume: 1A

Strm: STRATTON CR

Trib: ROGUE R

Priority: 12/24/34

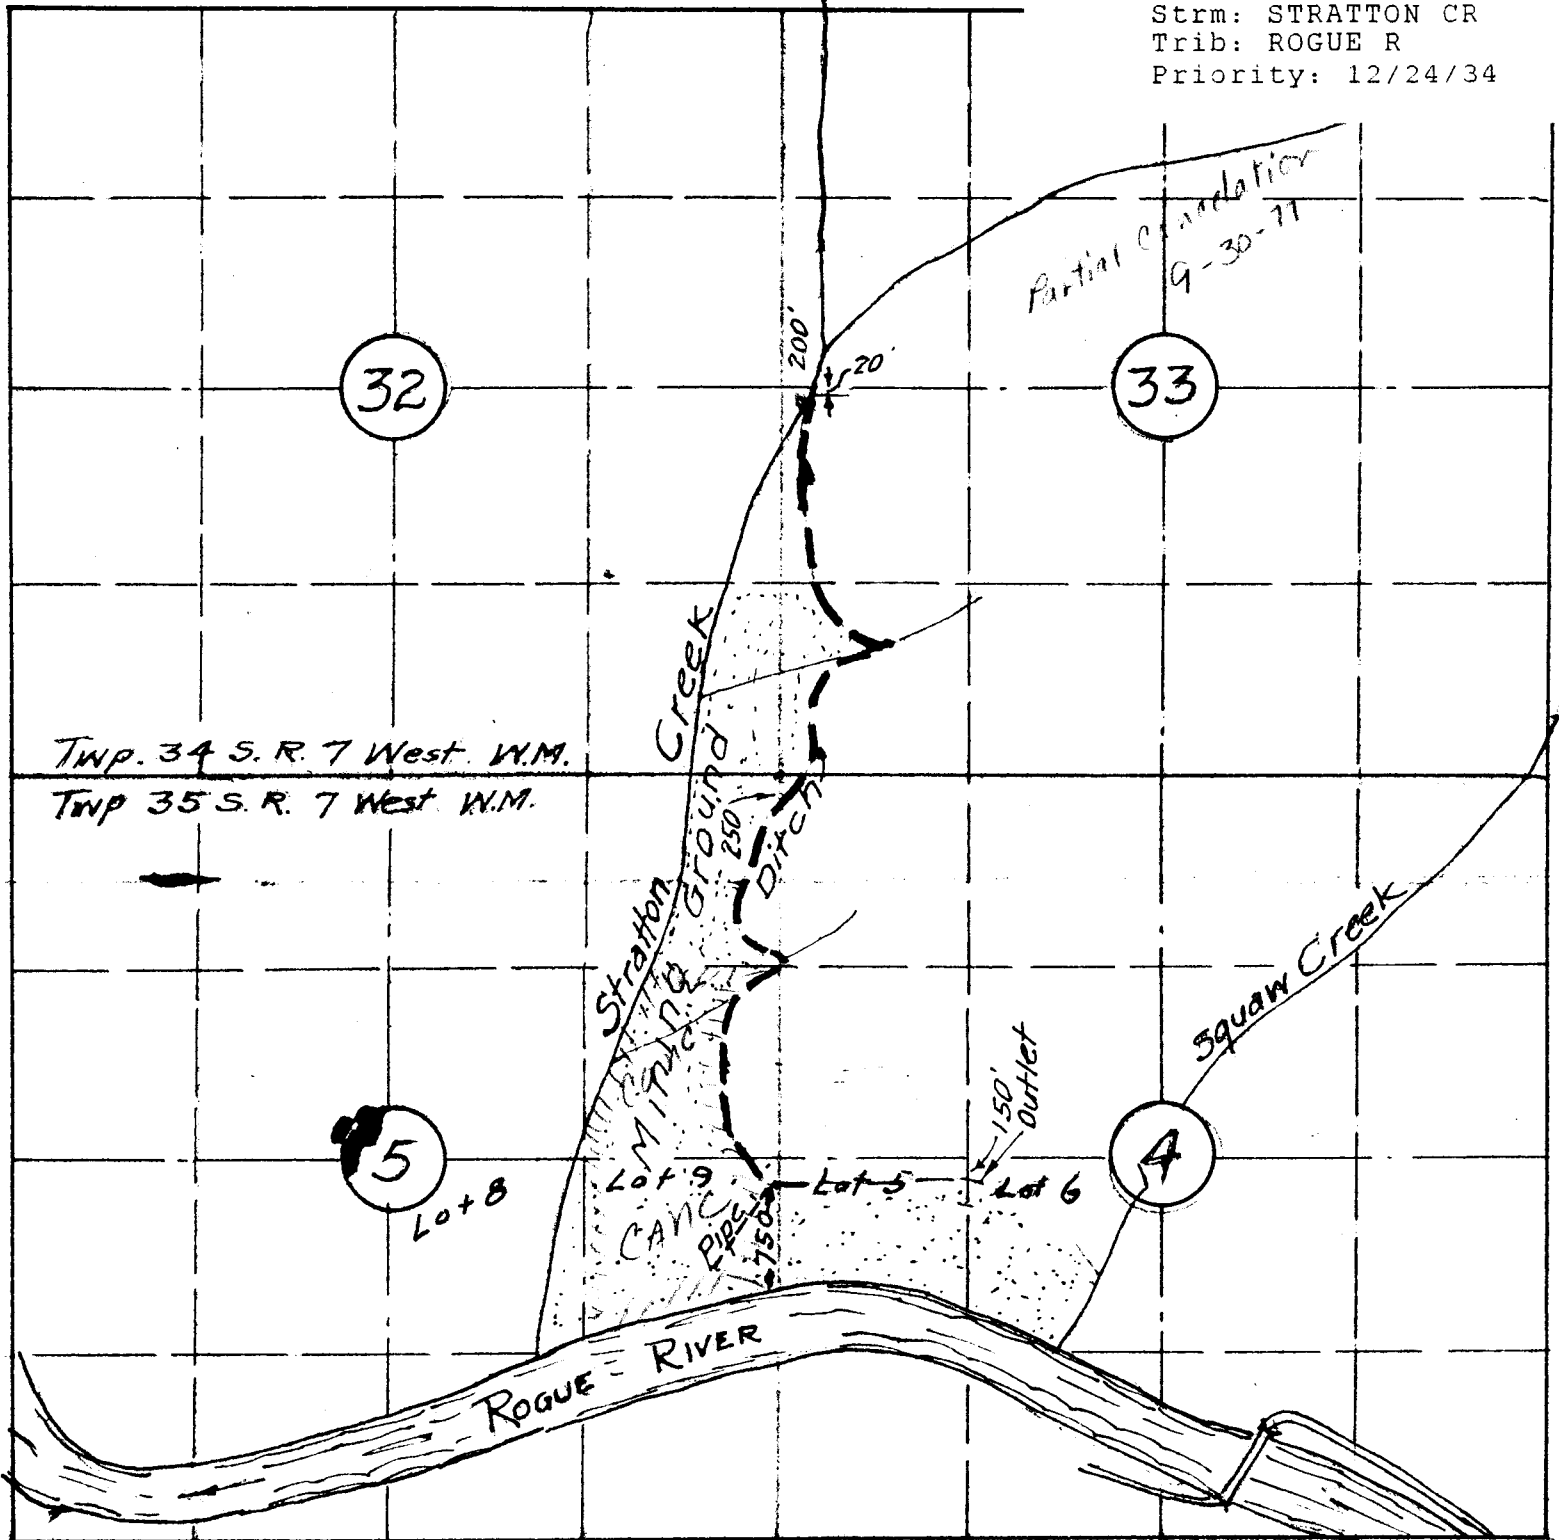

N

I, Tom R. Pearce, of Grants Pass, Oregon do hereby certify that this map was made from notes taken during an actual survey made under my supervision on Dec. 17, 1934 and that it correctly represents the work described in the accompanying application together with the location of streams and ditches in the immediate vicinity.

App. No. 15661

Per. No. 11529

