


RECEIVED  
JAN 2 1935  
STATE ENGINEER  
SALEM, OREGON

TOWNSHIP 38 S, RANGE 3 W, W. M.

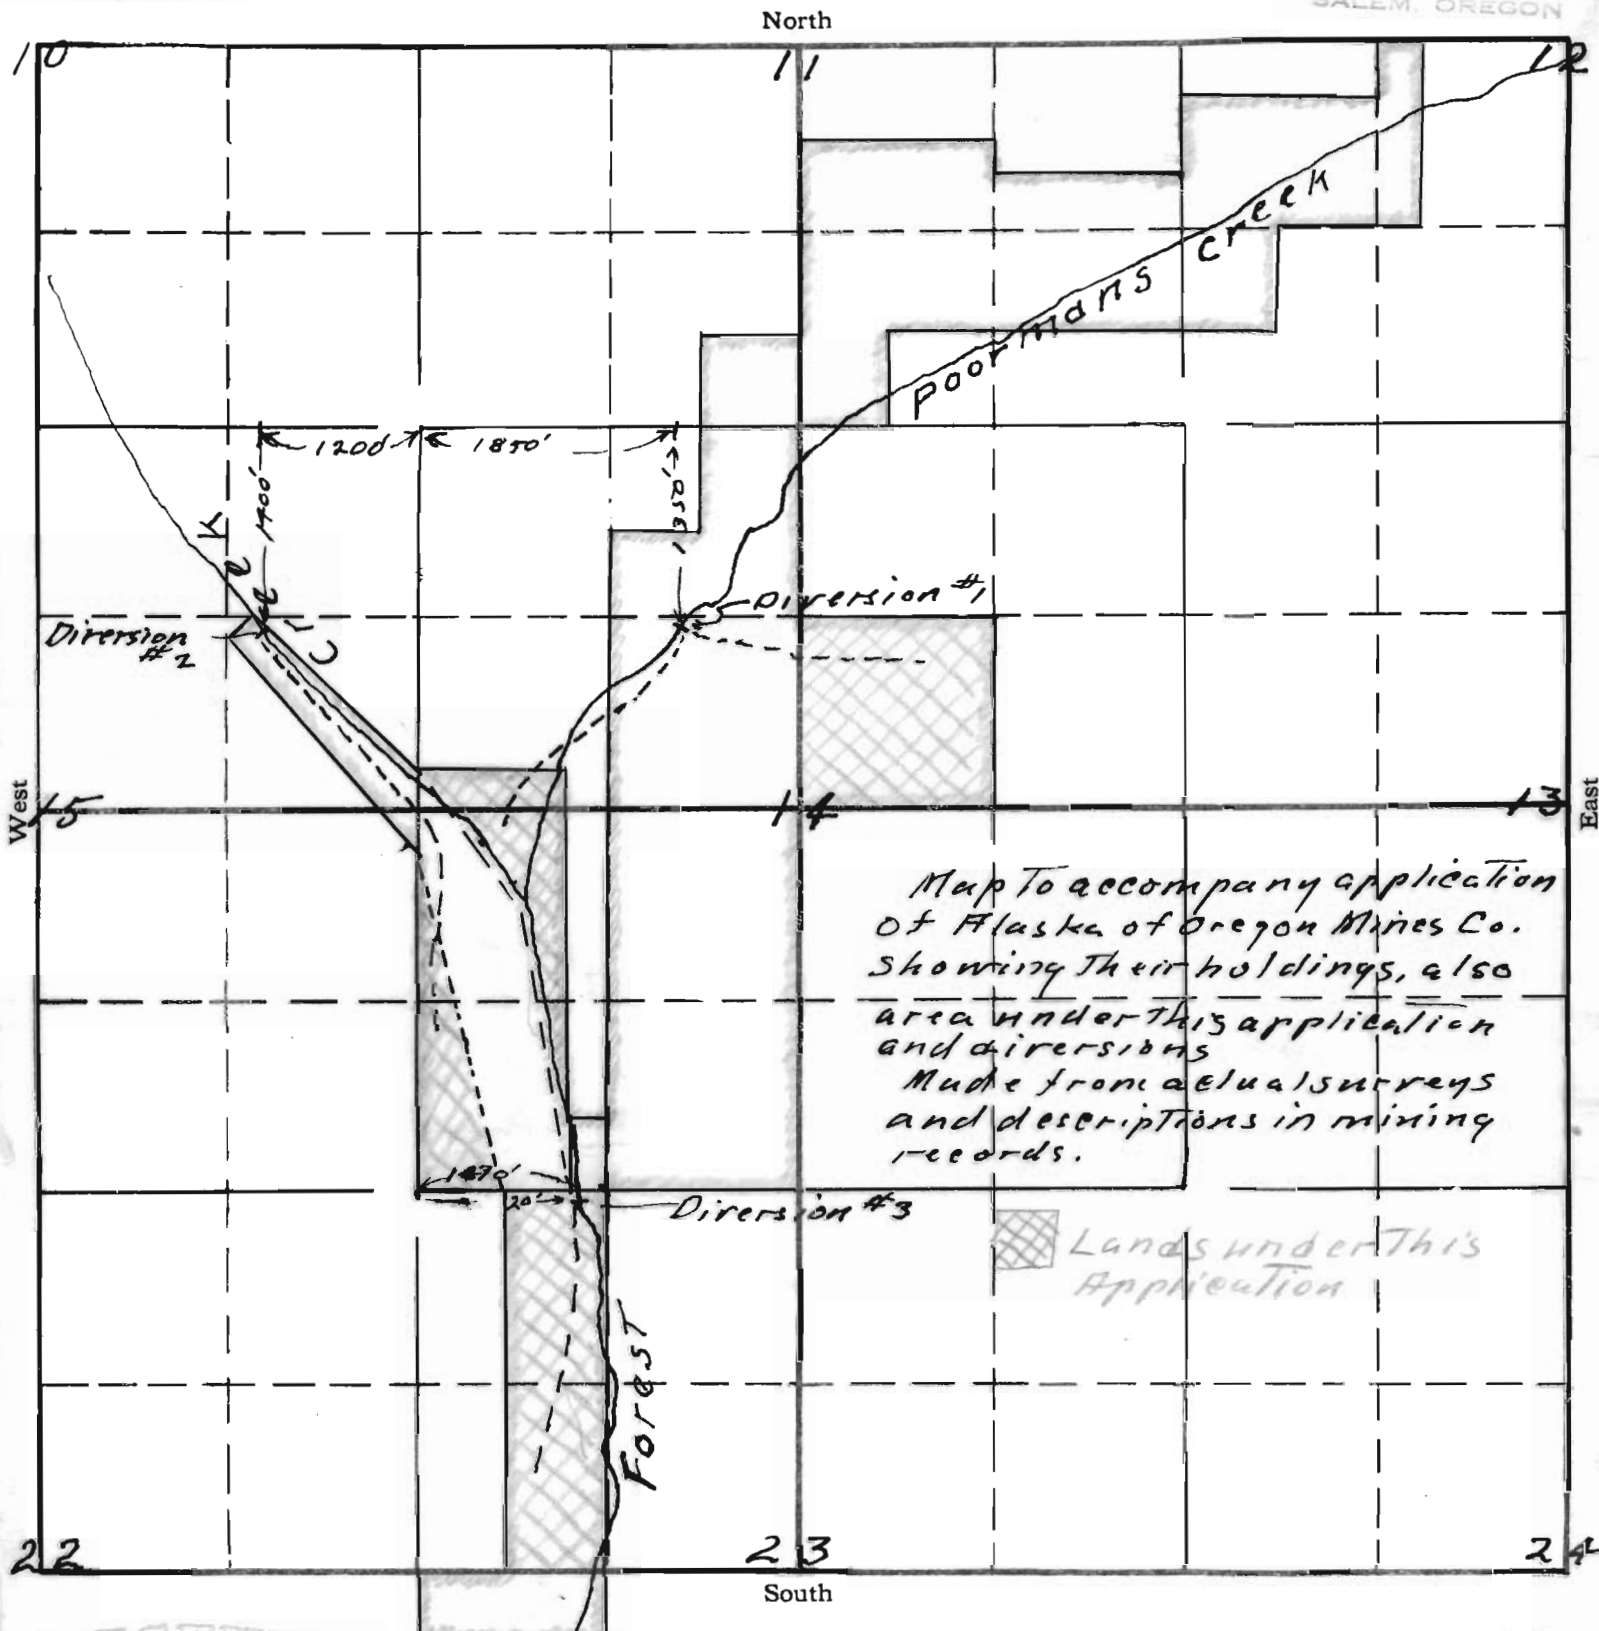

RECEIVED  
DEC 20 1934  
STATE ENGINEER  
SALEM, OREGON

APPLICATION No. 15668  
PERMIT No. 11534