


SECTION

TOWNSHIP 125, RANGE 3E, W. M.

North

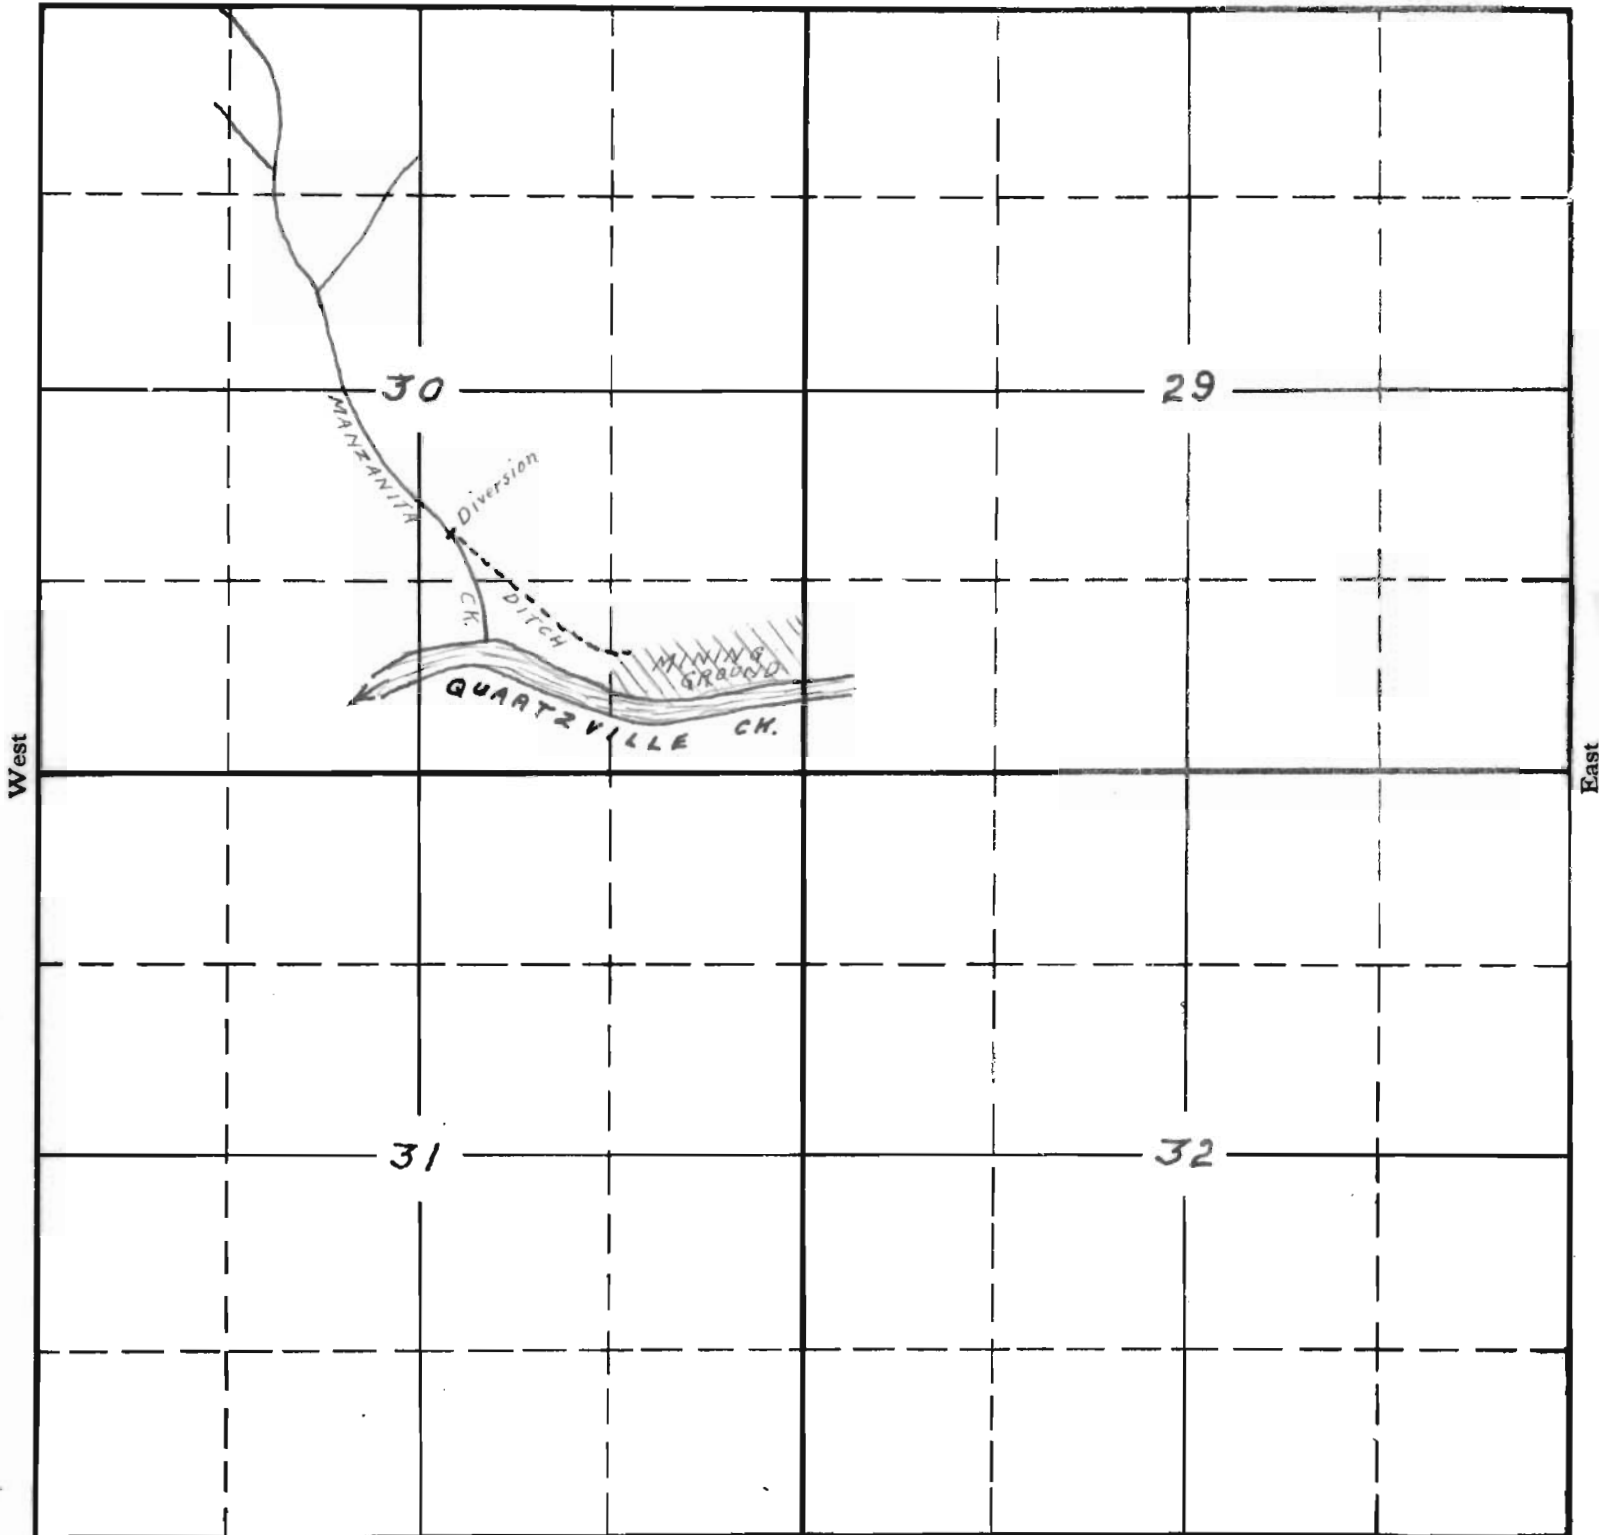


South

APPLICATION No. 15676
PERMIT No. 11540

.TION

TOWNSHIP 125, RANGE 3E, W. M.

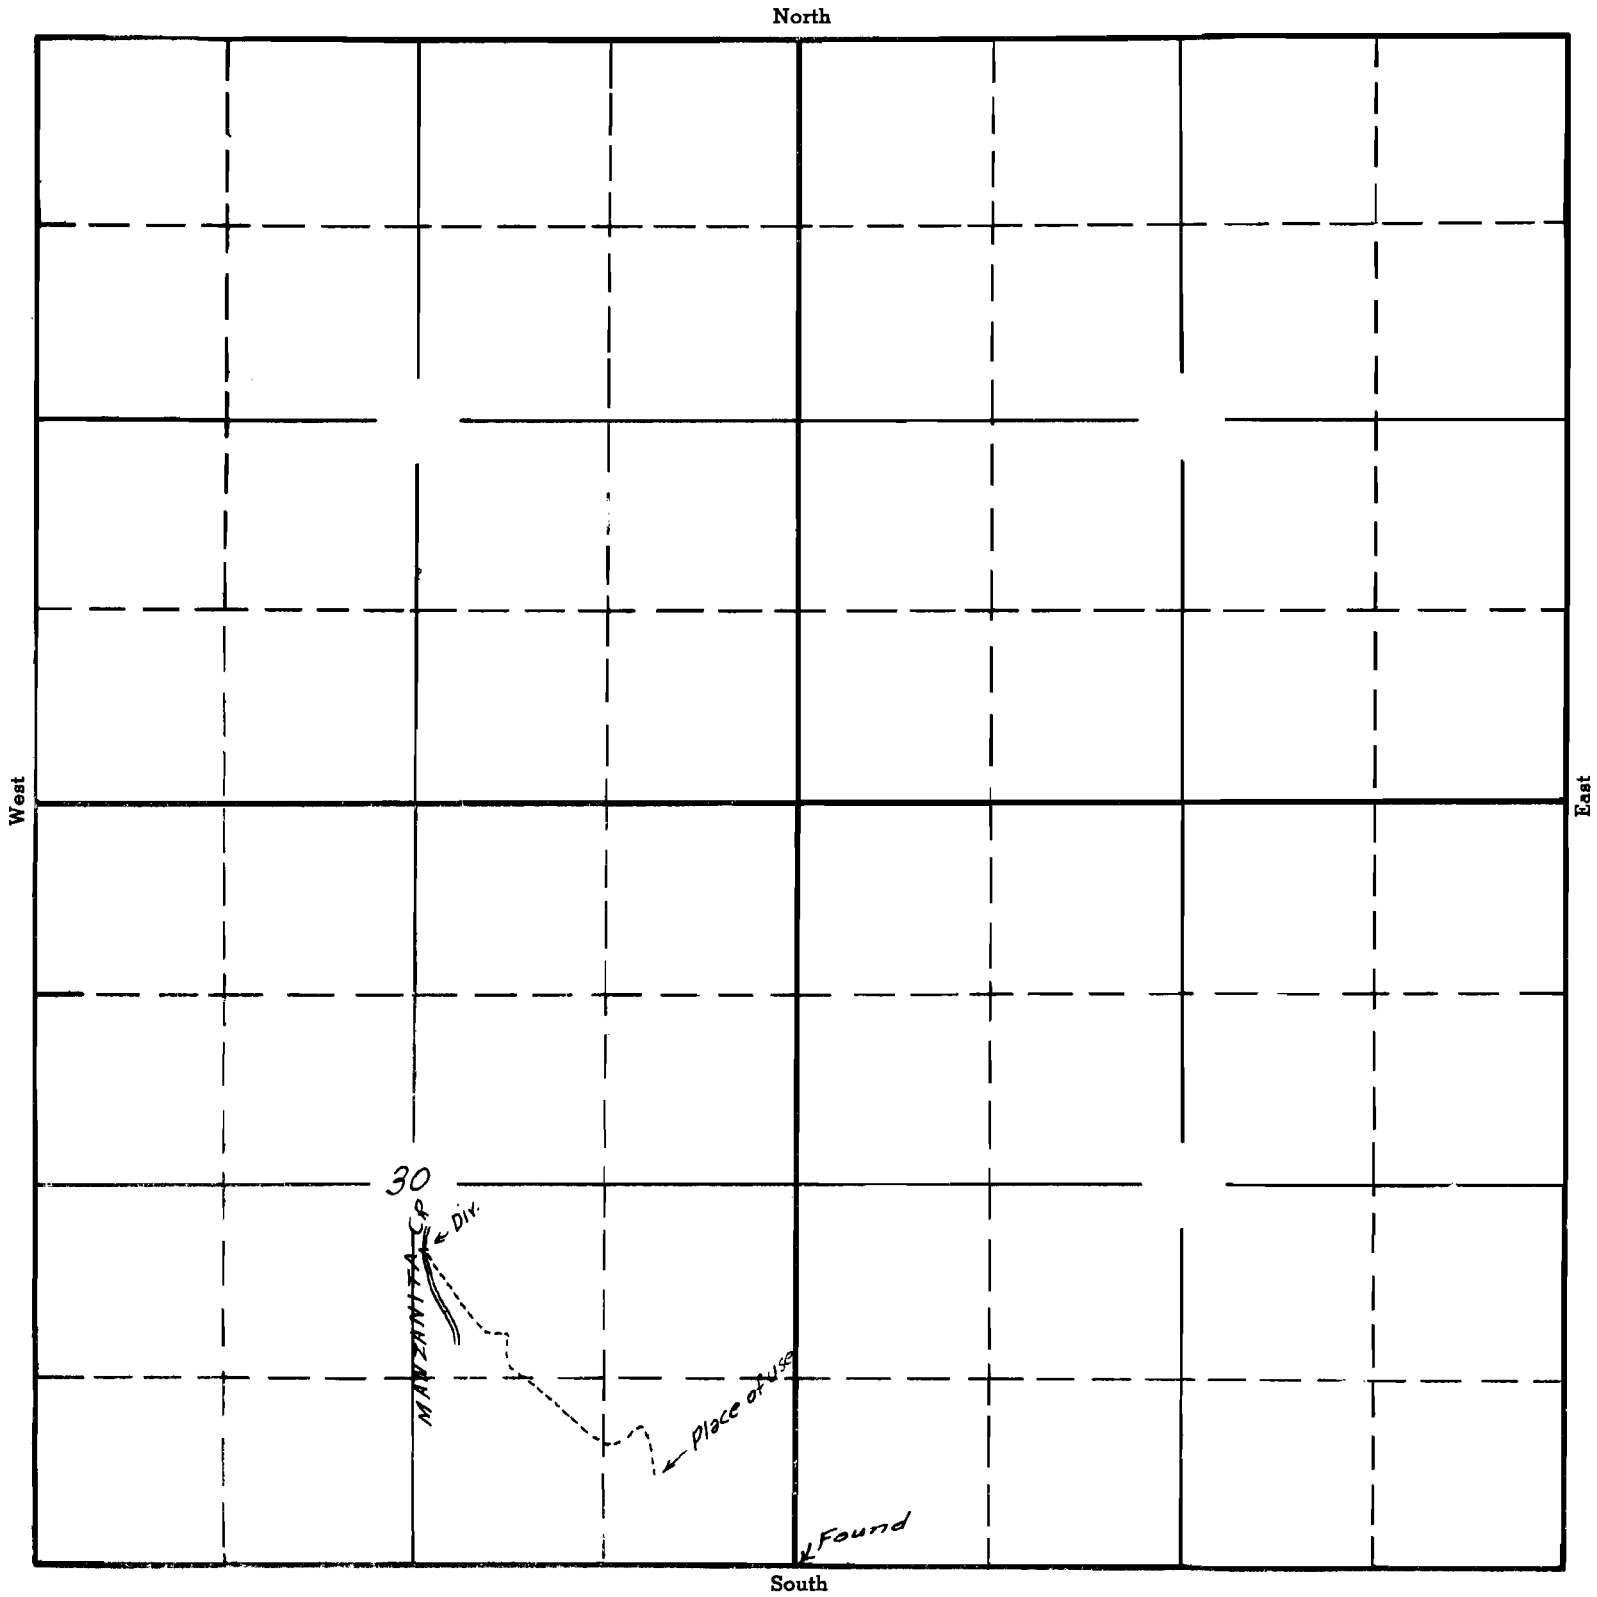

APPLICATION No. 15676
PERMIT No. 11540