


SECTION

TOWNSHIP 36 S, 37 S, RANGE 3 N, W. M.

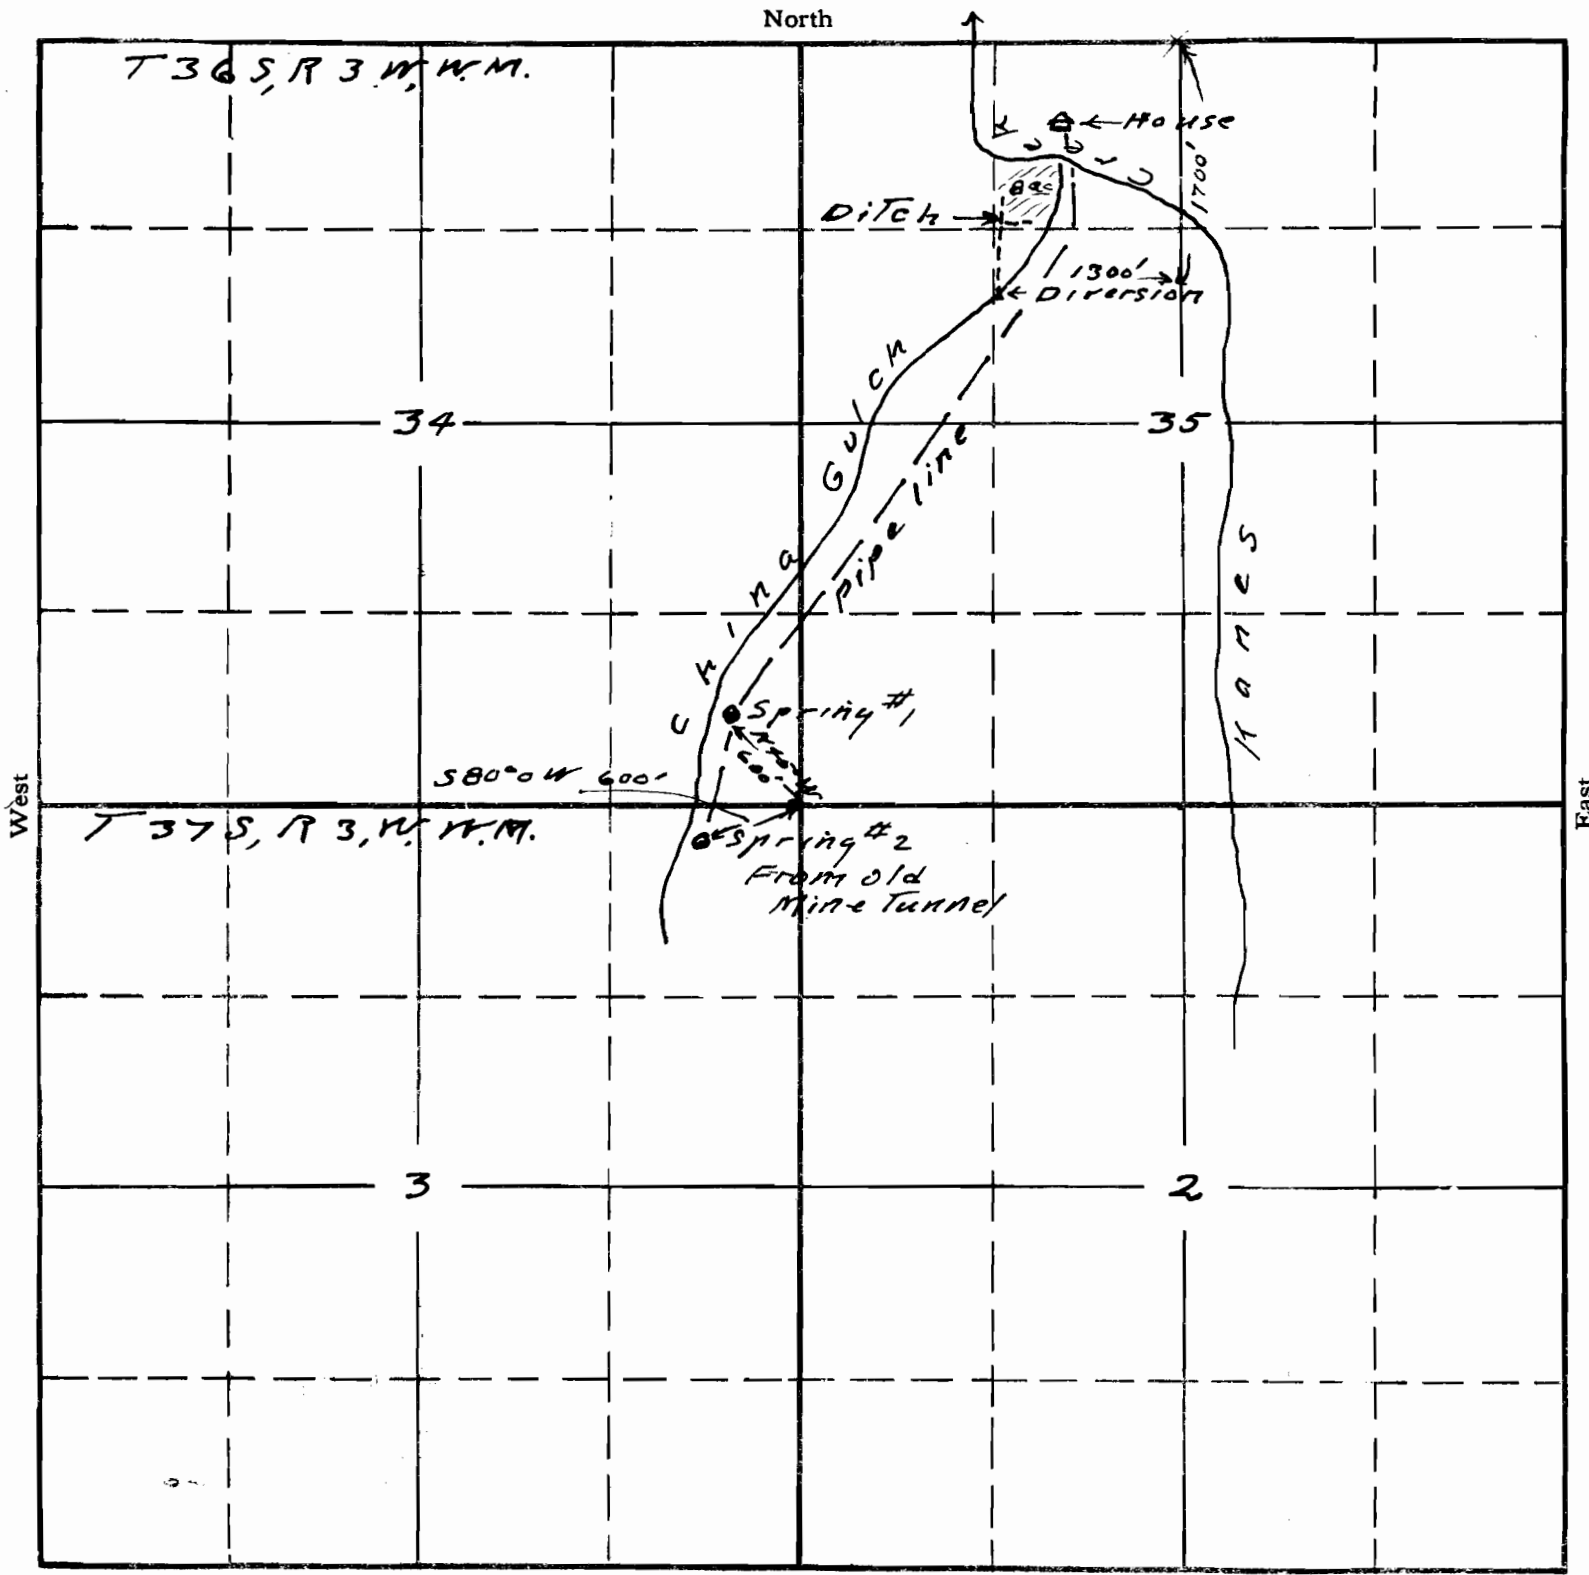

Map to accompany application of Josephine E & James N Cornutt APPLICATION No. 15647 for domestic stock and irrigation PERMIT No. 11549