

SECTION

32


33

TOWNSHIP 30 S, RANGE 5 W, W. M.

North

West

East

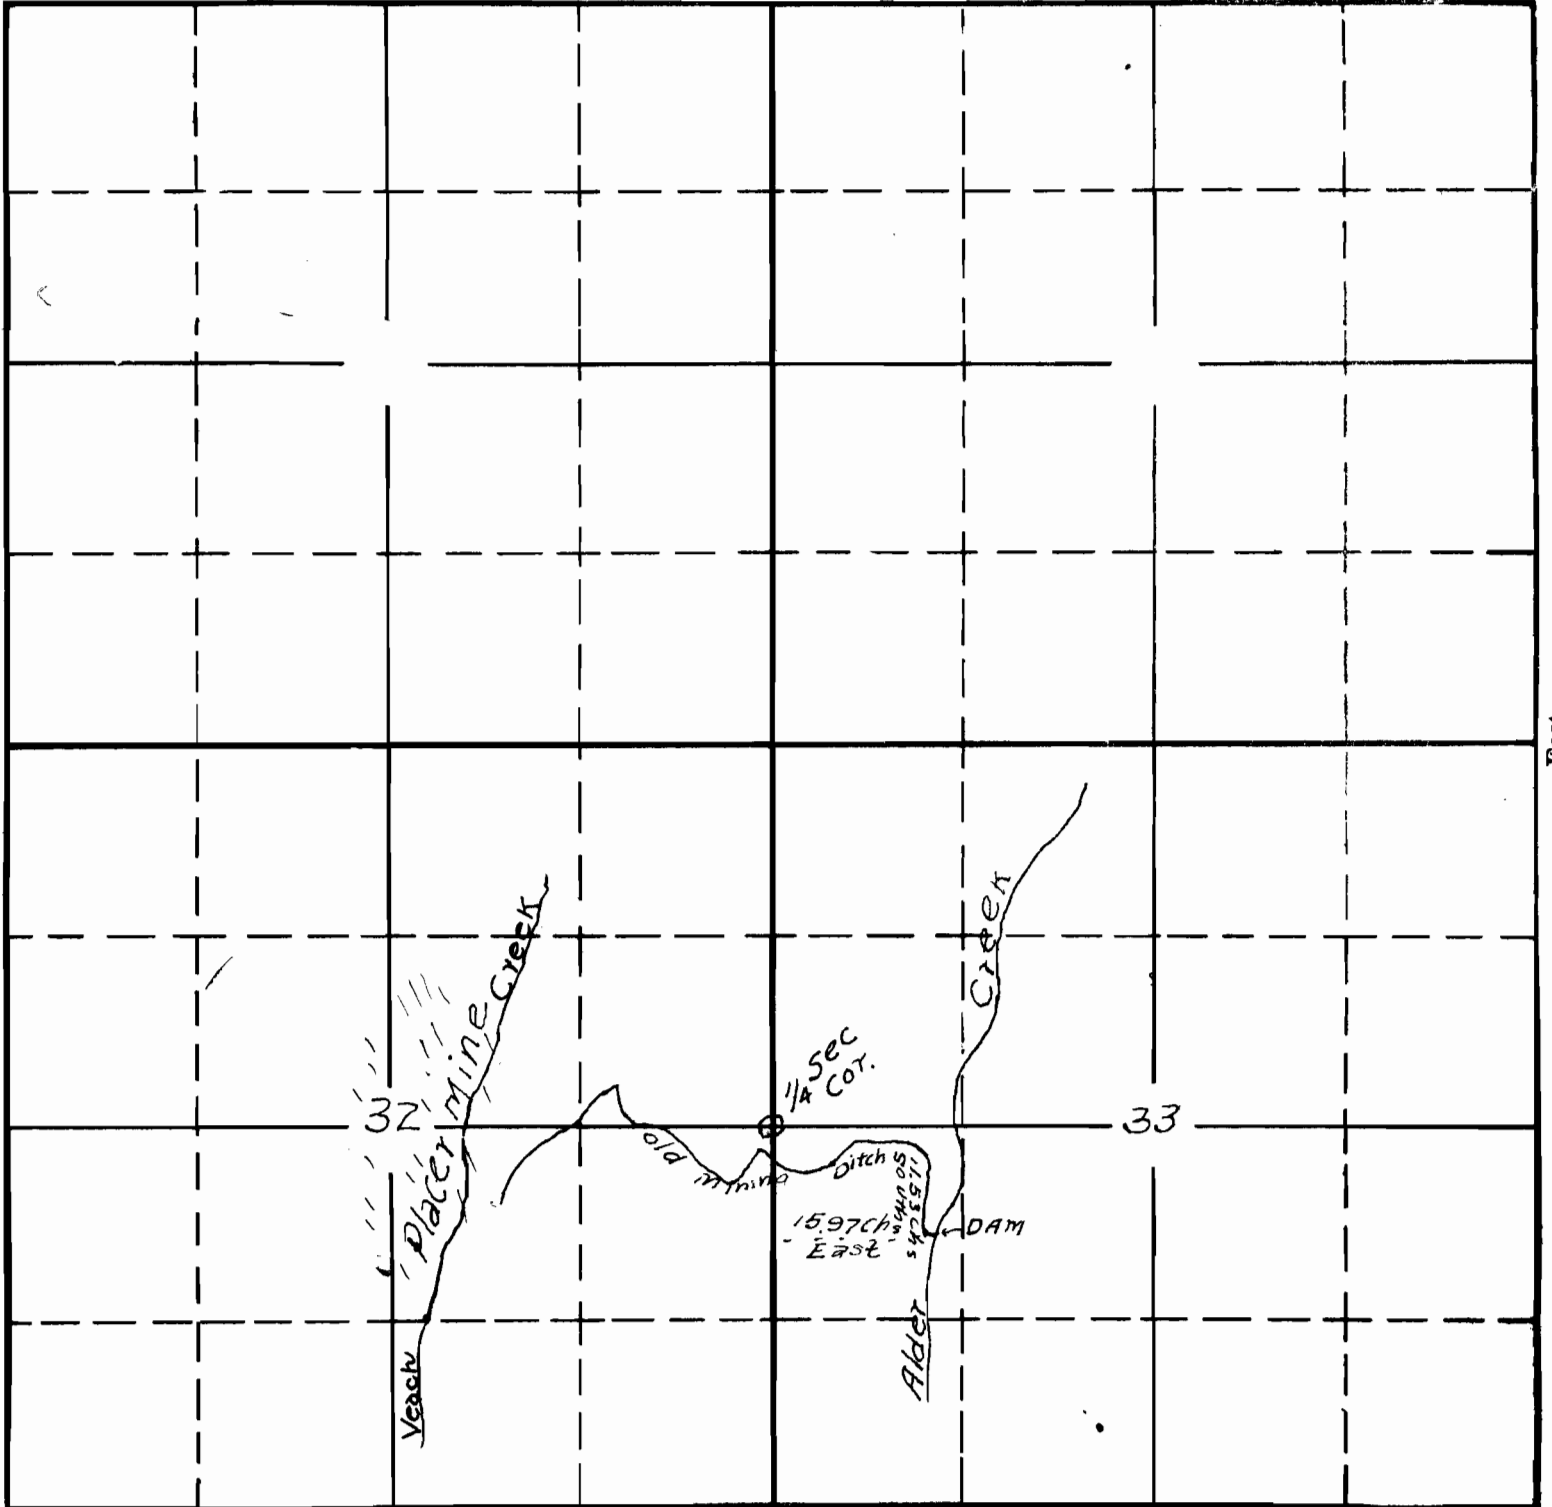

South

APPLICATION No. 15669
PERMIT No. 11553