


SECTION

TOWNSHIP 9S, RANGE 2E, W. M.

North

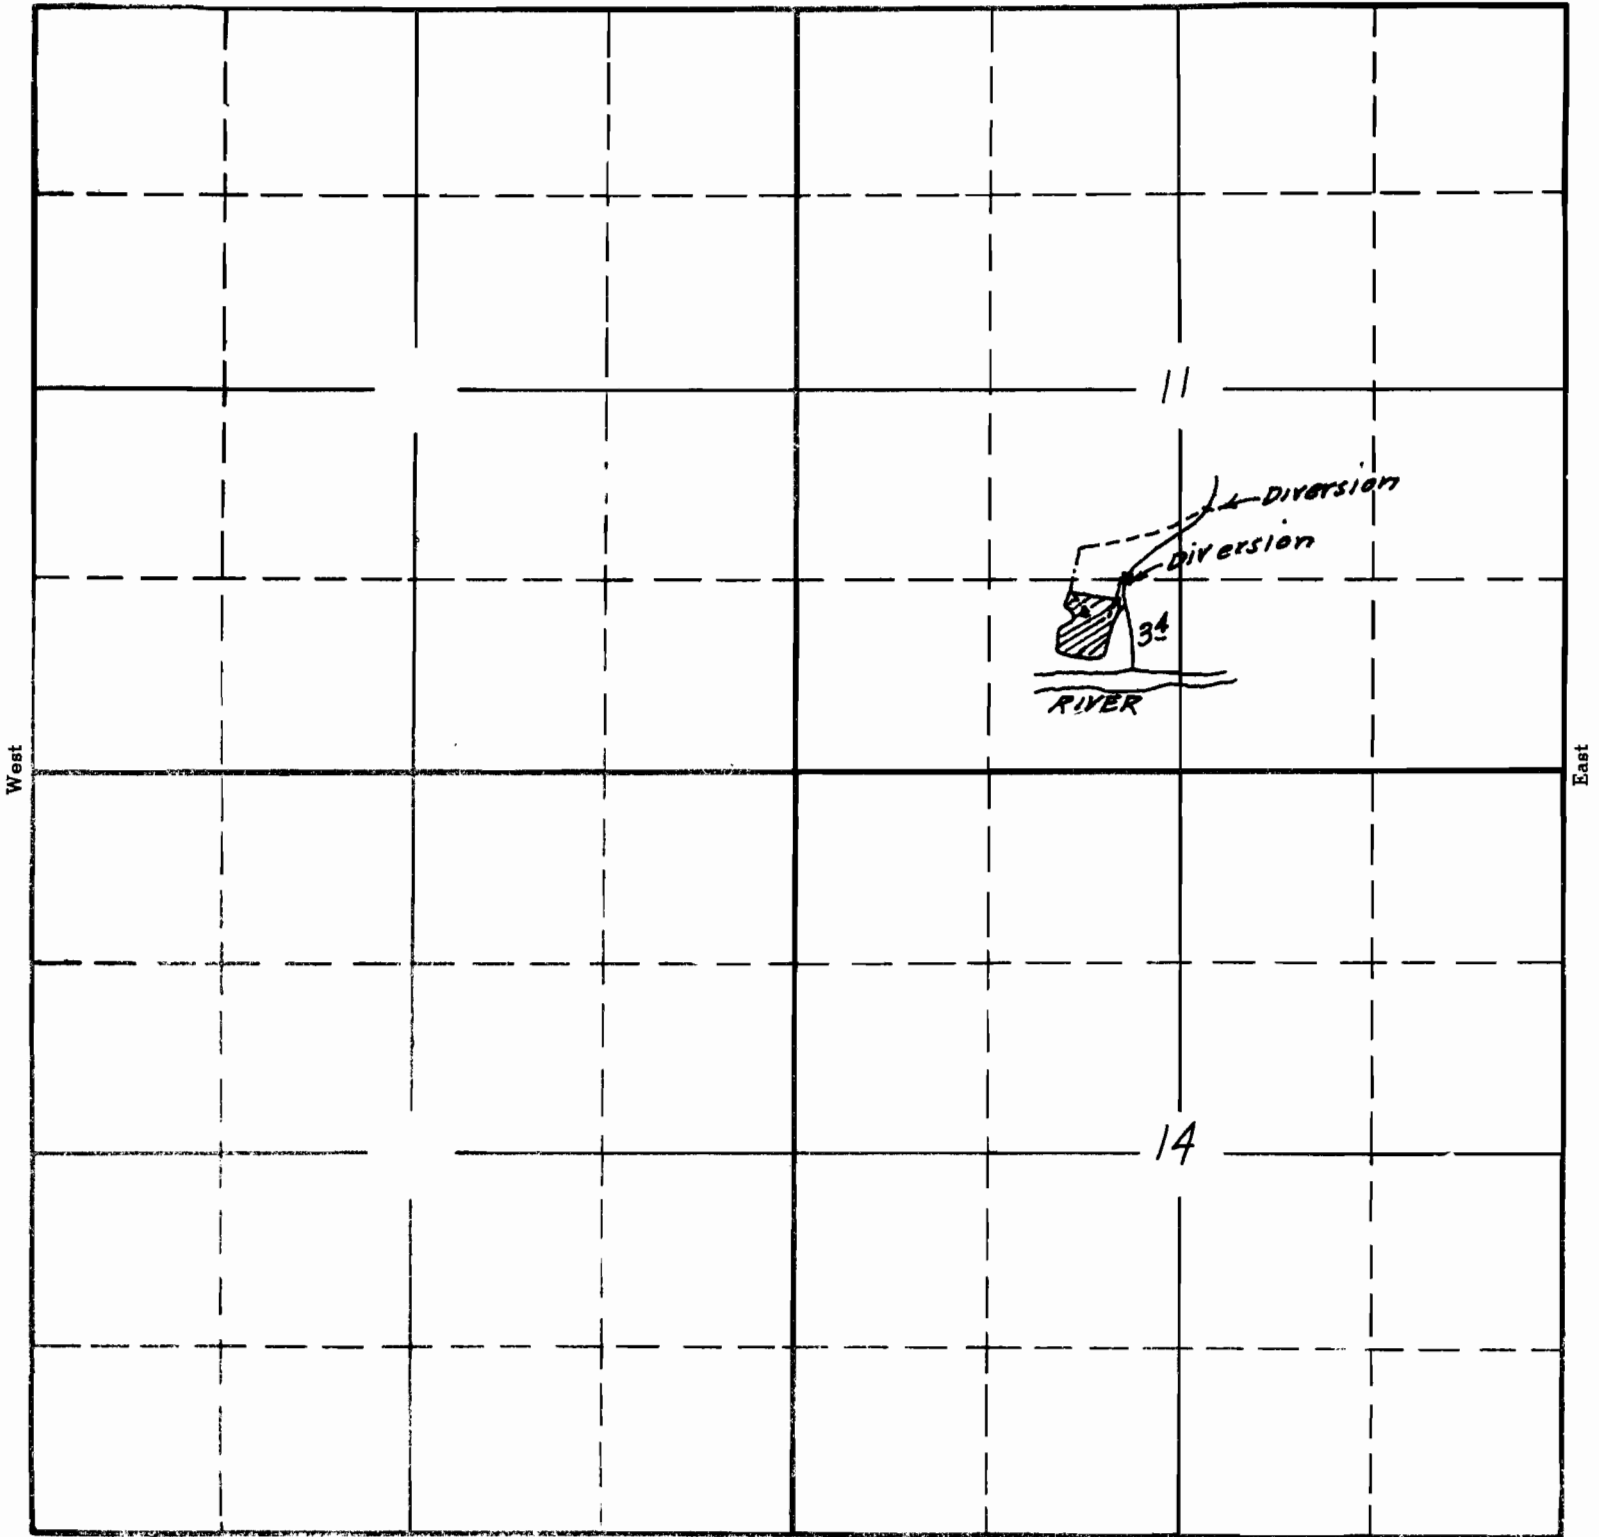


South

APPLICATION No. 15701
PERMIT No. 11567

SECTION

TOWNSHIP 9 S., RANGE 2 E., W. M.

North

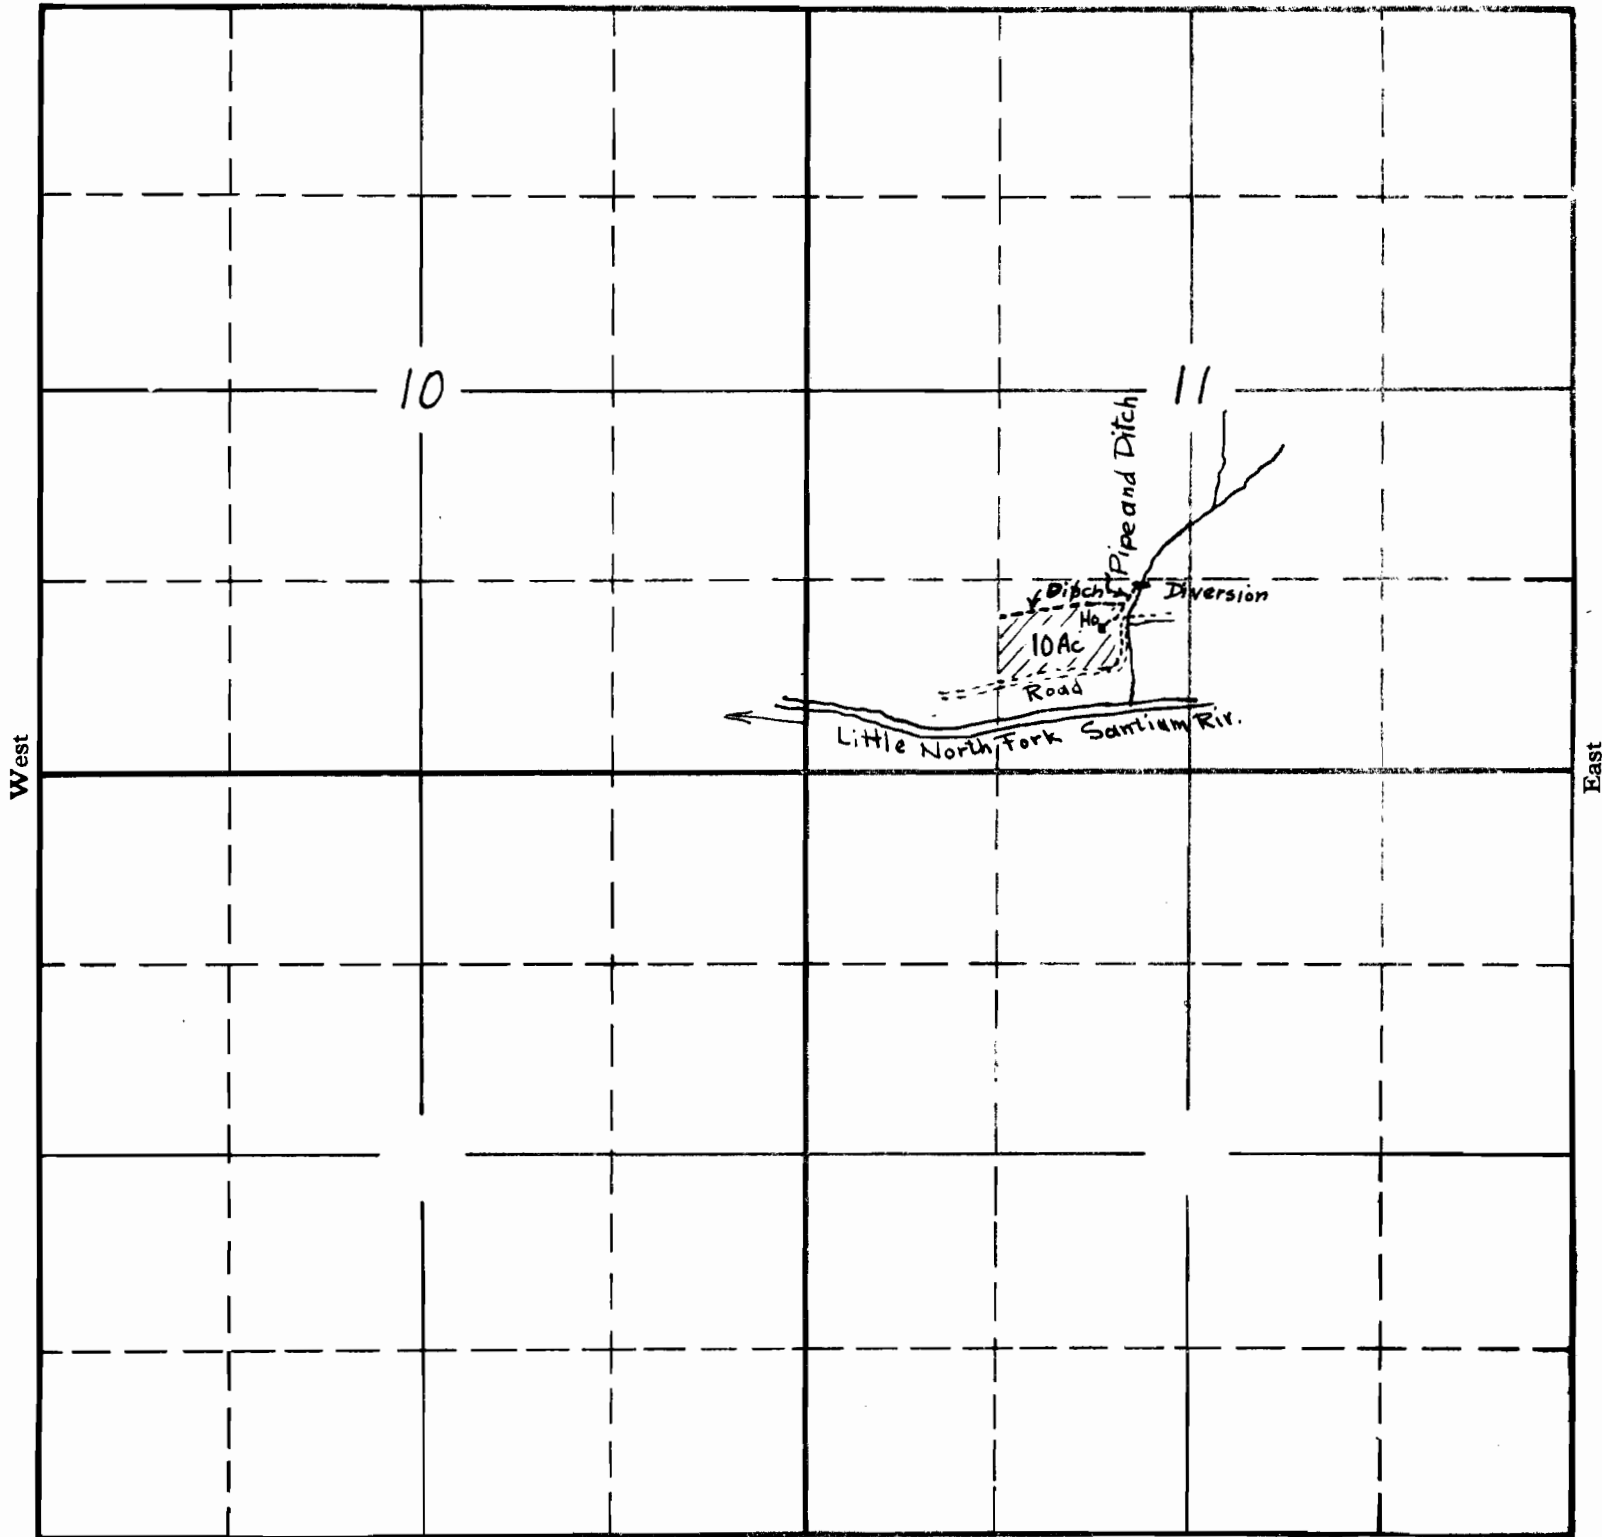

South

APPLICATION No. 15701

PERMIT No. 11567