


SECTION

31

TOWNSHIP 20S, RANGE 2W, W. M.

North

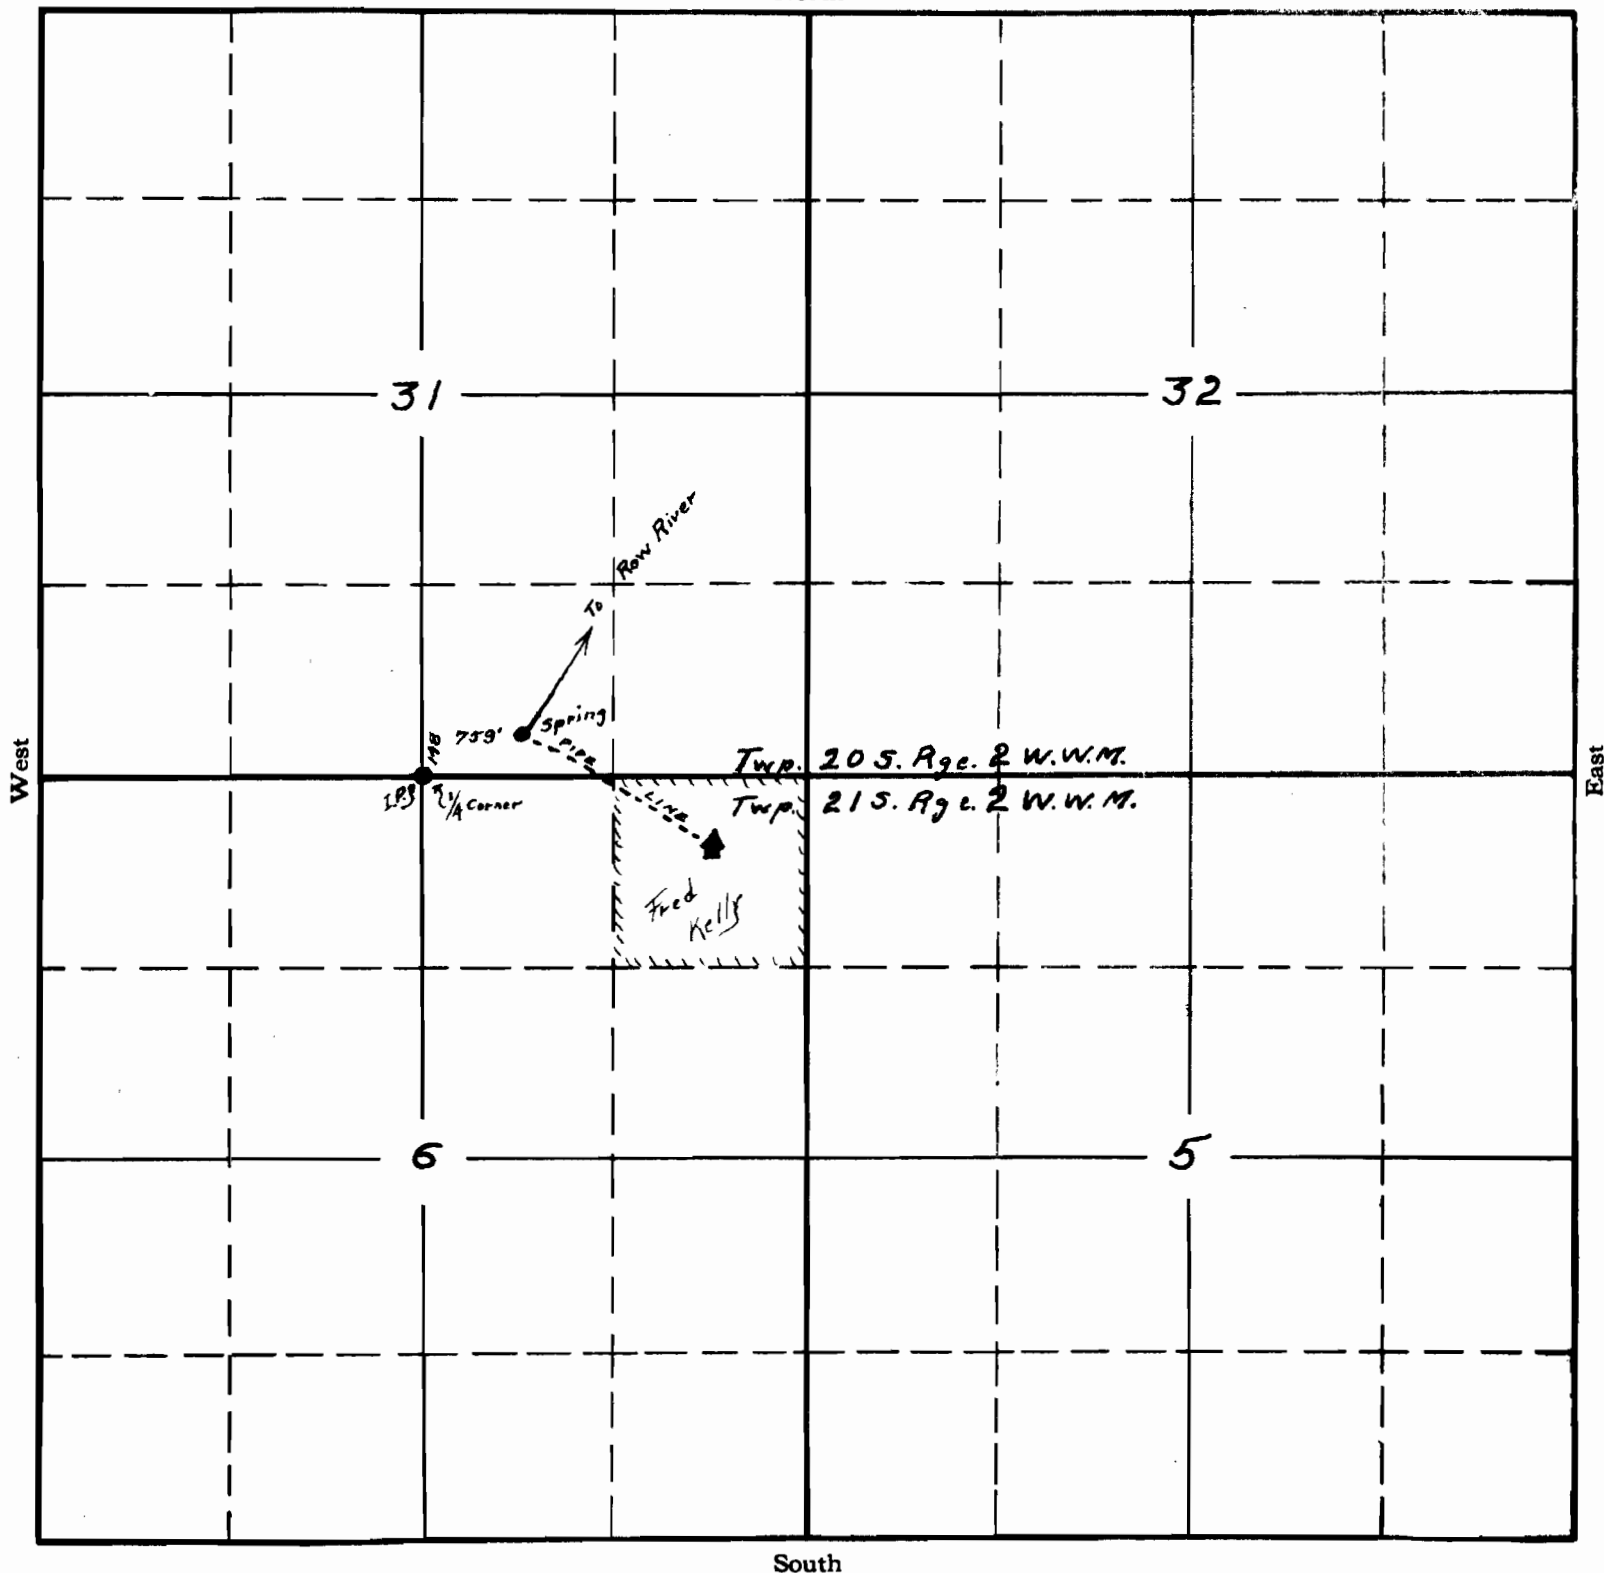

South

APPLICATION No. 15726

PERMIT No. 11584