


SCALE: 20, Chains to the inch

TOWNSHIP Eleven, South, Range Four West OF THE Will. MEY. OYE.

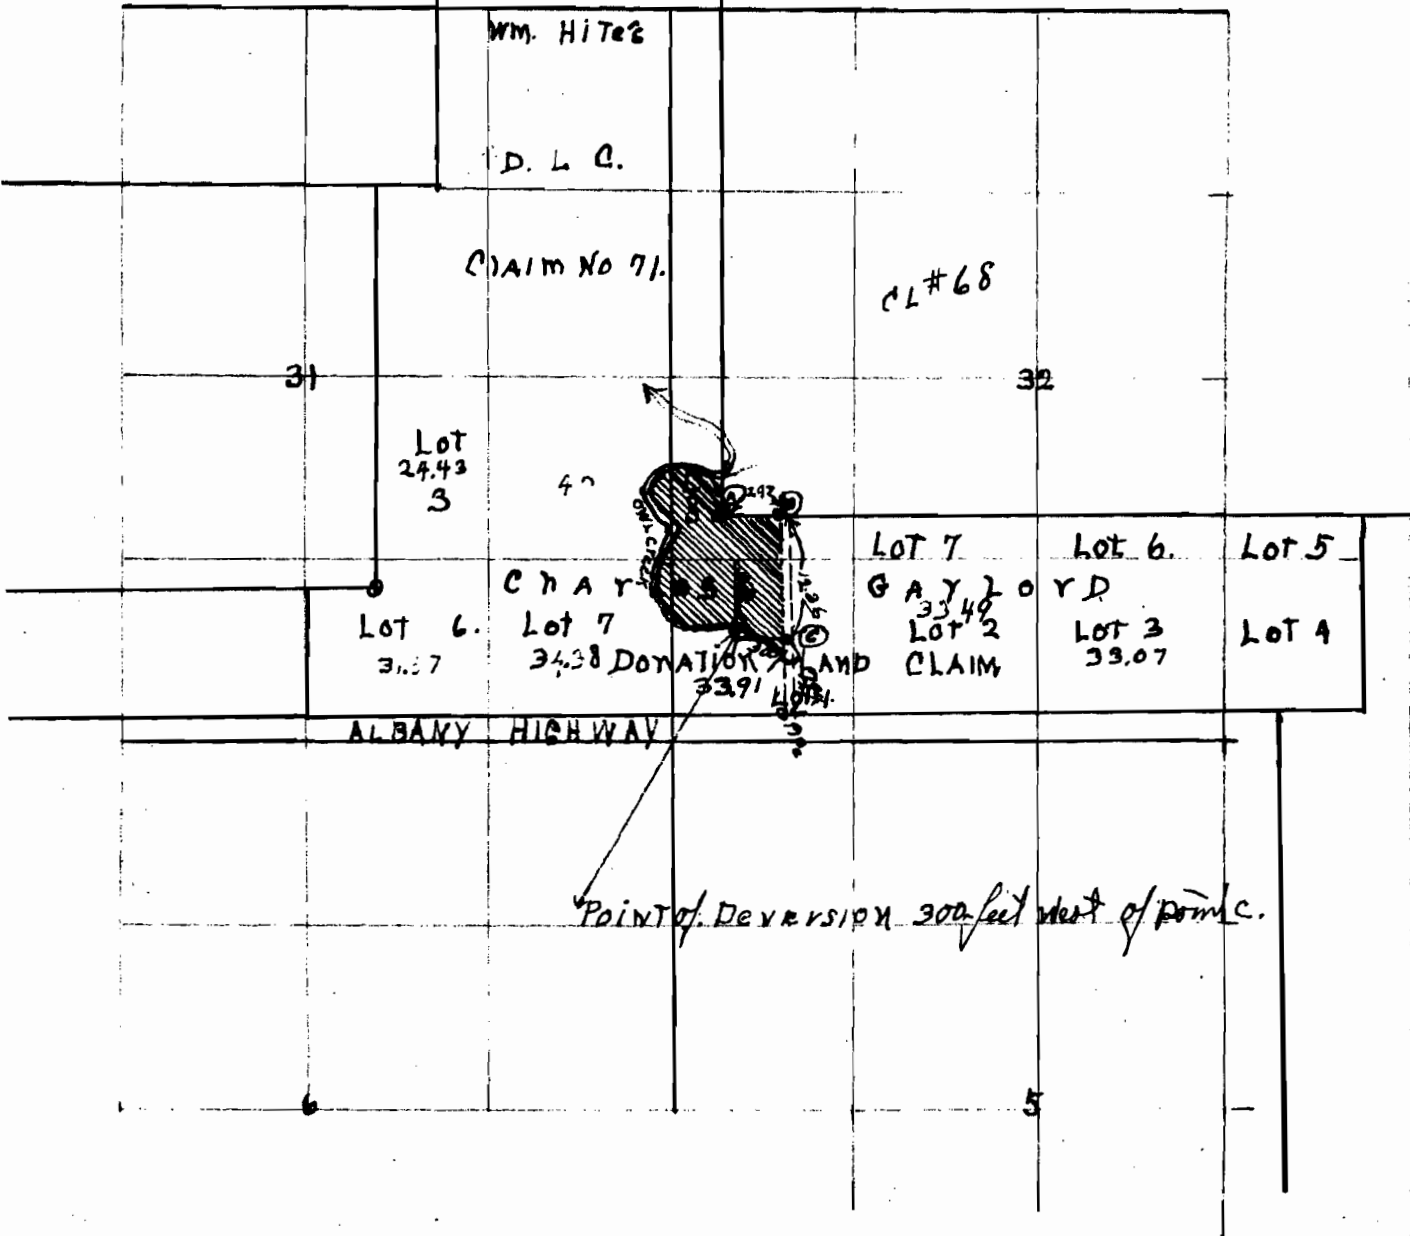

REGISTERED
 B. M. 7. 6
 1887

App. No. 15729
 Per No. 11595