


SECTION

TOWNSHIP 34S, RANGE 4W, W. M.

North

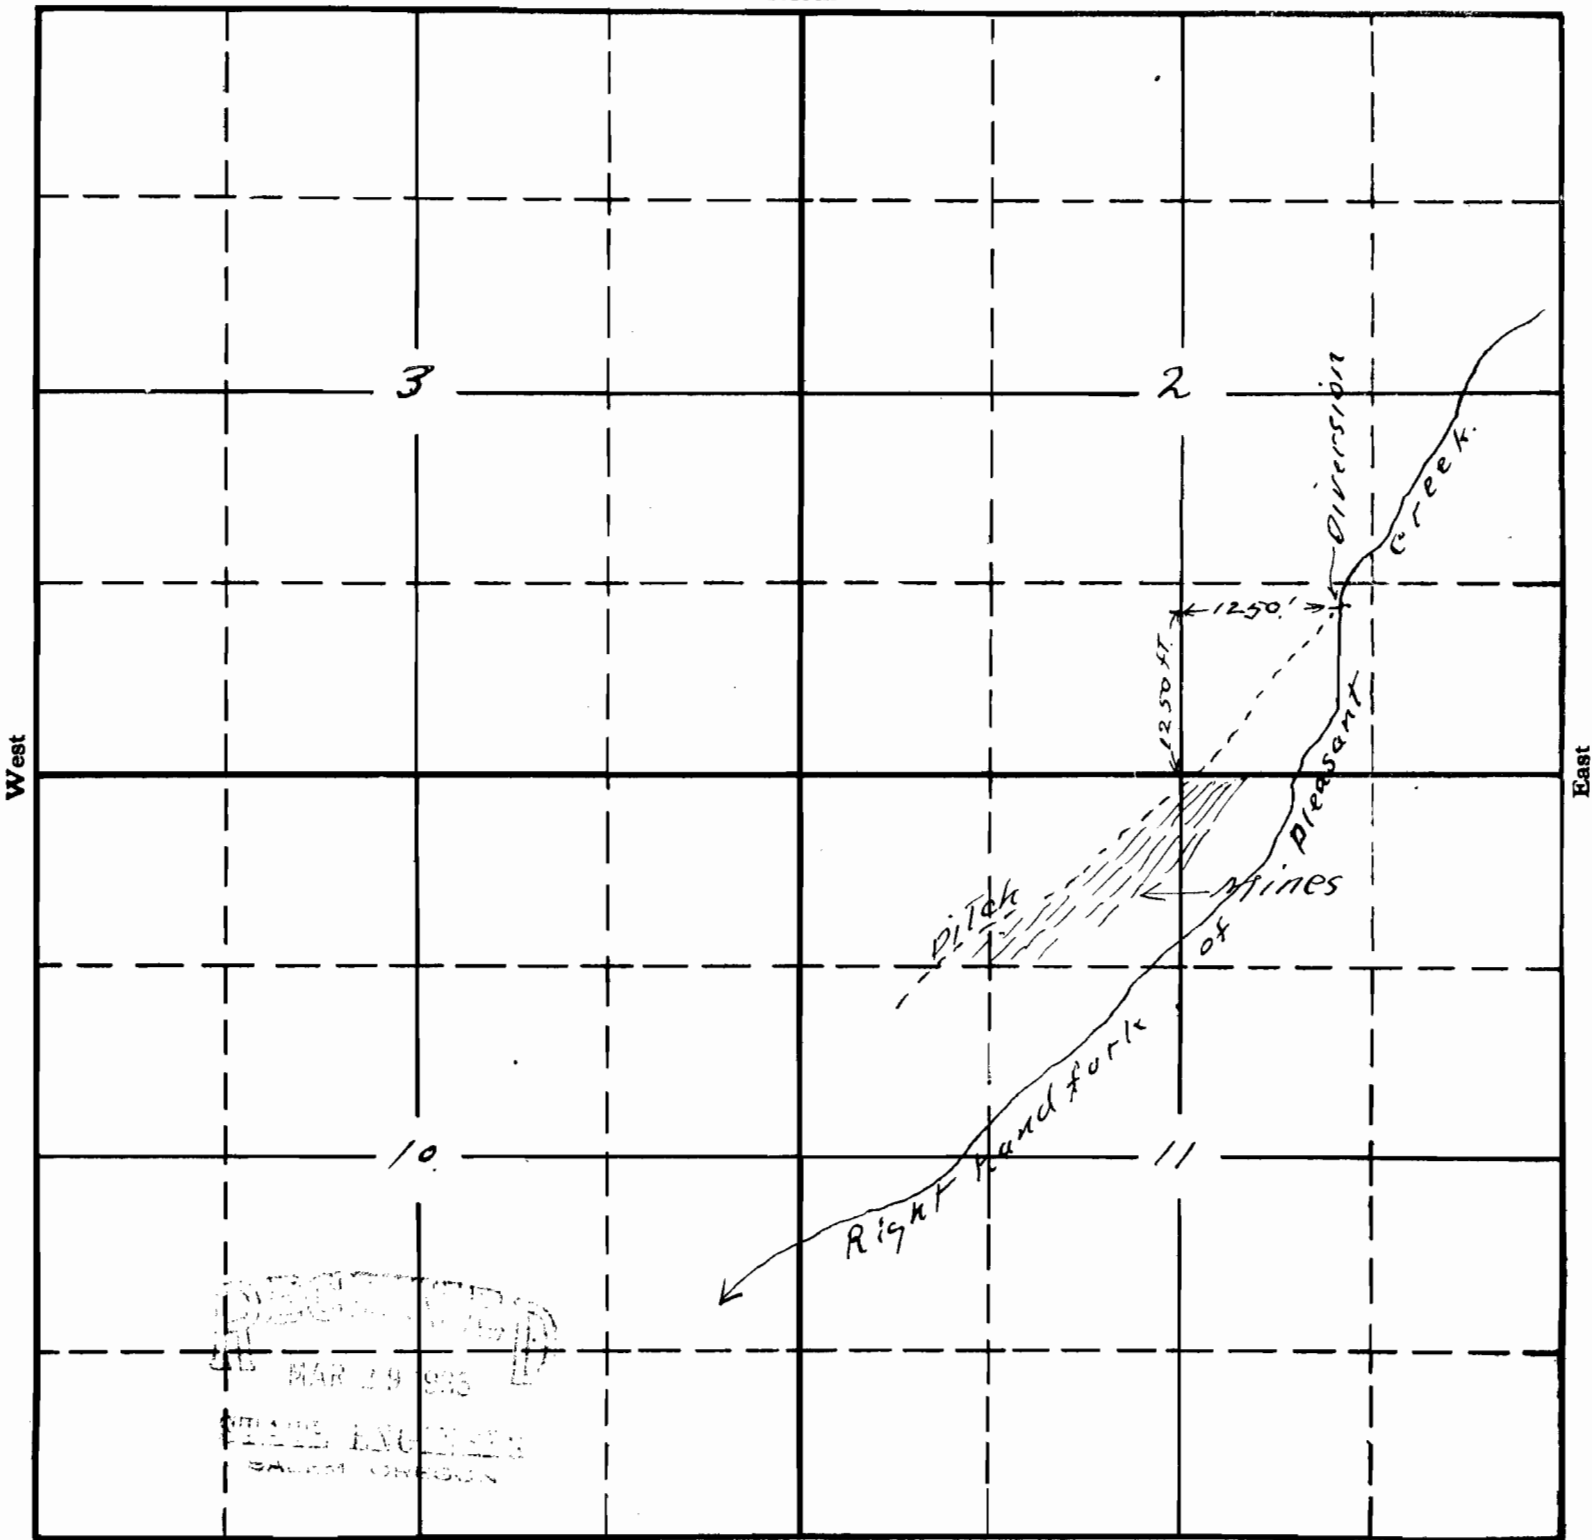

RECEIVED  
 26 MAR 29 1905  
 STATE ENGINEER  
 SALEM OREGON

South

Map To accompany application of  
 H. O. Douglas for the use of the  
 waters of Right hand fork of Pleasant Cr.  
 for mining purposes and domestic

APPLICATION No. 15768

PERMIT No. 11620