


SECTION

TOWNSHIP 34 S, RANGE 7 W., W. M.

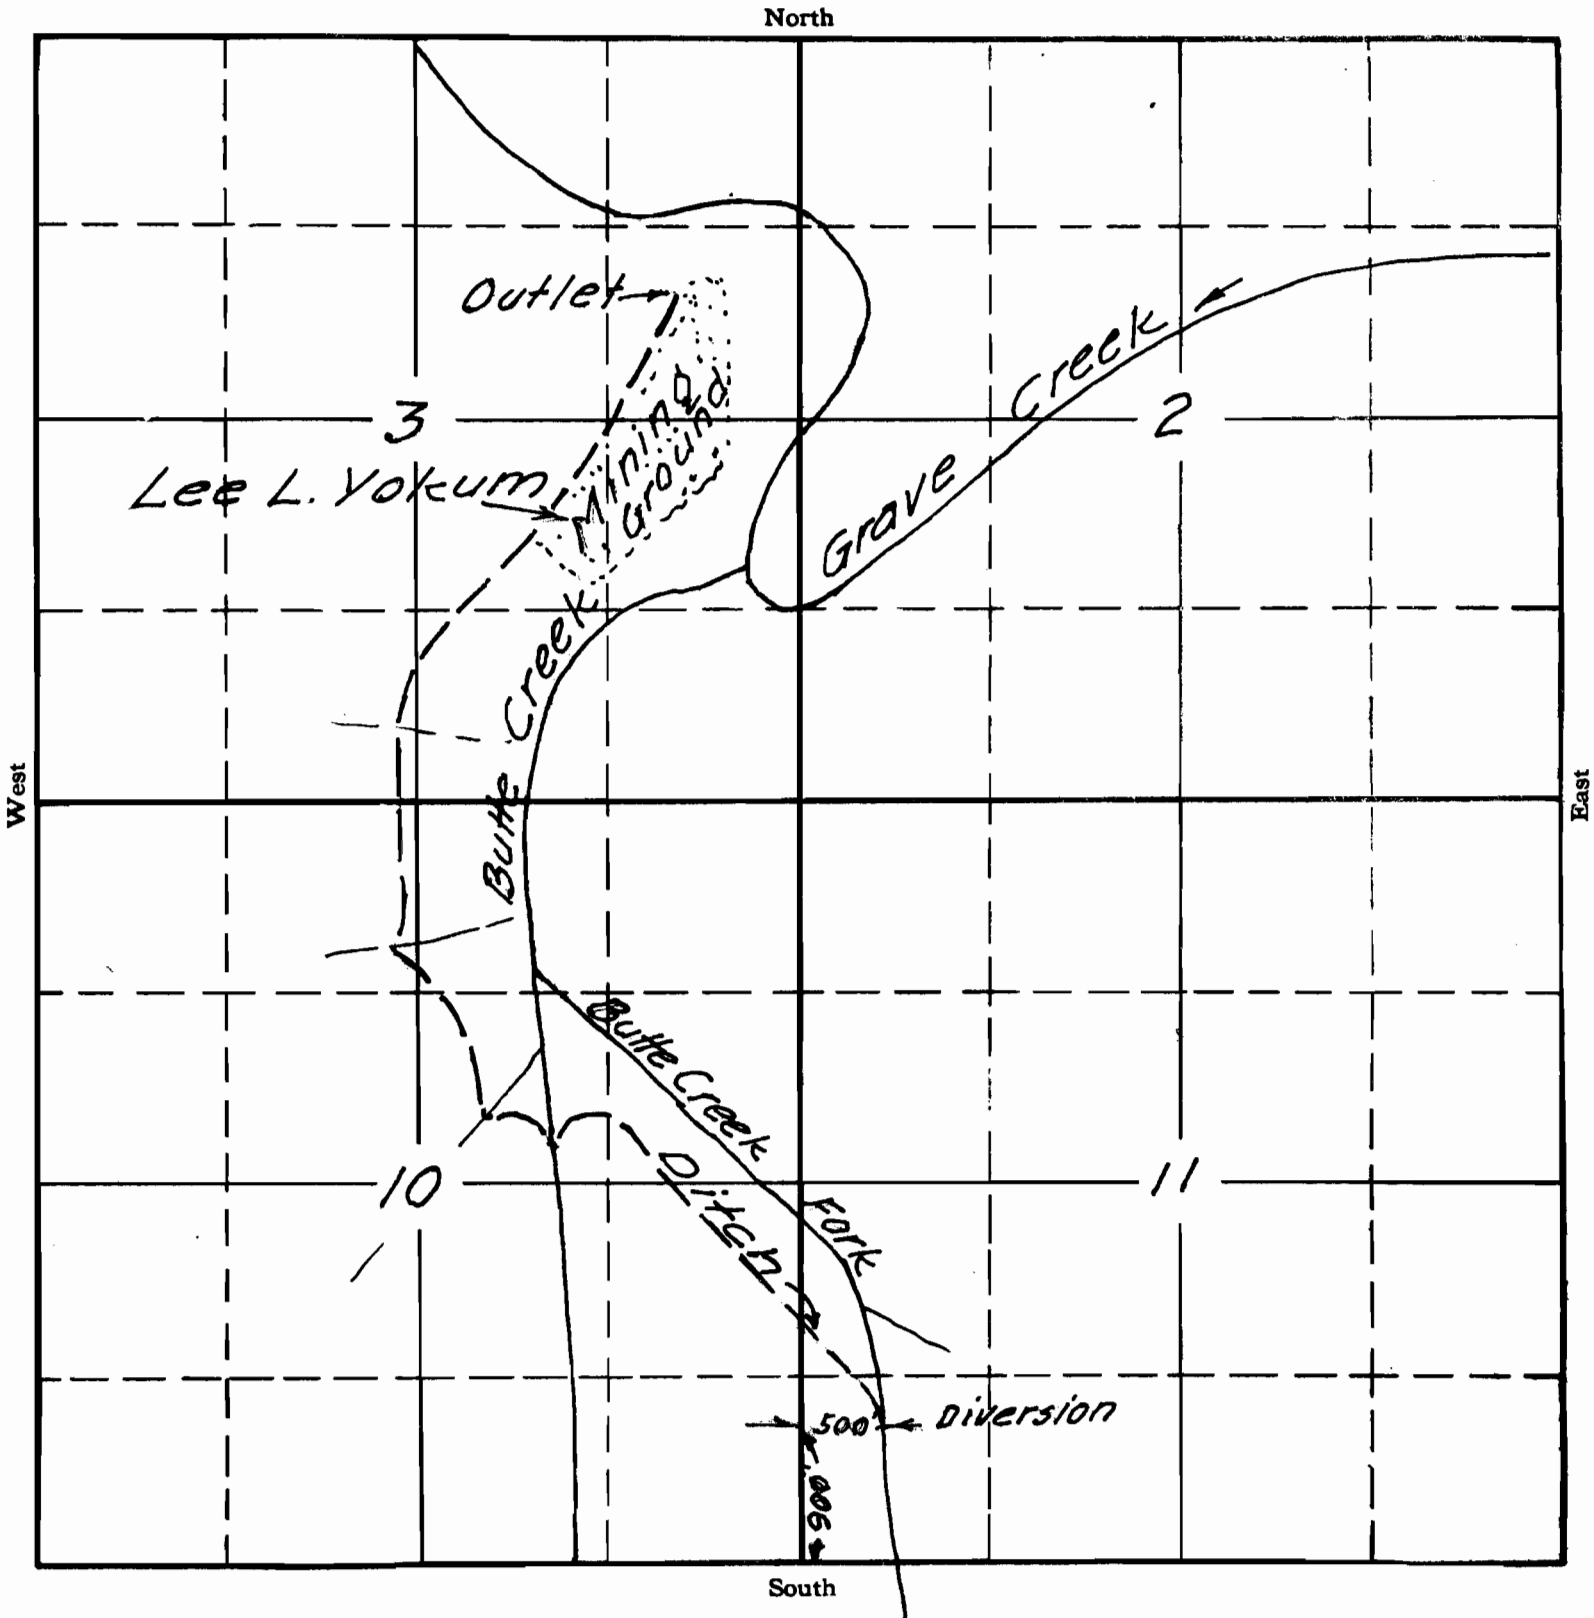

APPLICATION No. 15812

PERMIT No. 11655