


TAFT-NELSCOTT-DELAKE WATER DISTRICT
 Map Showing General Layout of Proposed
GRAVITY WATER SUPPLY
 Located in
 LINCOLN COUNTY OREGON
 Scale 1"=1000' - Cuppen, Cooper, & Branson-Engrs. March 14, 1935

Chairman - F.C. Robison
 Secretary - R.E. Collins

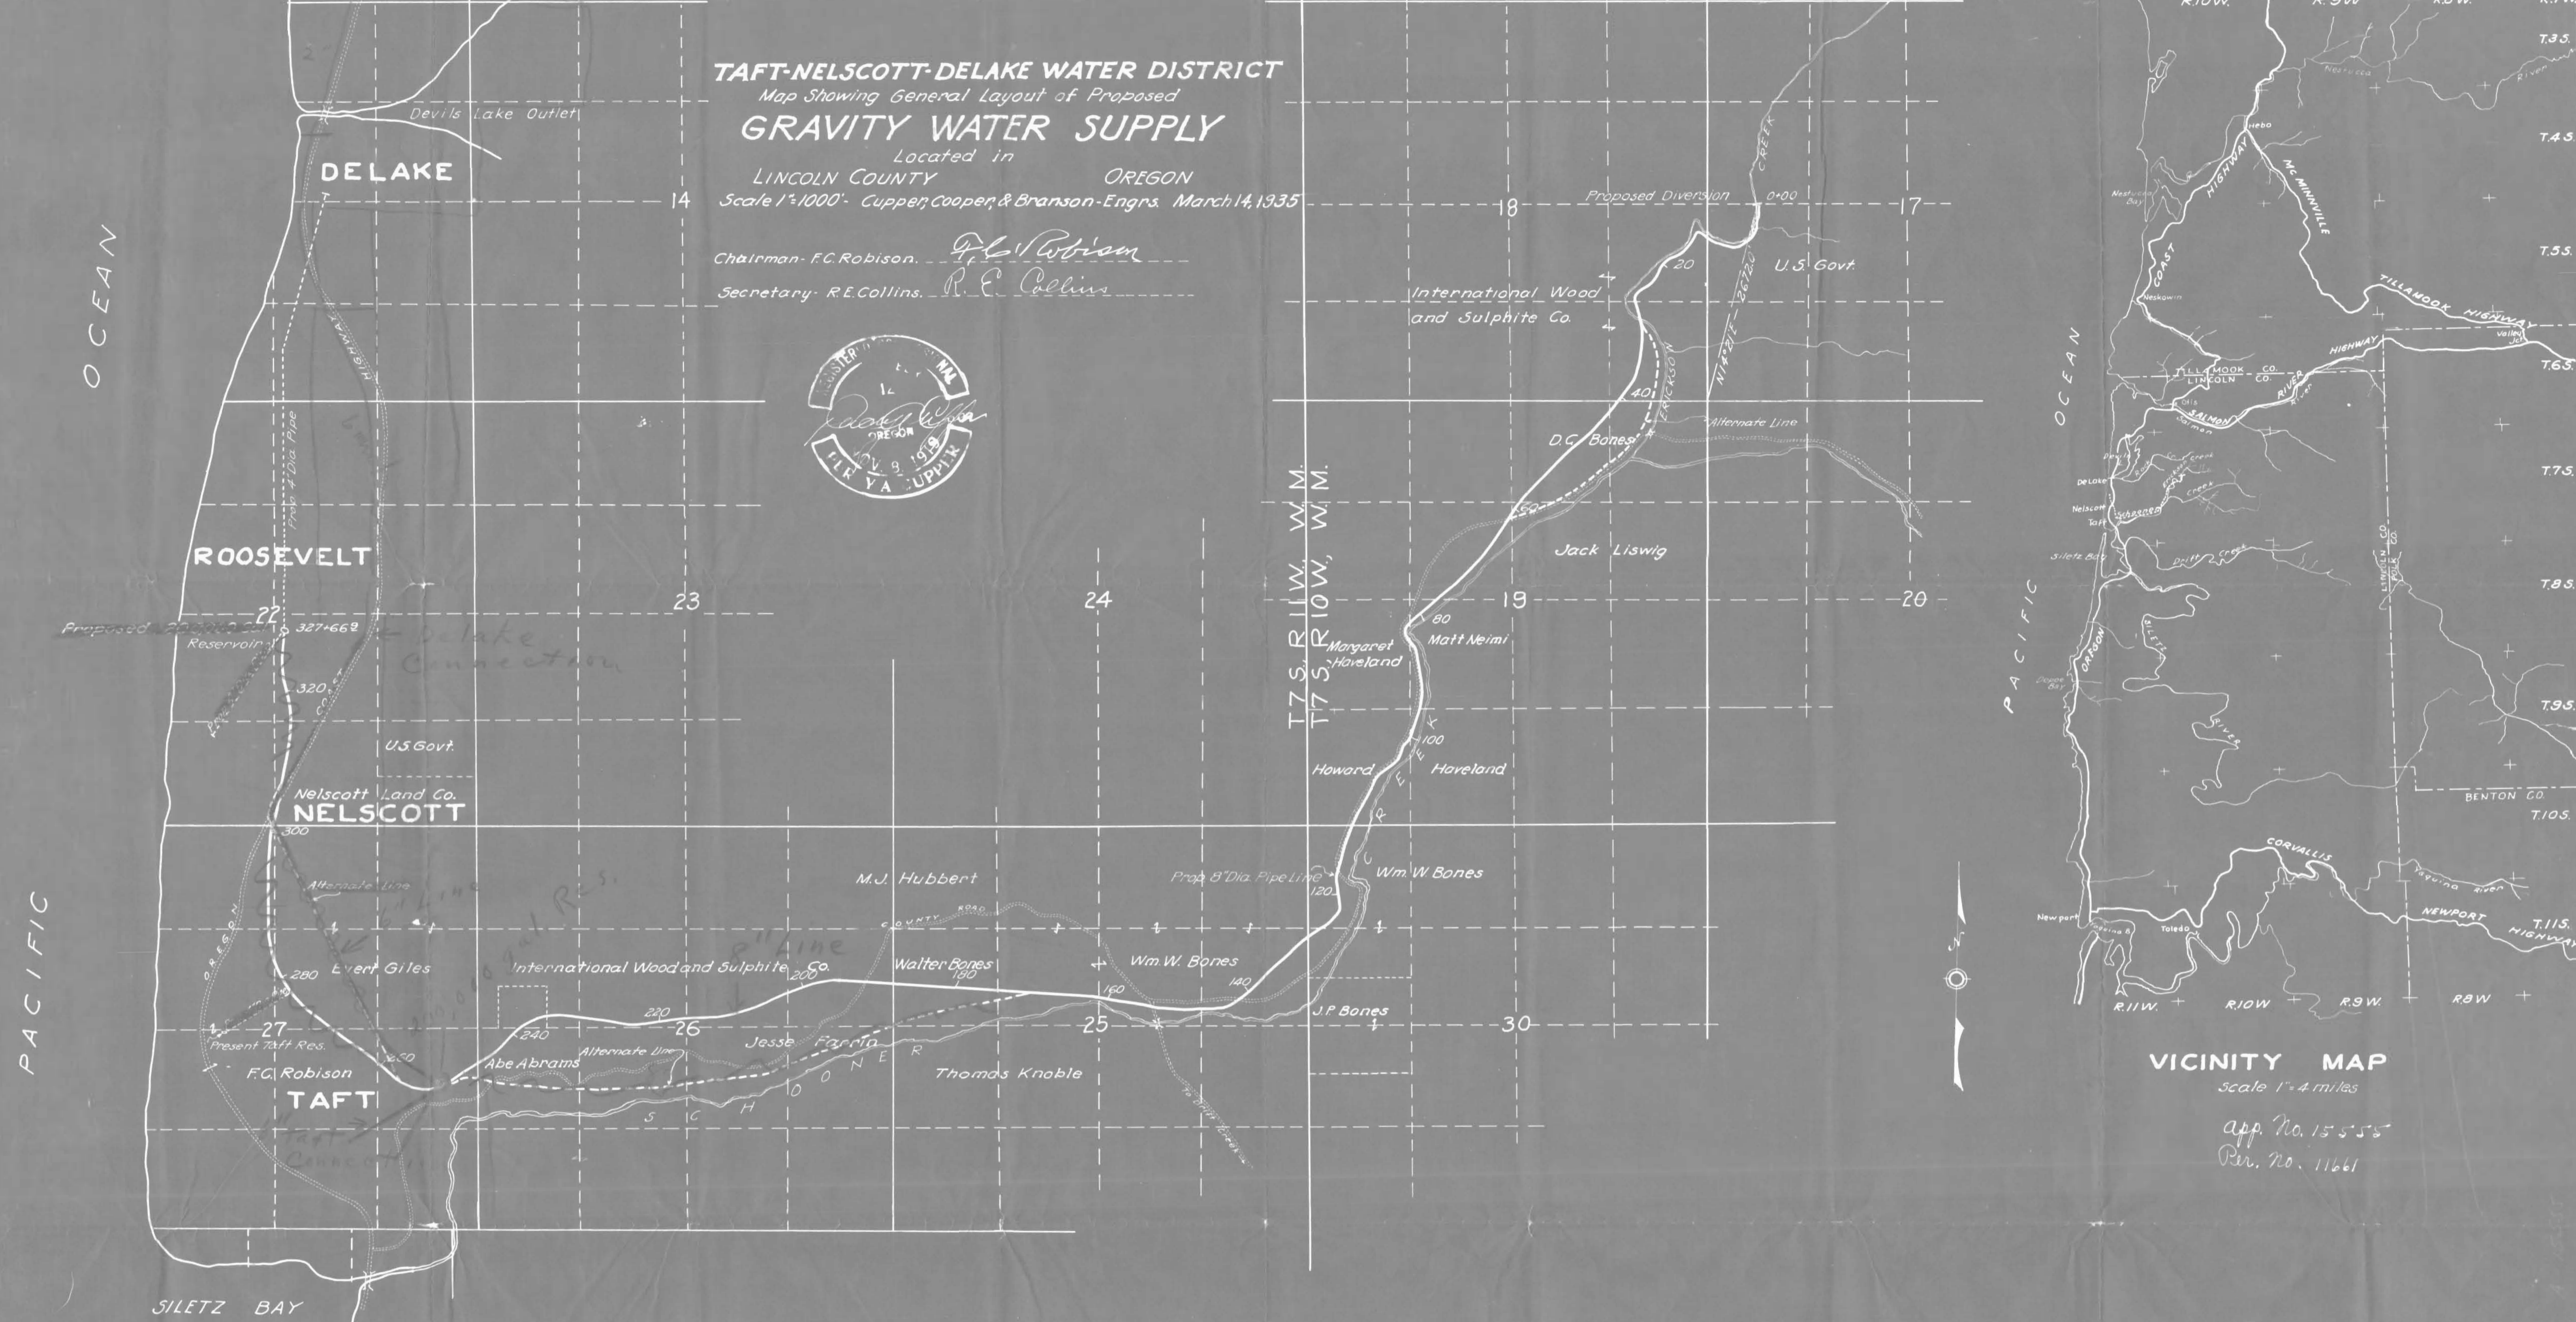

VICINITY MAP
 Scale 1"=4 miles
 app. No. 15555
 Per. No. 11661

