


SECTION

15

TOWNSHIP 15, RANGE 2E, W. M.


North

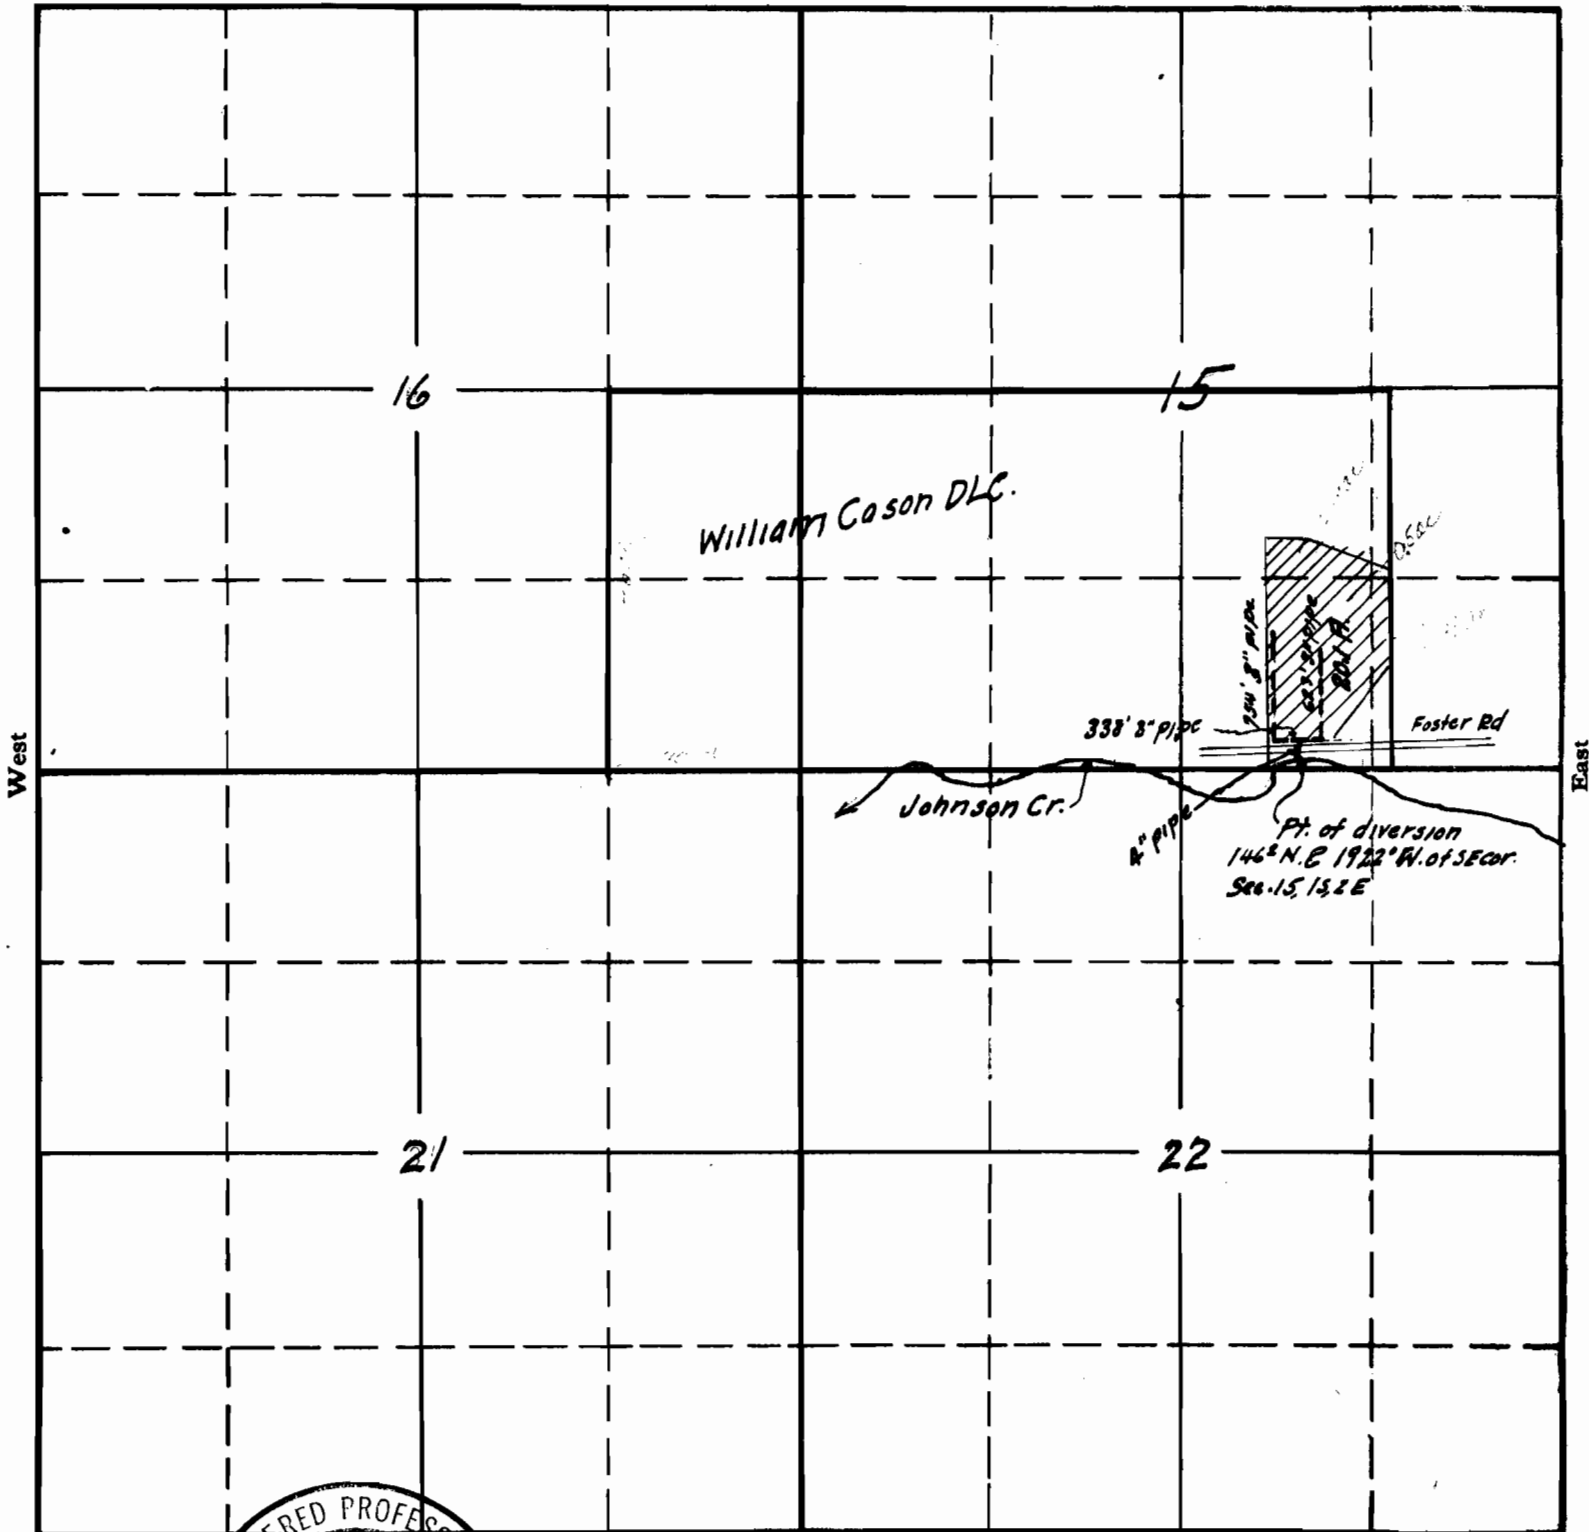

West

East

South

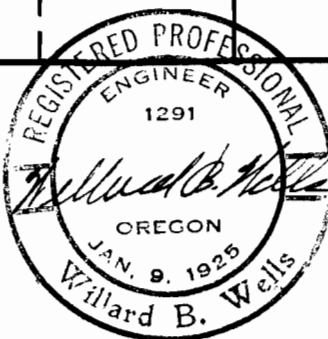

APPLICATION No. 15793
 PERMIT No. 11670