


SECTION

TOWNSHIP 25, RANGE 2E, W. M.

North

West

East

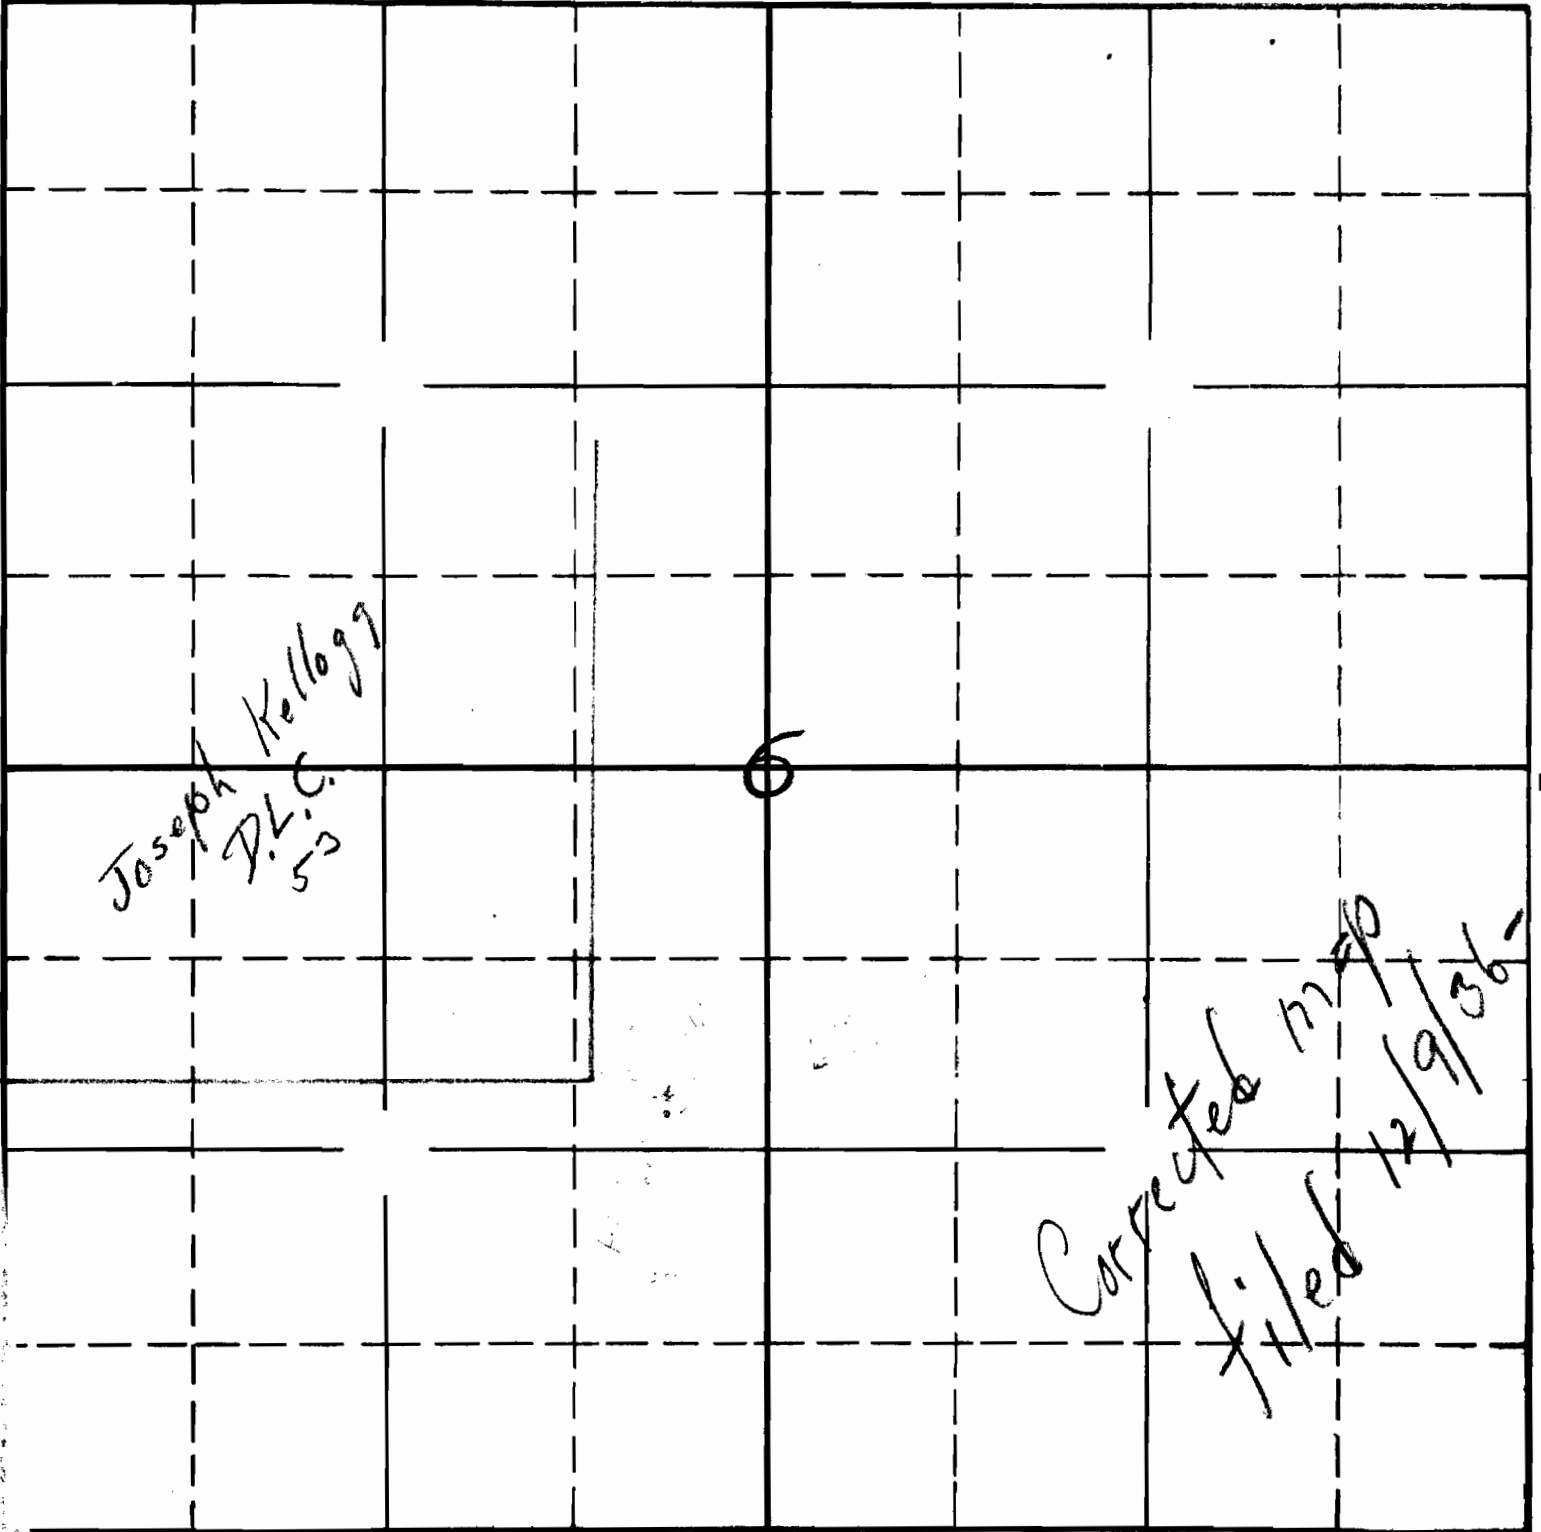

South

15827

APPLICATION No.

PERMIT No.

SECTION


6

TOWNSHIP 2 S, RANGE 2 E, W. M.

North

West

East

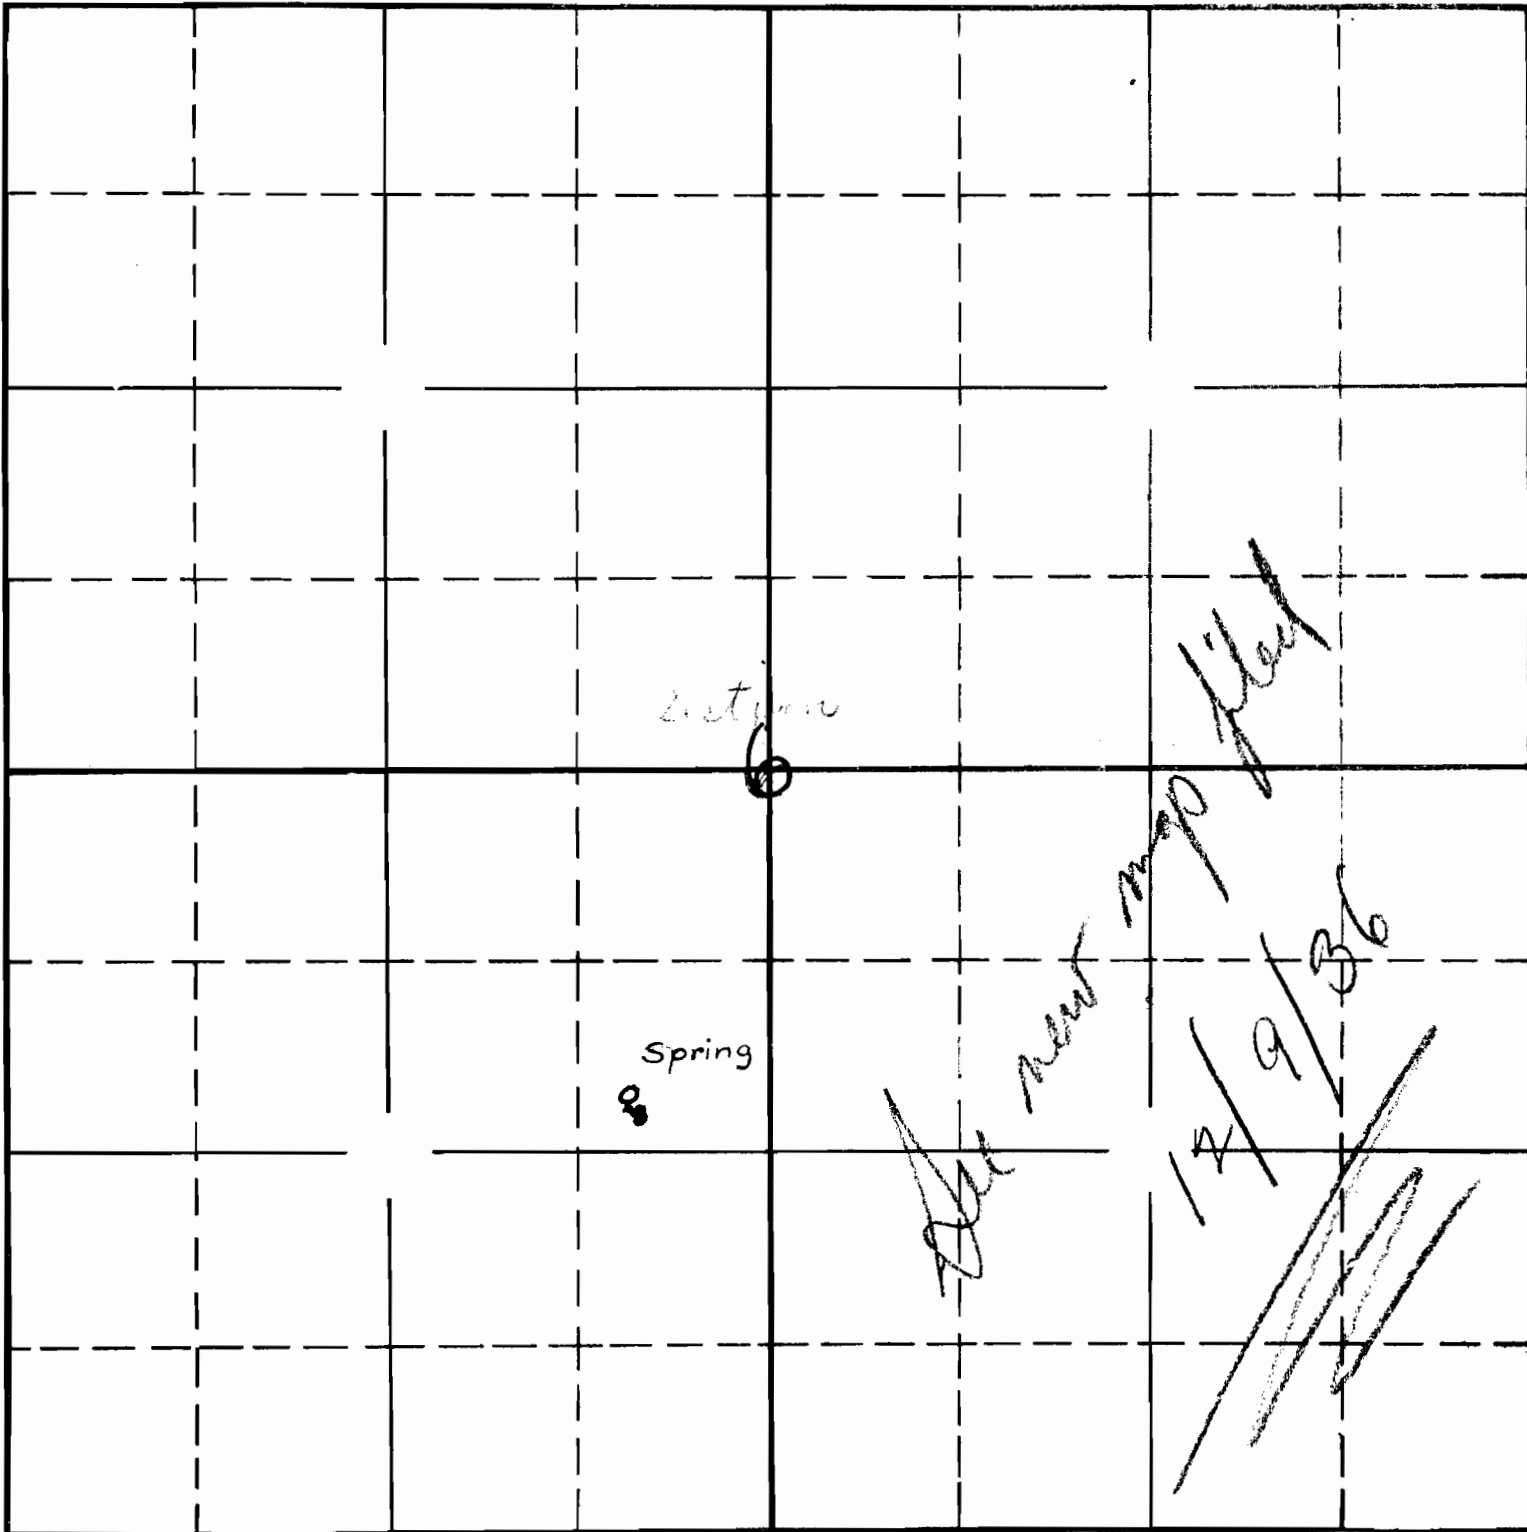

South



STATE ENGINEER

APPLICATION No. 15827

PERMIT No. 11681