


SECTION

9

TOWNSHIP 25, RANGE 1E, W. M.

North

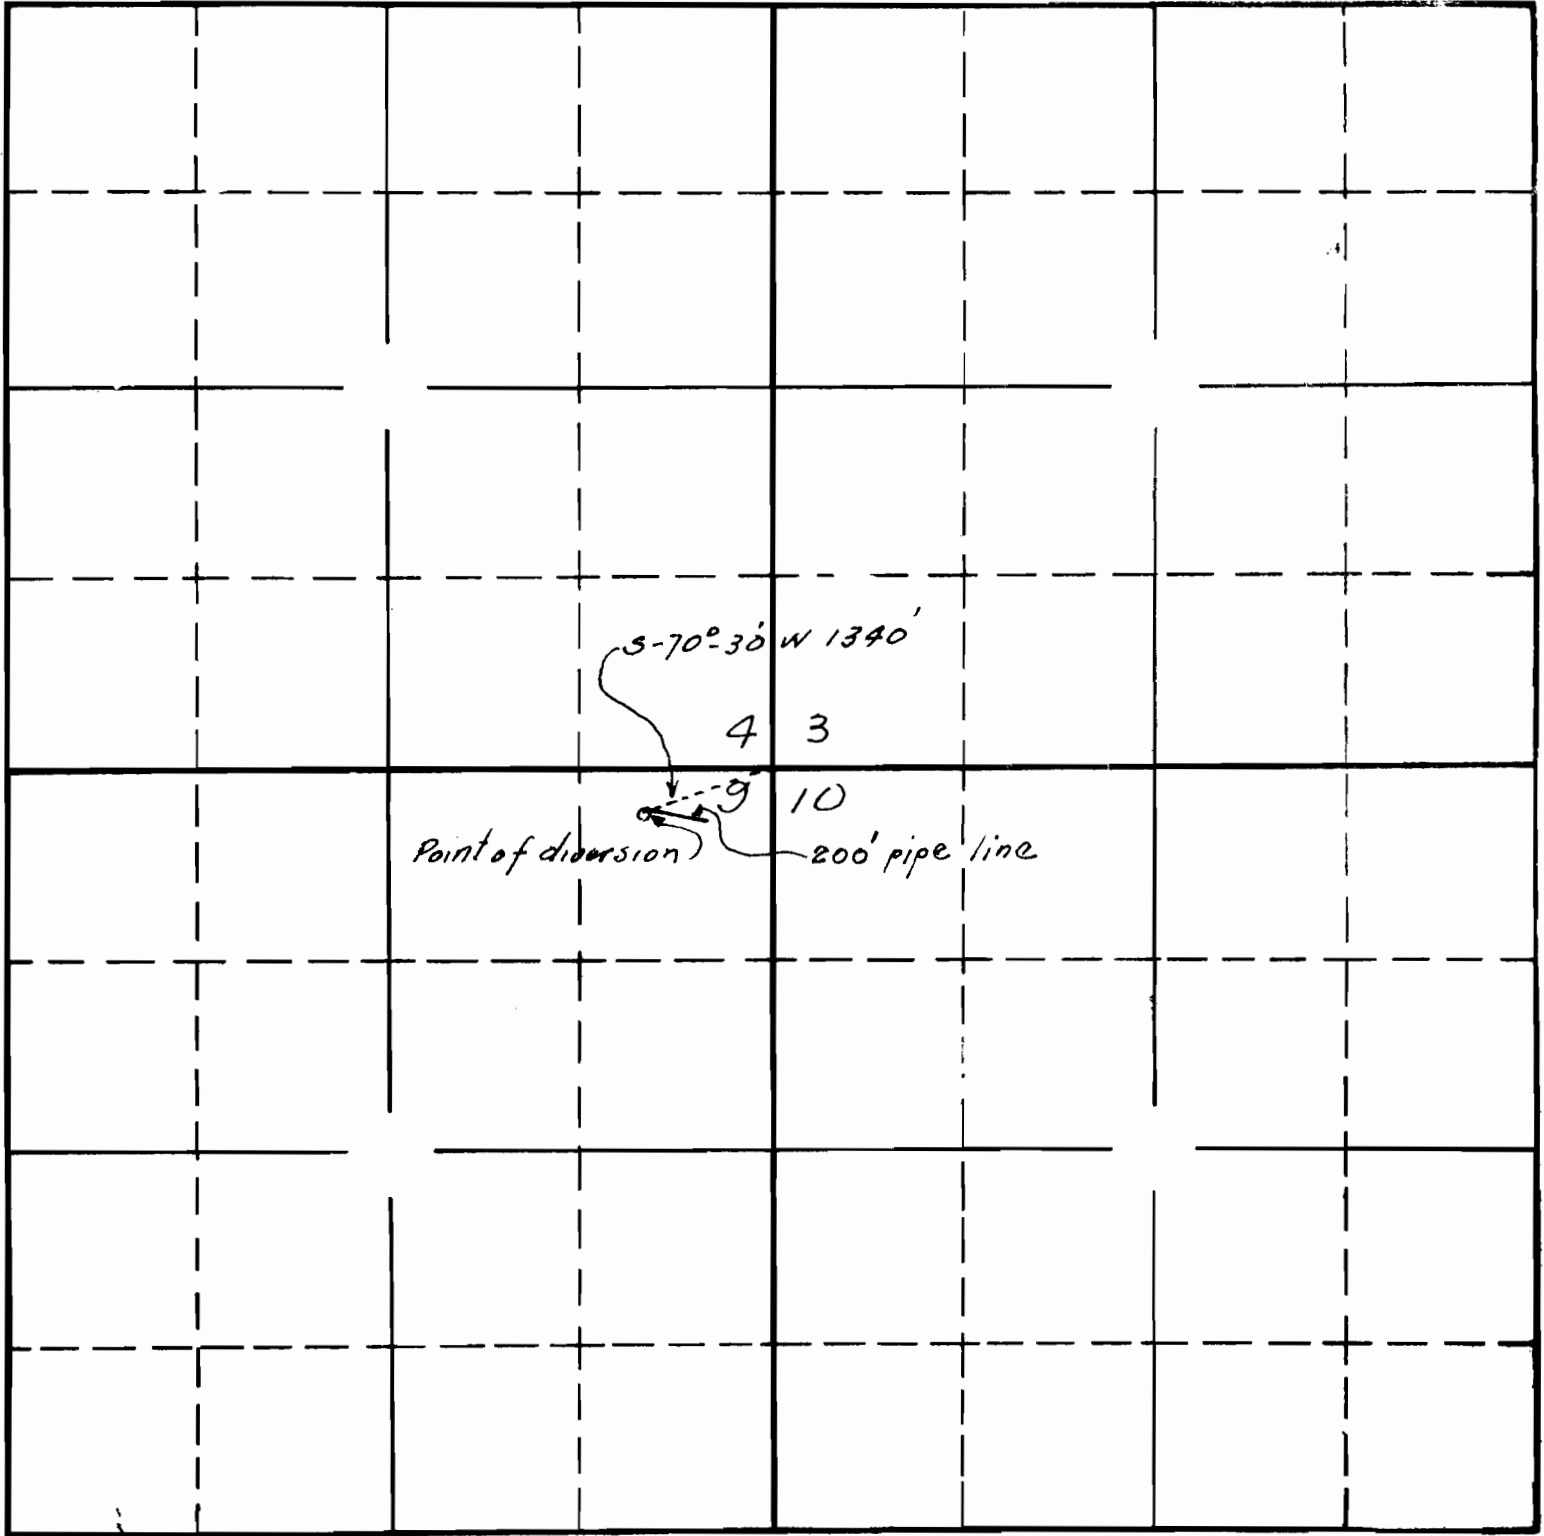

South

APPLICATION No. 15854

PERMIT No. 11693