
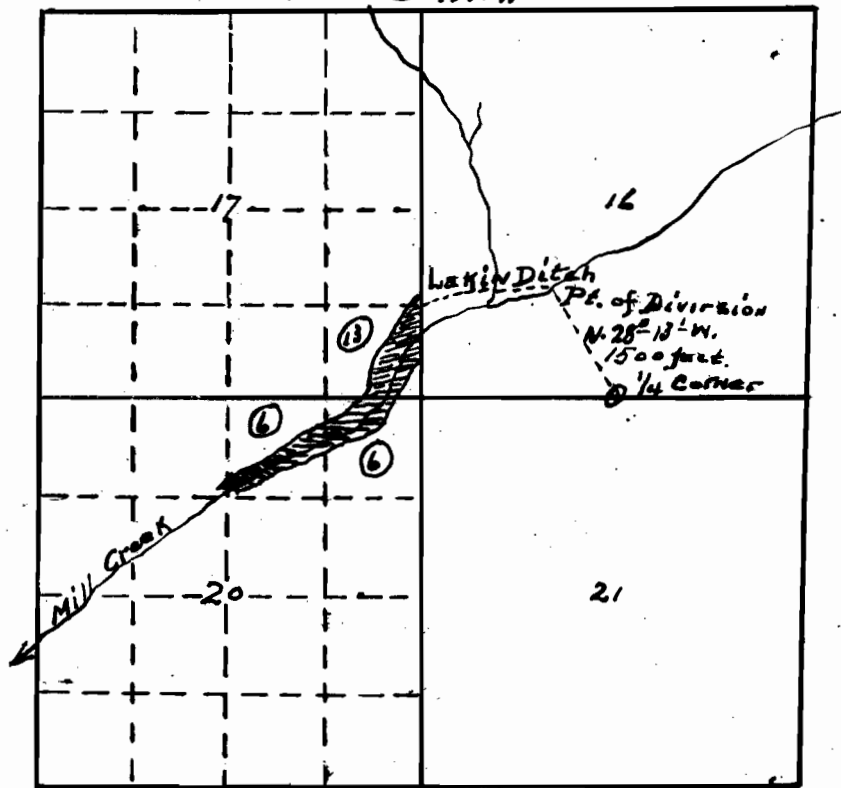


T. 13 S. R. 13 E. W. 4.

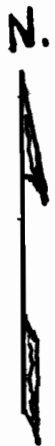

App. No. 15855  
Per. No. 11694

5/26 - 15855