


SECTION

TOWNSHIP 38.5, RANGE 7W., W. M.

North

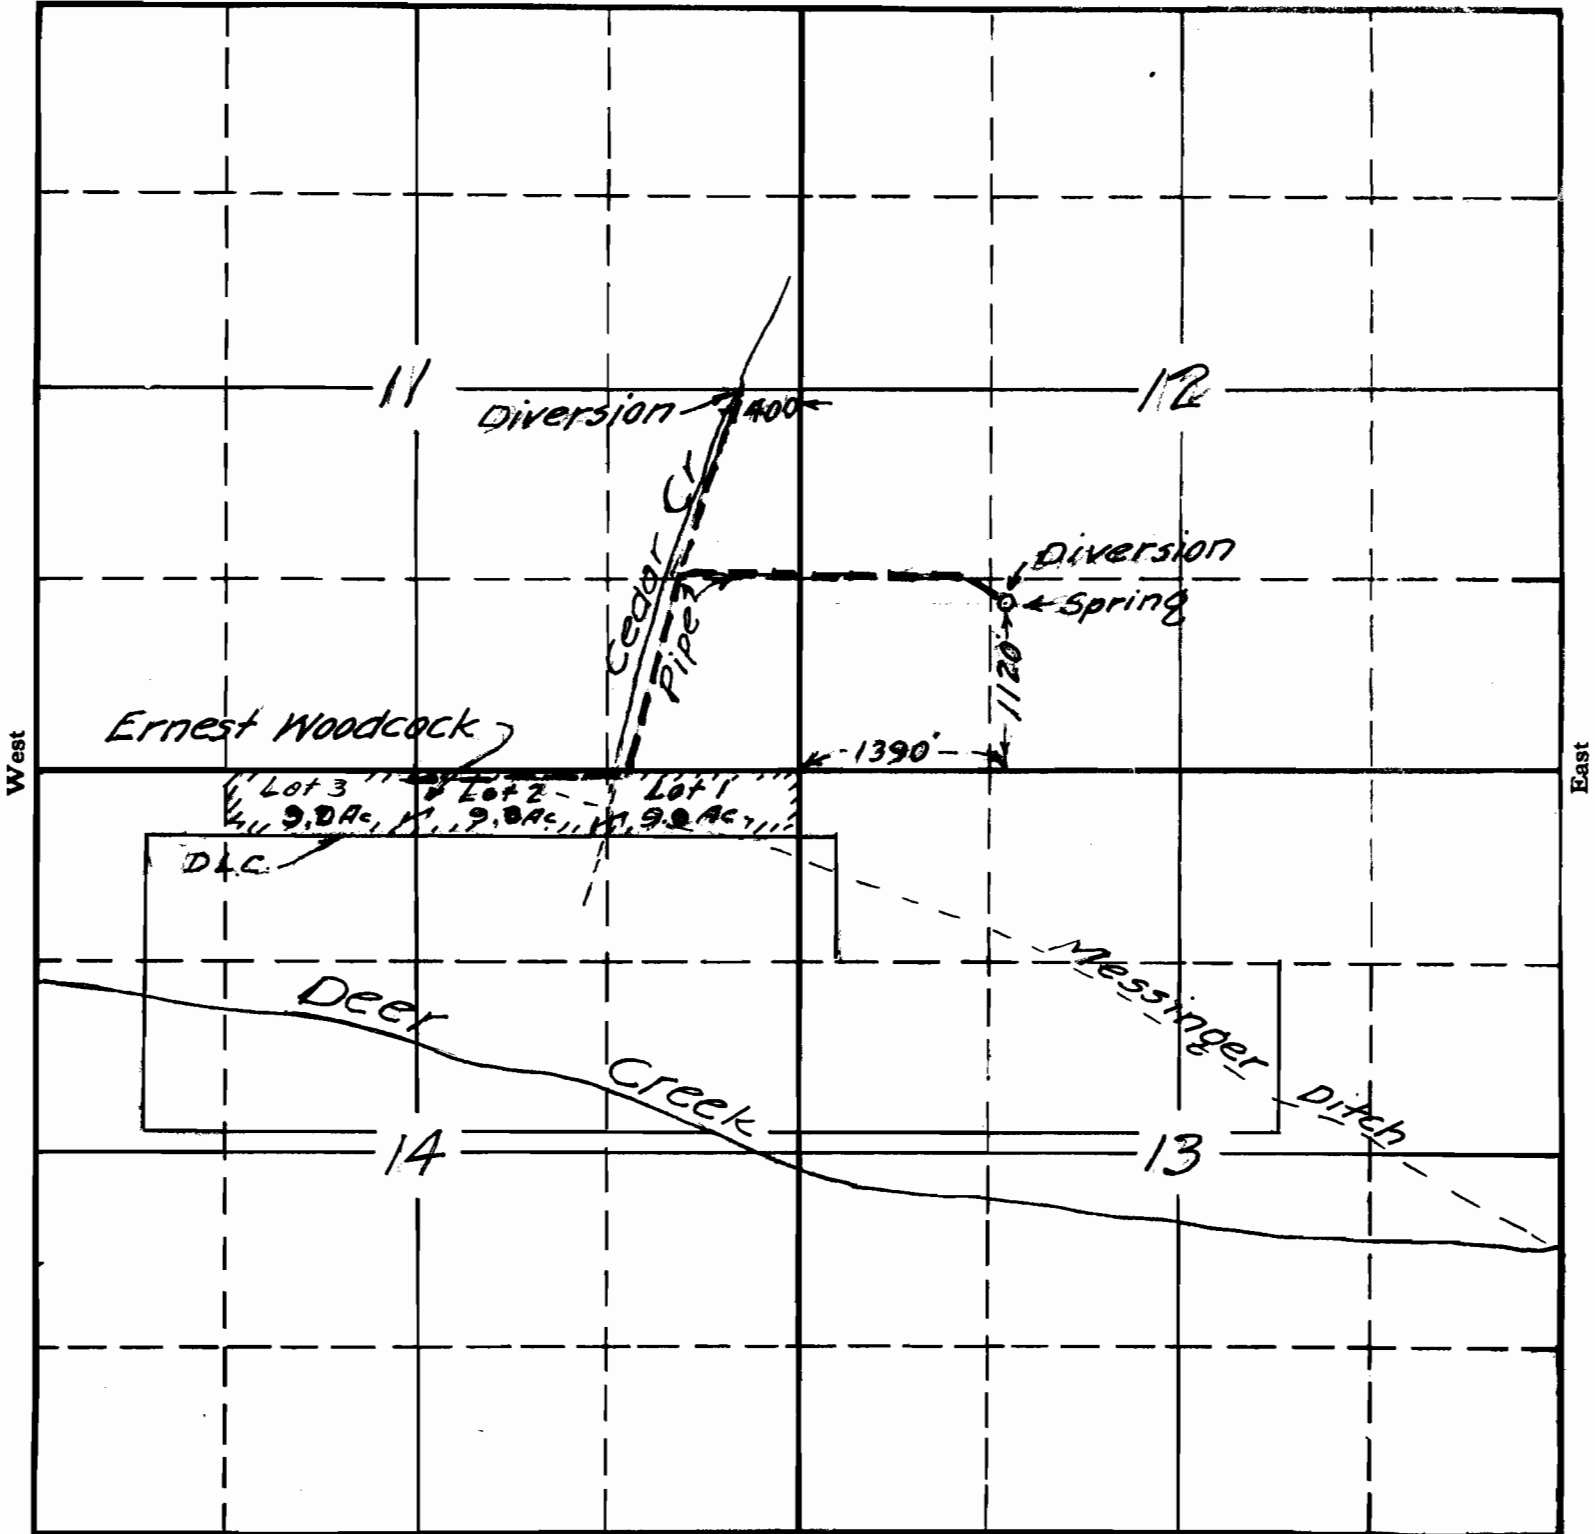

South

APPLICATION No. 15861

PERMIT No. 11696