


SECTION

TOWNSHIP 3^S, RANGE 10W, W. M.

North

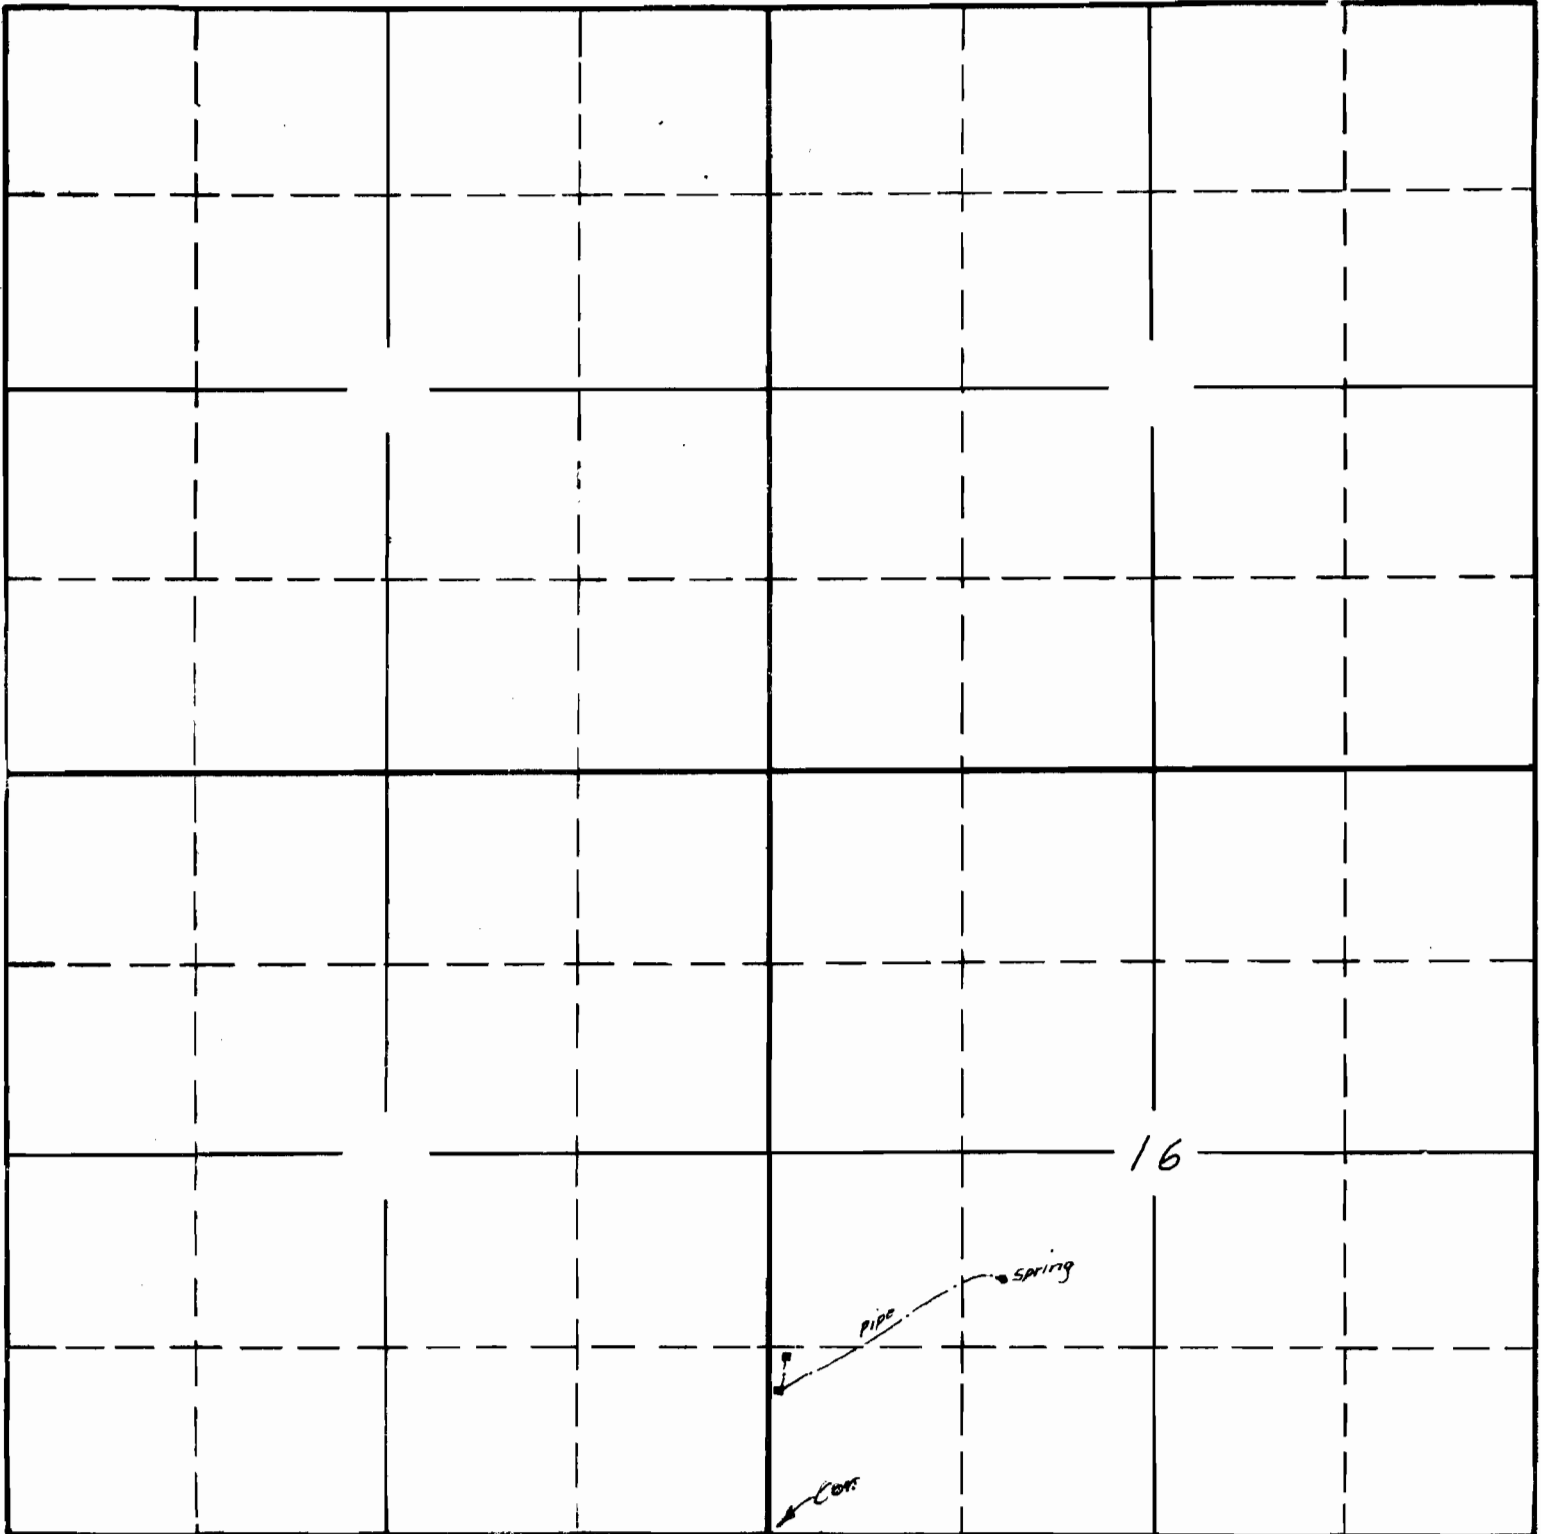

West

East

16

Pipe

Spring

Cor.

South


Surveyed May 31 1929

APPLICATION No. 15864
PERMIT No. 11722

SECTION

TOWNSHIP 35, RANGE 10W, W. M.

North

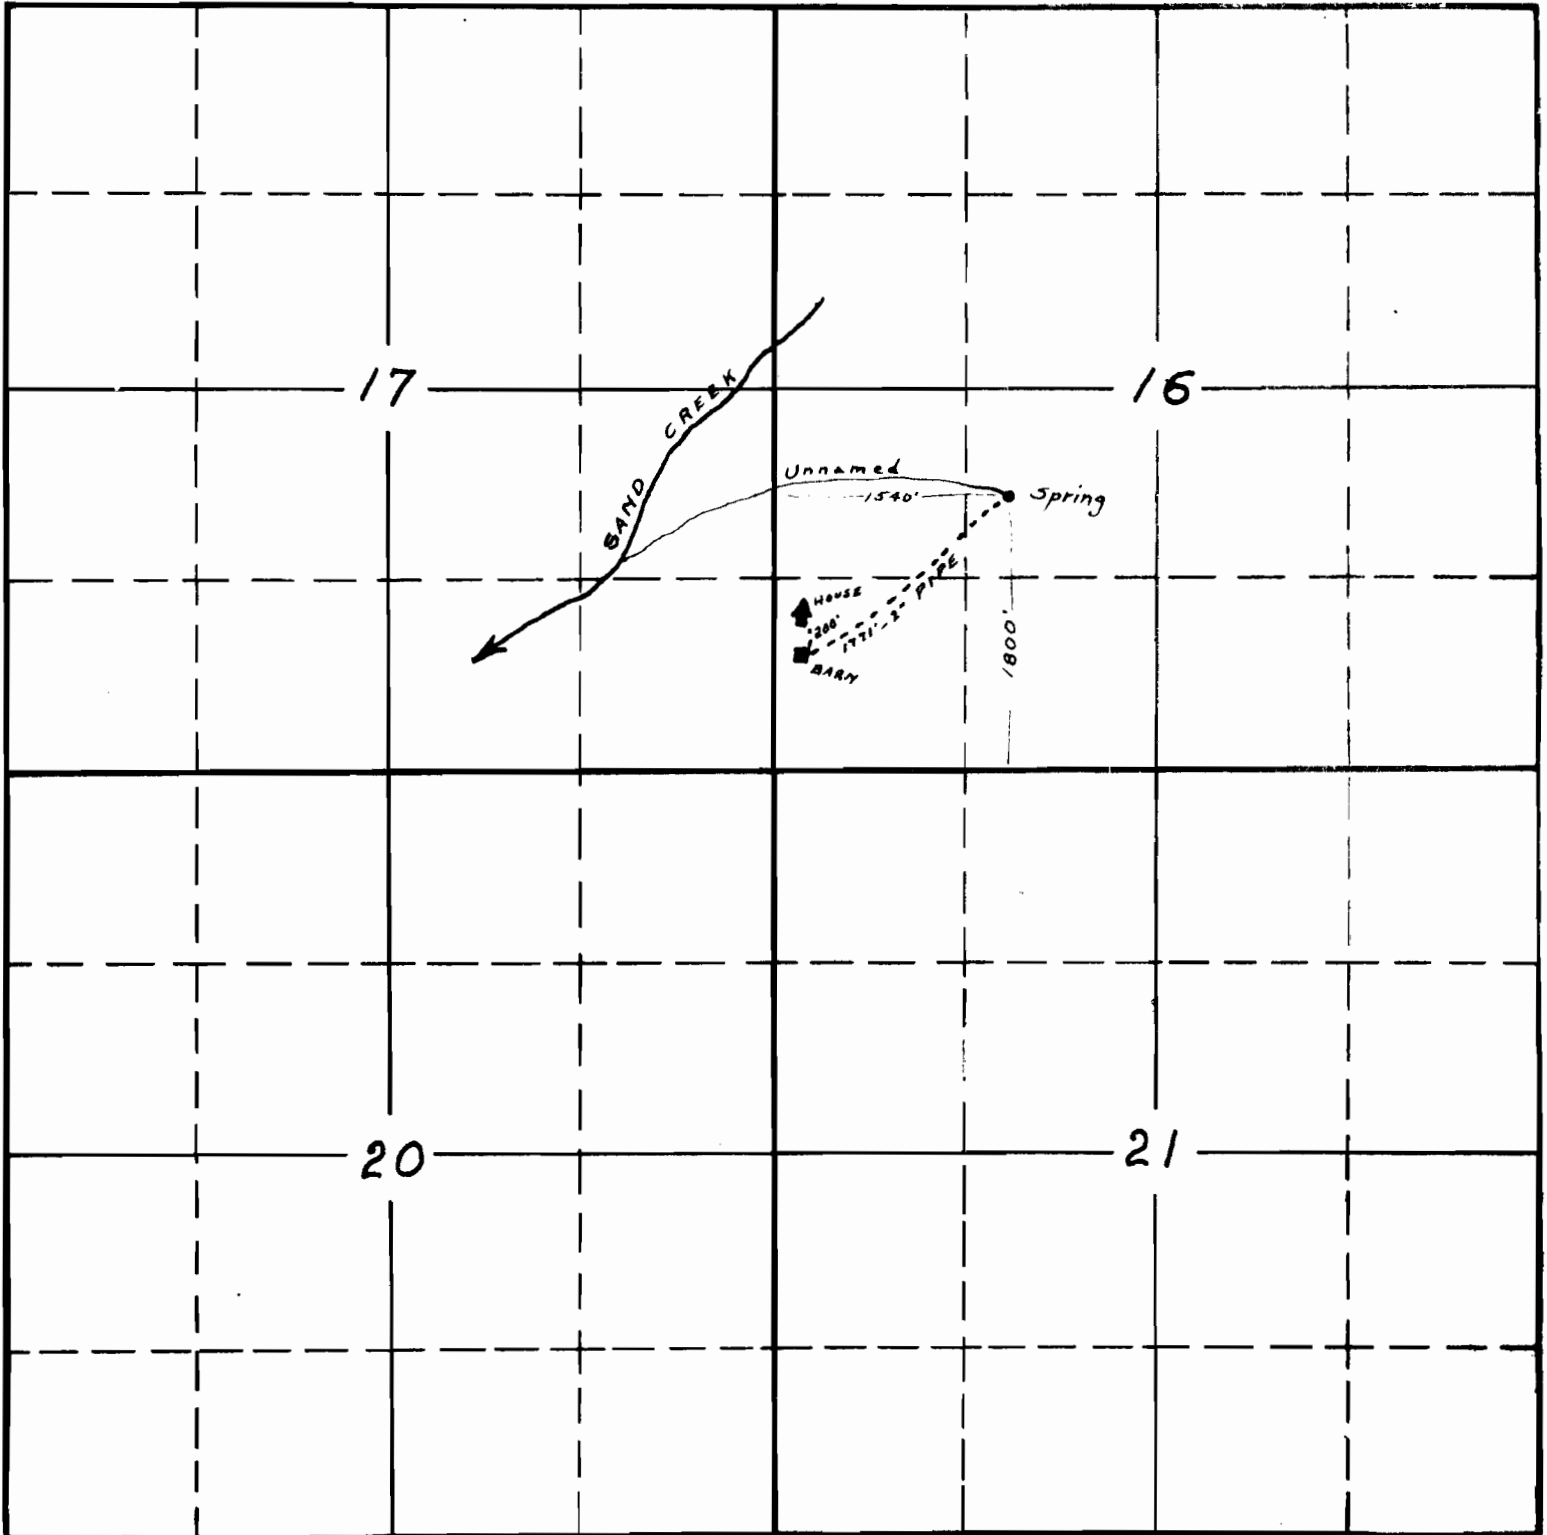

South

Copied from applicant's sketch - 5/6/35.

1-1-35
APPLICATION No. 15864
PERMIT No. 11722