


SECTION

TOWNSHIP 33 S, RANGE 9 W, W. M.

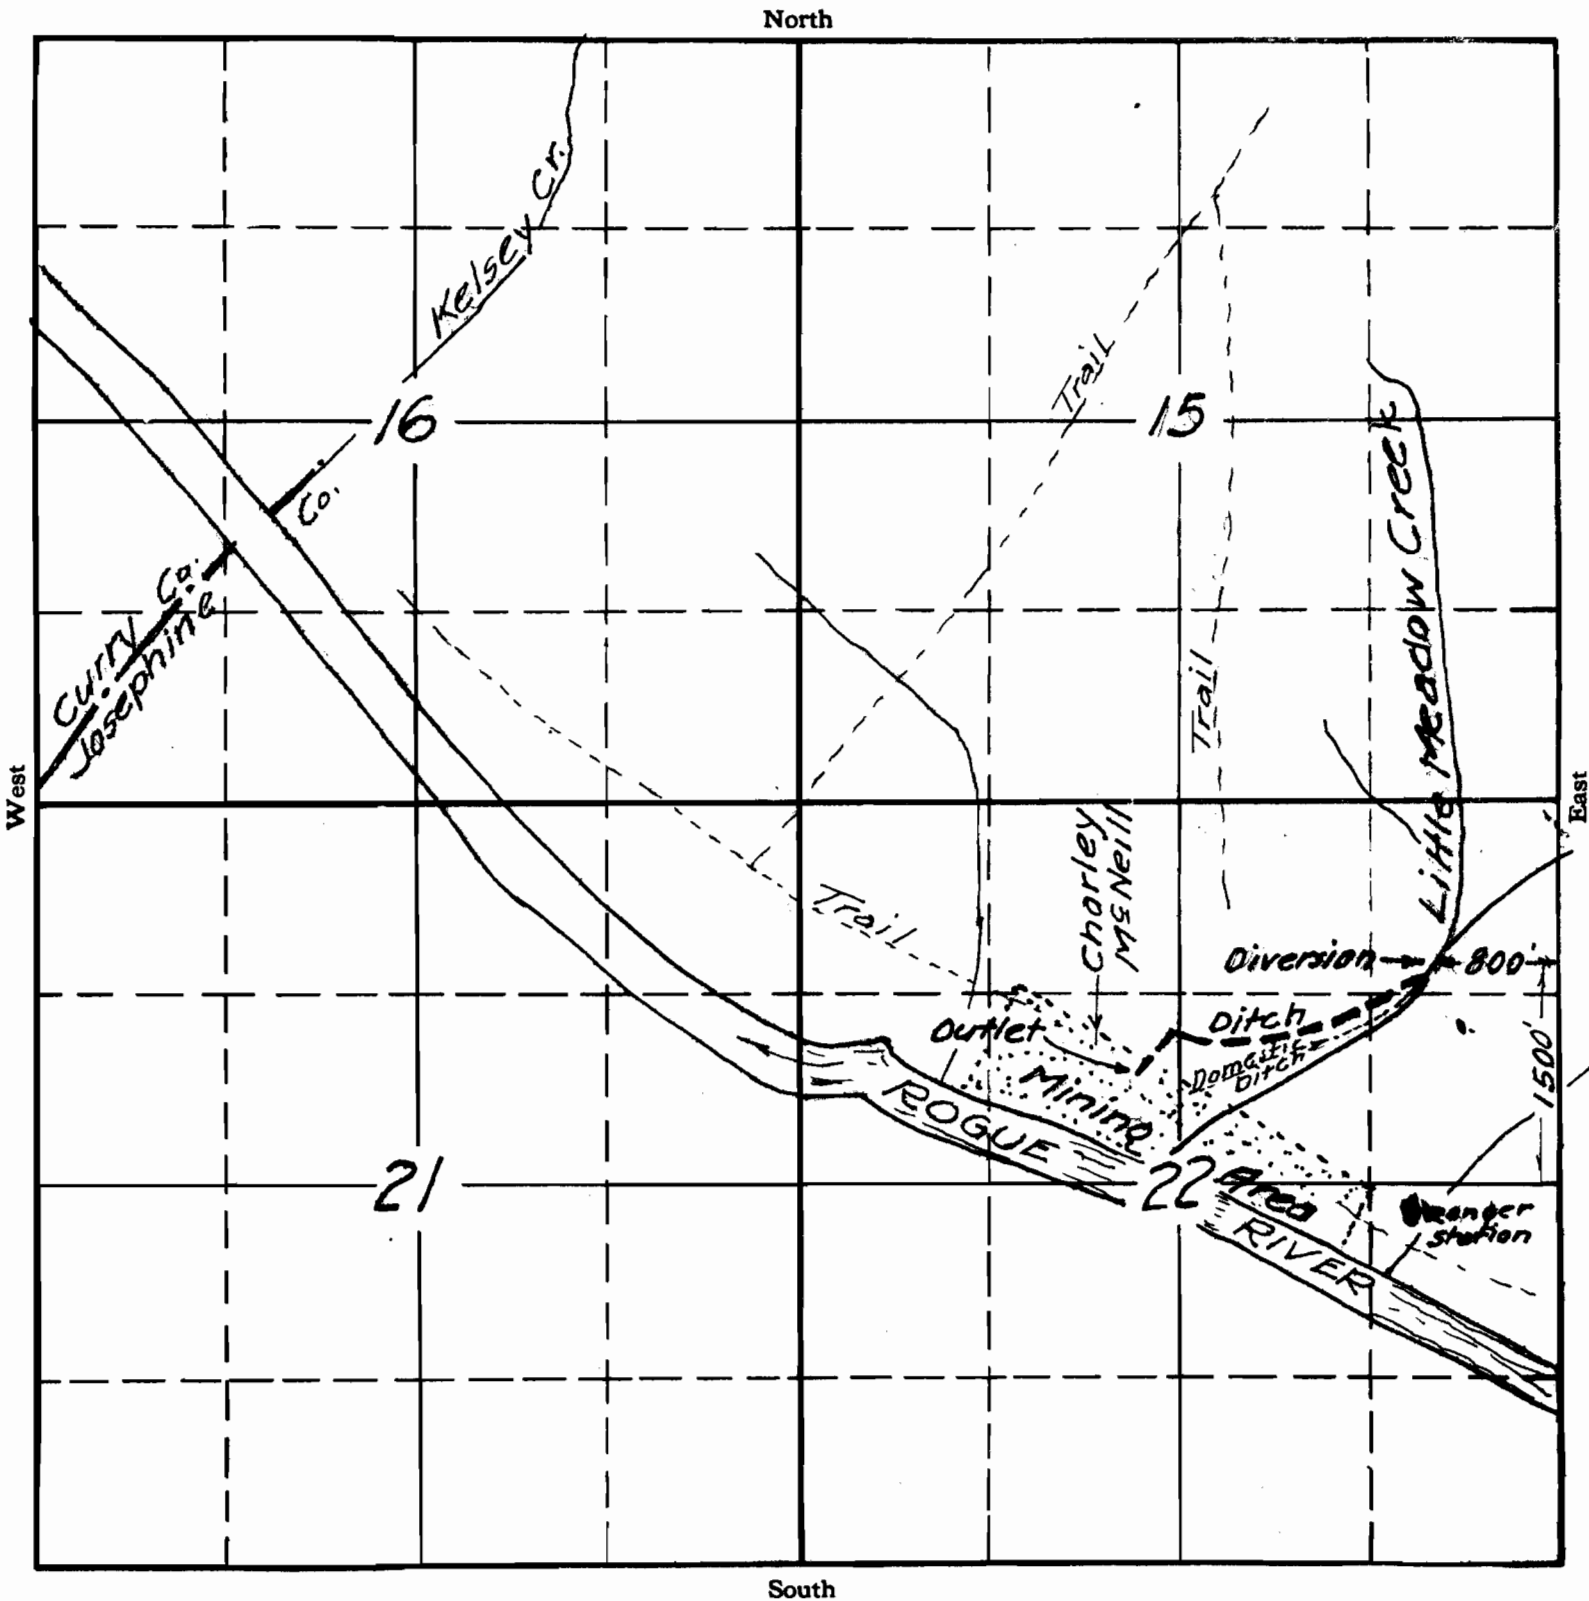

APPLICATION No. 15883

PERMIT No. 11729