


TOWNSHIP 33 S, RANGE 2 W, W. M.

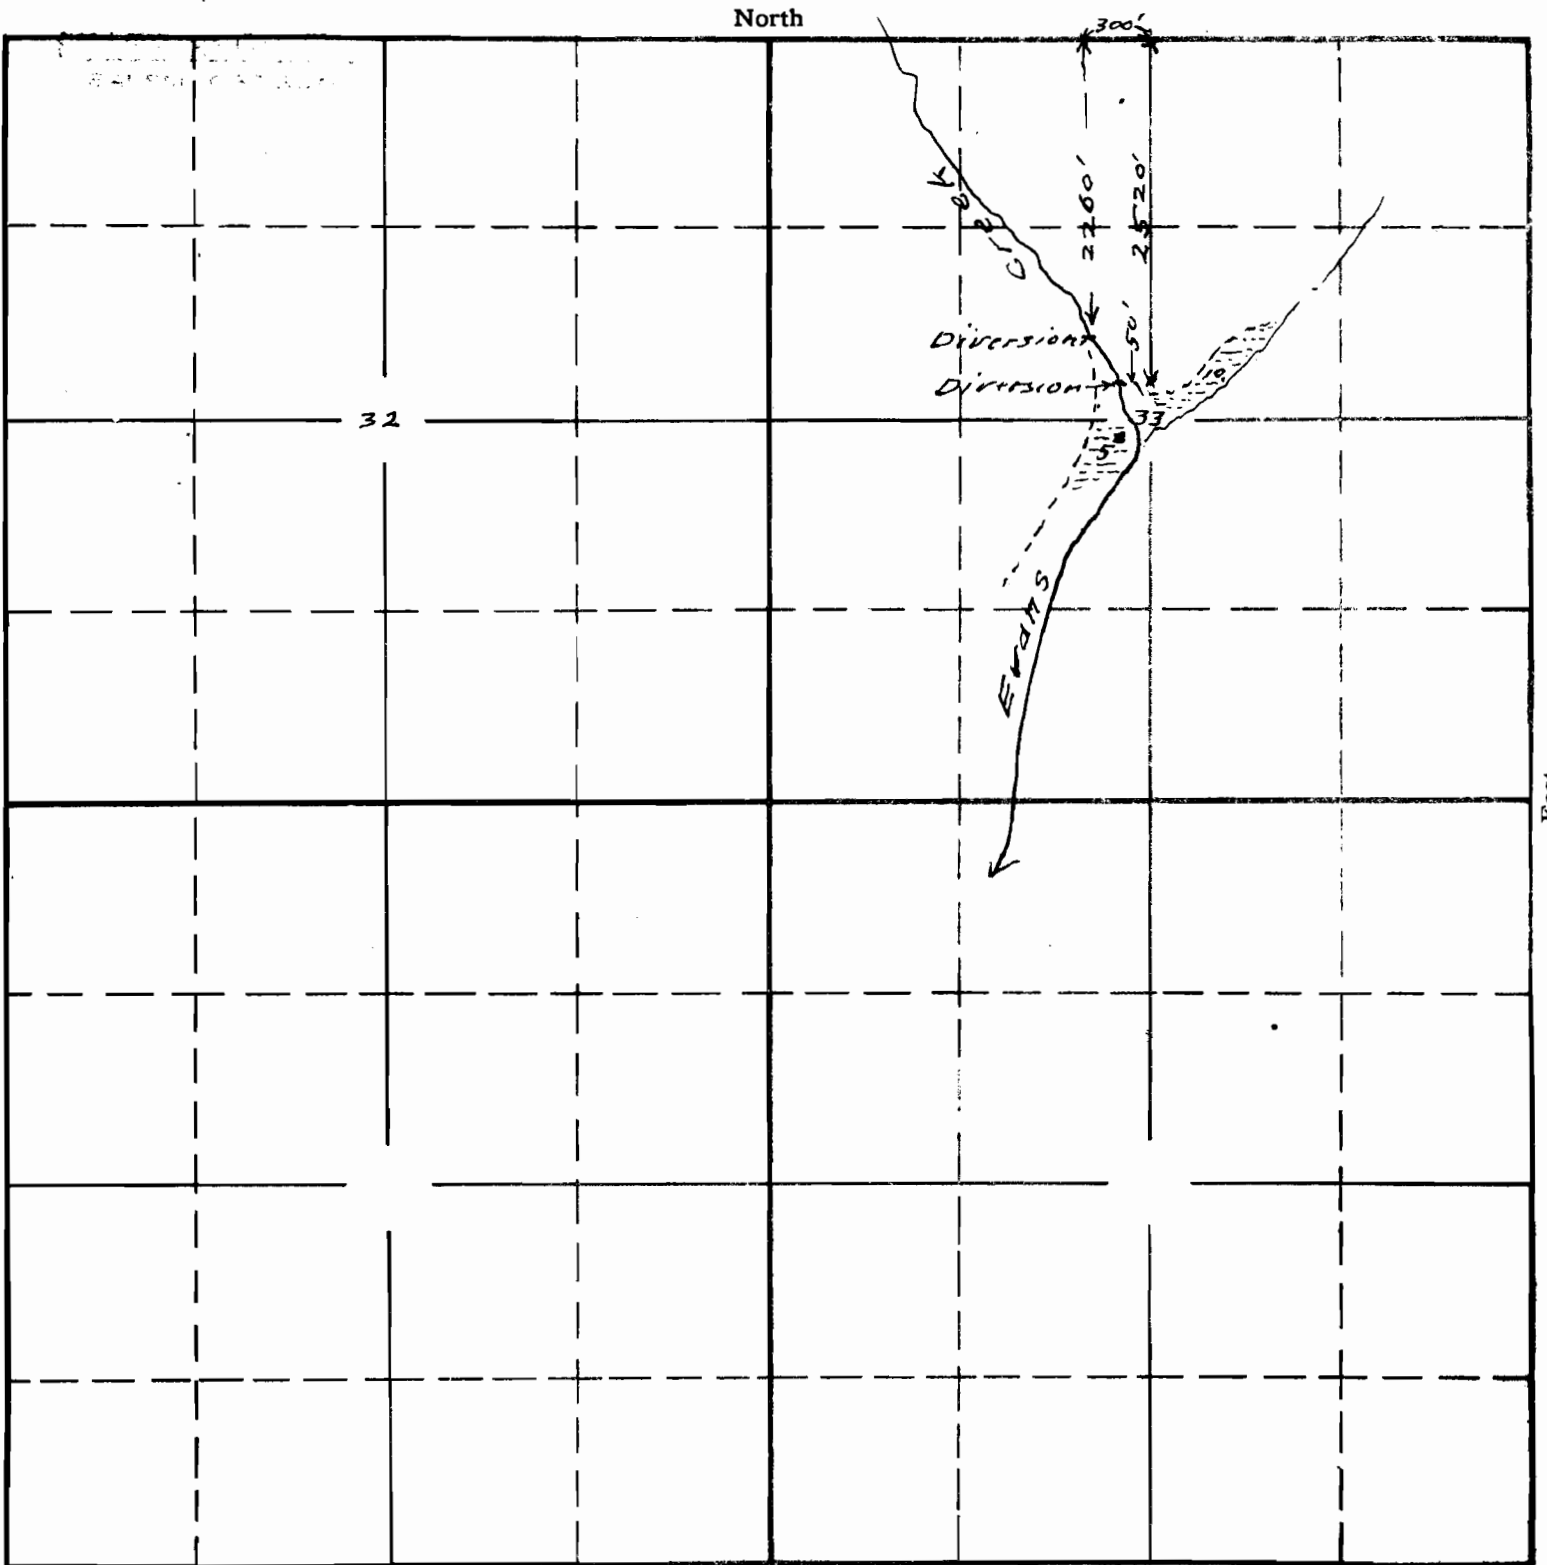

Map to accompany application of Joseph Now  
 To appropriate the waters of Evans Cr.  
 for irrigation and domestic

APPLICATION No. 15884

PERMIT No. 11730