


SECTION

TOWNSHIP 11S, RANGE 3W, W. M.

North

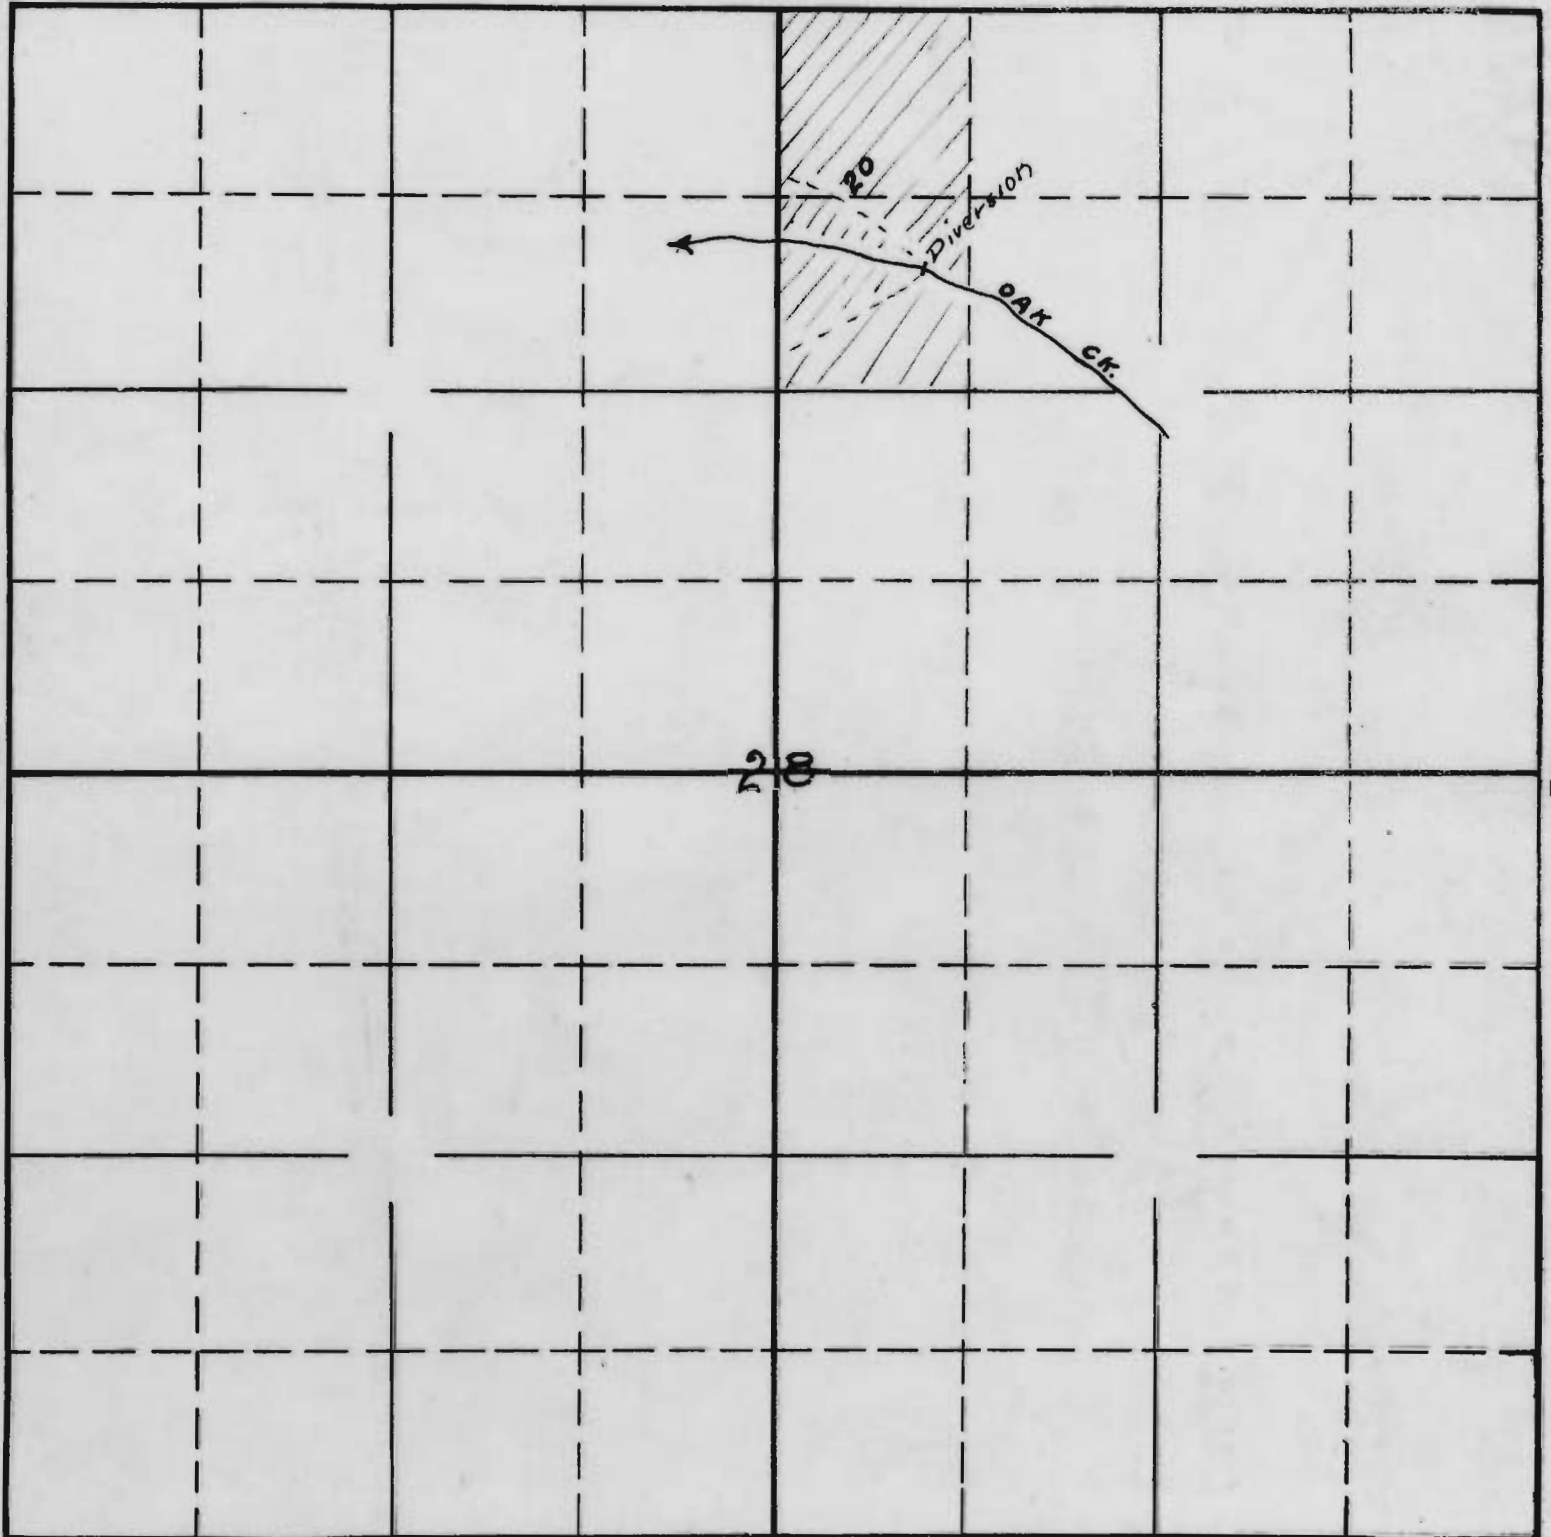

South

2-4

APPLICATION No. 15899

PERMIT No. 11739


SECTION

TOWNSHIP 115, RANGE 3W, W. M.

North

29

28

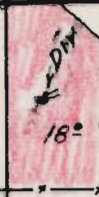

West

East

South

Surveyed by CAC.
Apr 14 1939

APPLICATION No. 15899
PERMIT No. 11739