


SECTION

TOWNSHIP 37S, RANGE 3W, W. M.

North

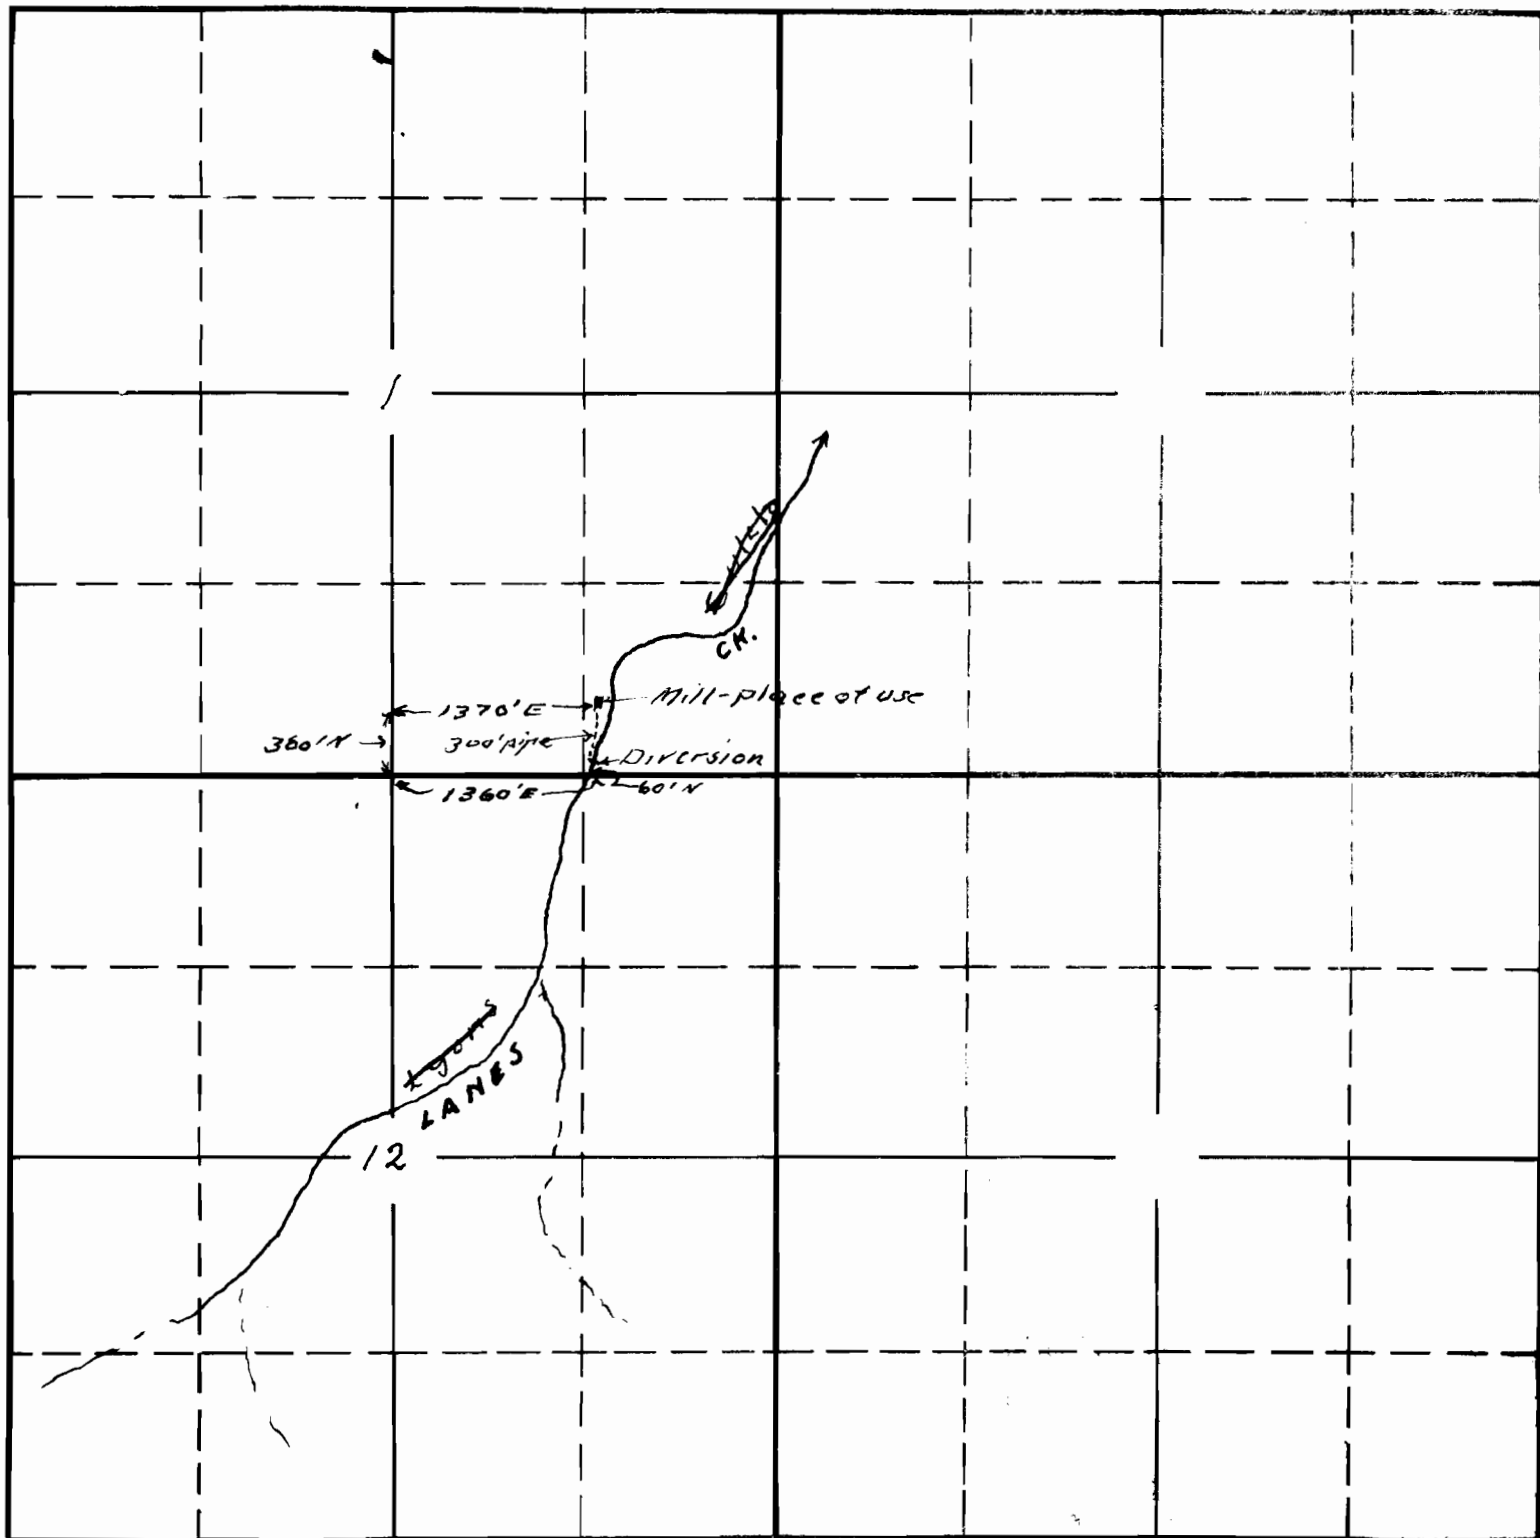

Map To accompany application ^{South} of
 A O Bailey and Sons for the use of the waters
 of Lyons Creek, for Milling purposes

APPLICATION No. 15904
 PERMIT No. 11742