


TOWNSHIP 35S, RANGE 14W, W. M.

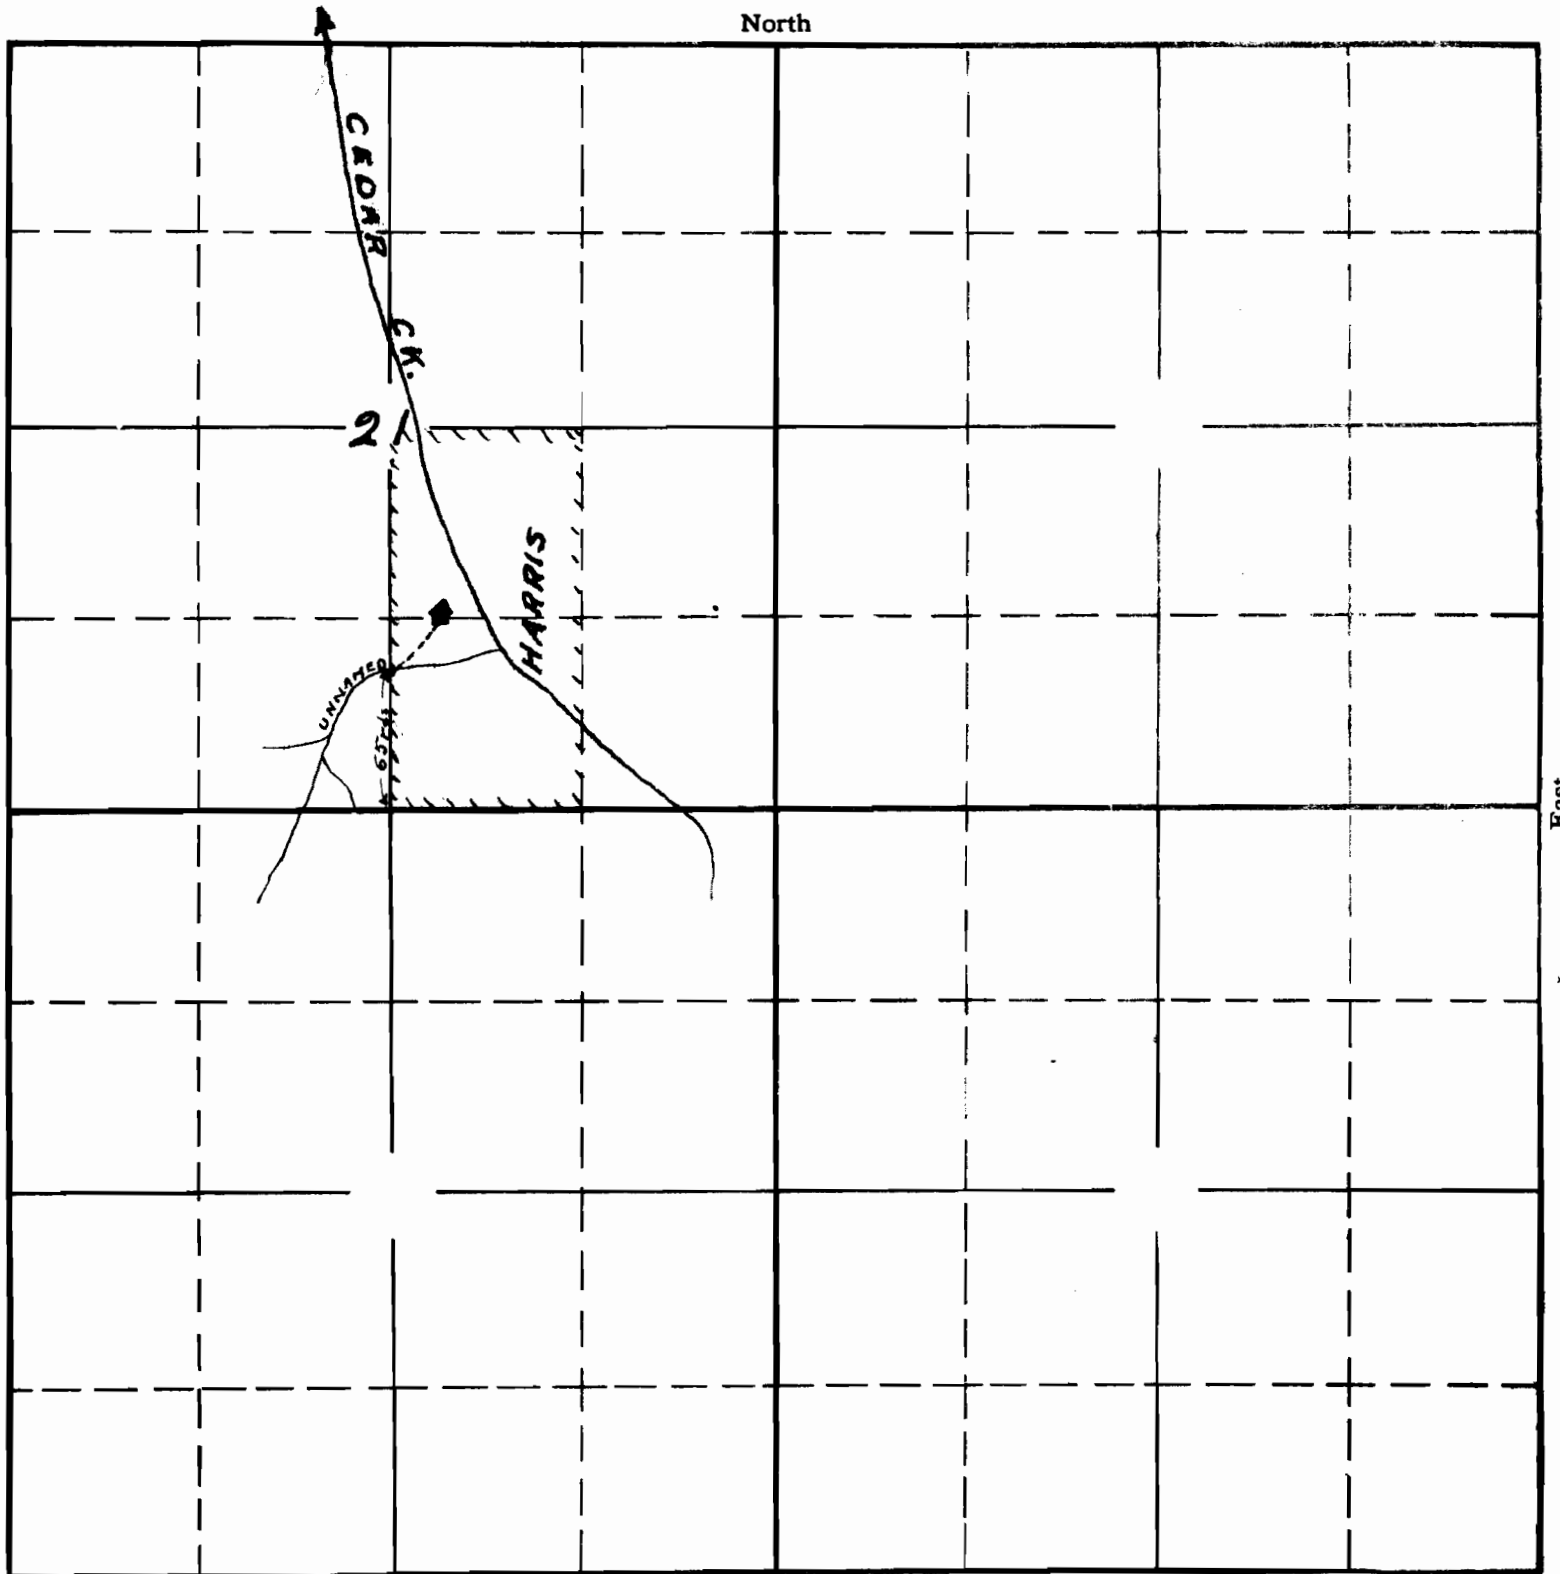

Prepared in office of
State Engineer from applicant's
sketch - 6/28/35.

APPLICATION No. 15906
PERMIT No. 11744


SECTION

TOWNSHIP 35S, RANGE 14W, W. M.

North

West

East

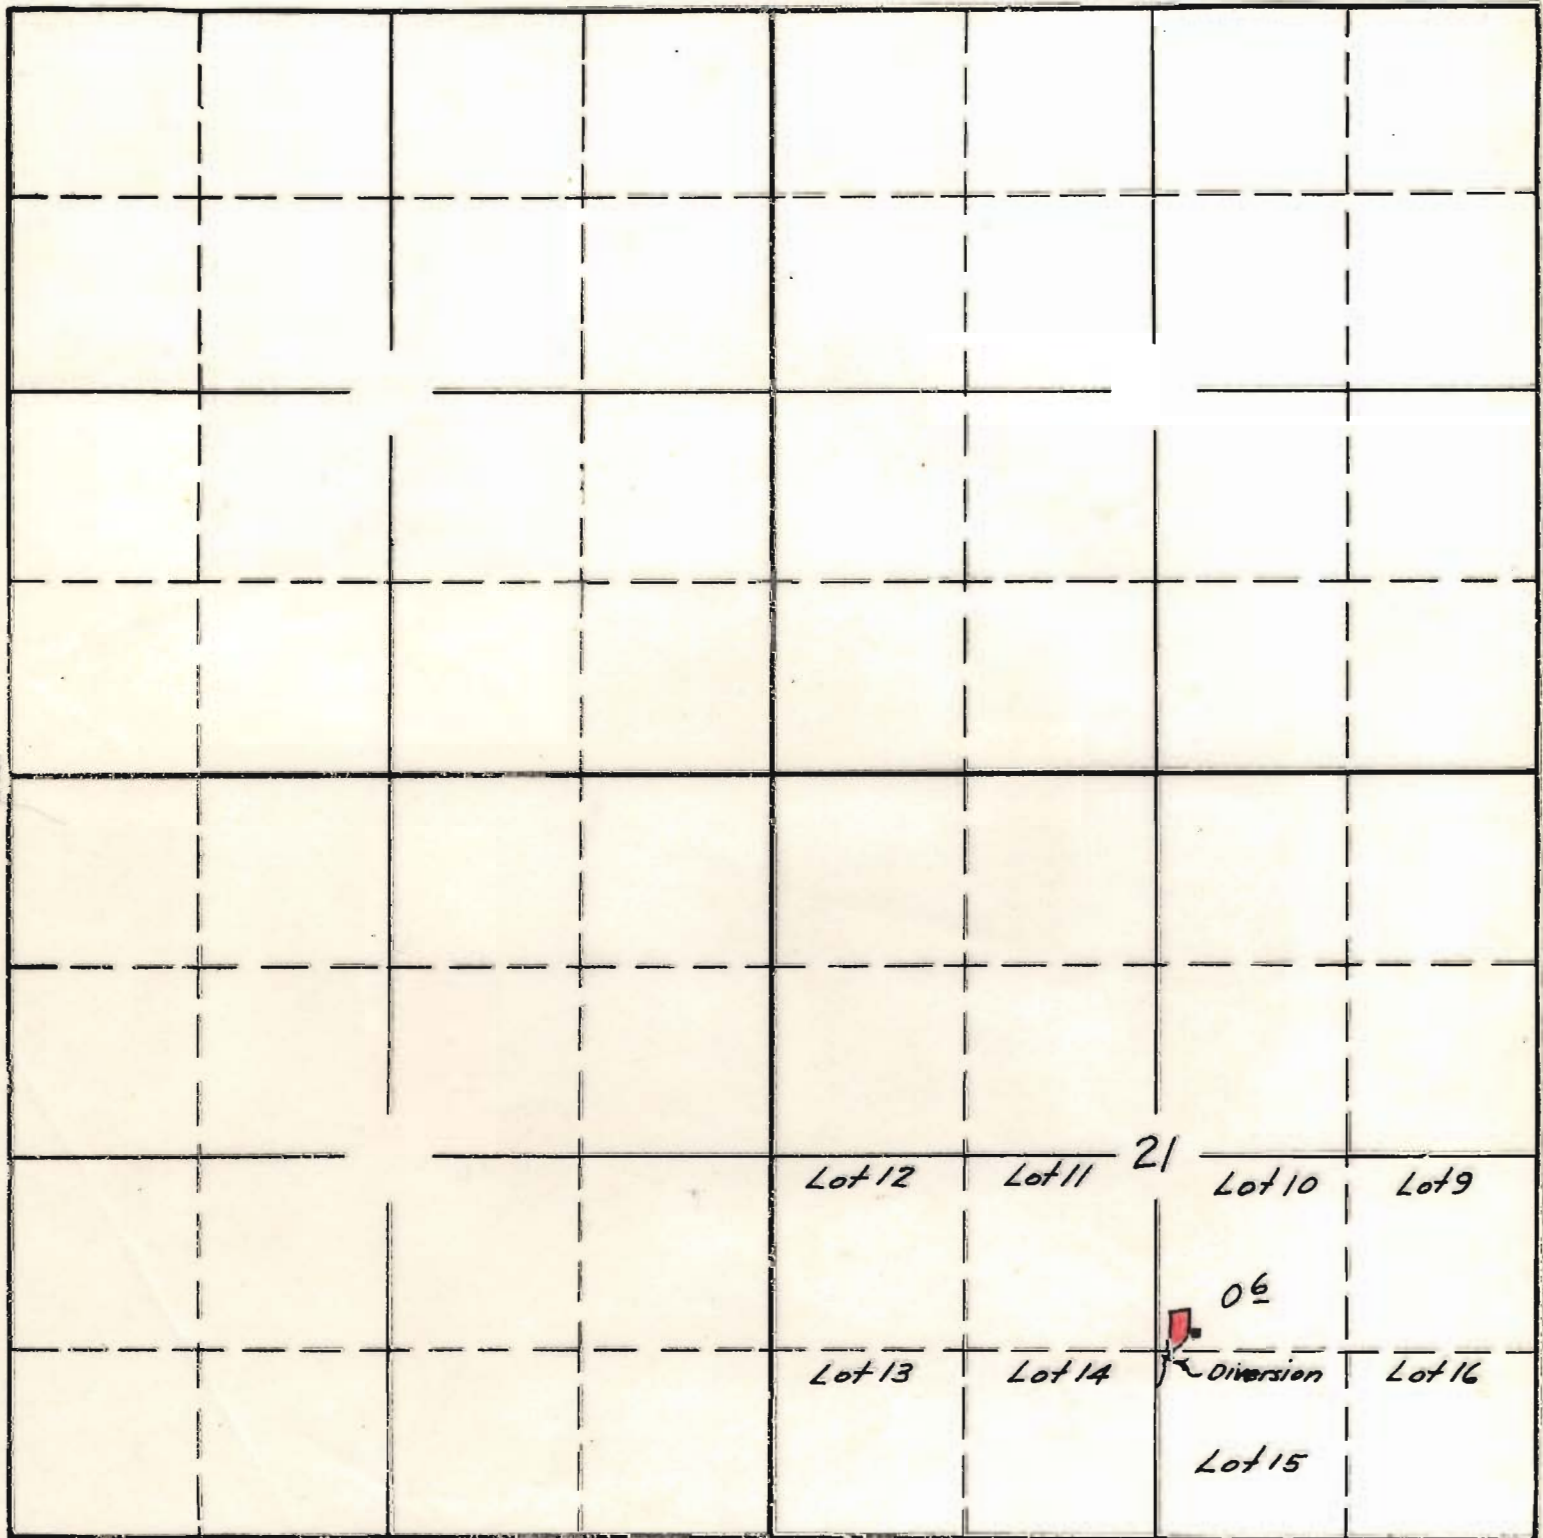

Surveyed July 6, 1940 C.A.C.

South

APPLICATION No. 15906

PERMIT No. 11744