


SECTION

TOWNSHIP *4N*, RANGE *37E*, W. M.

North

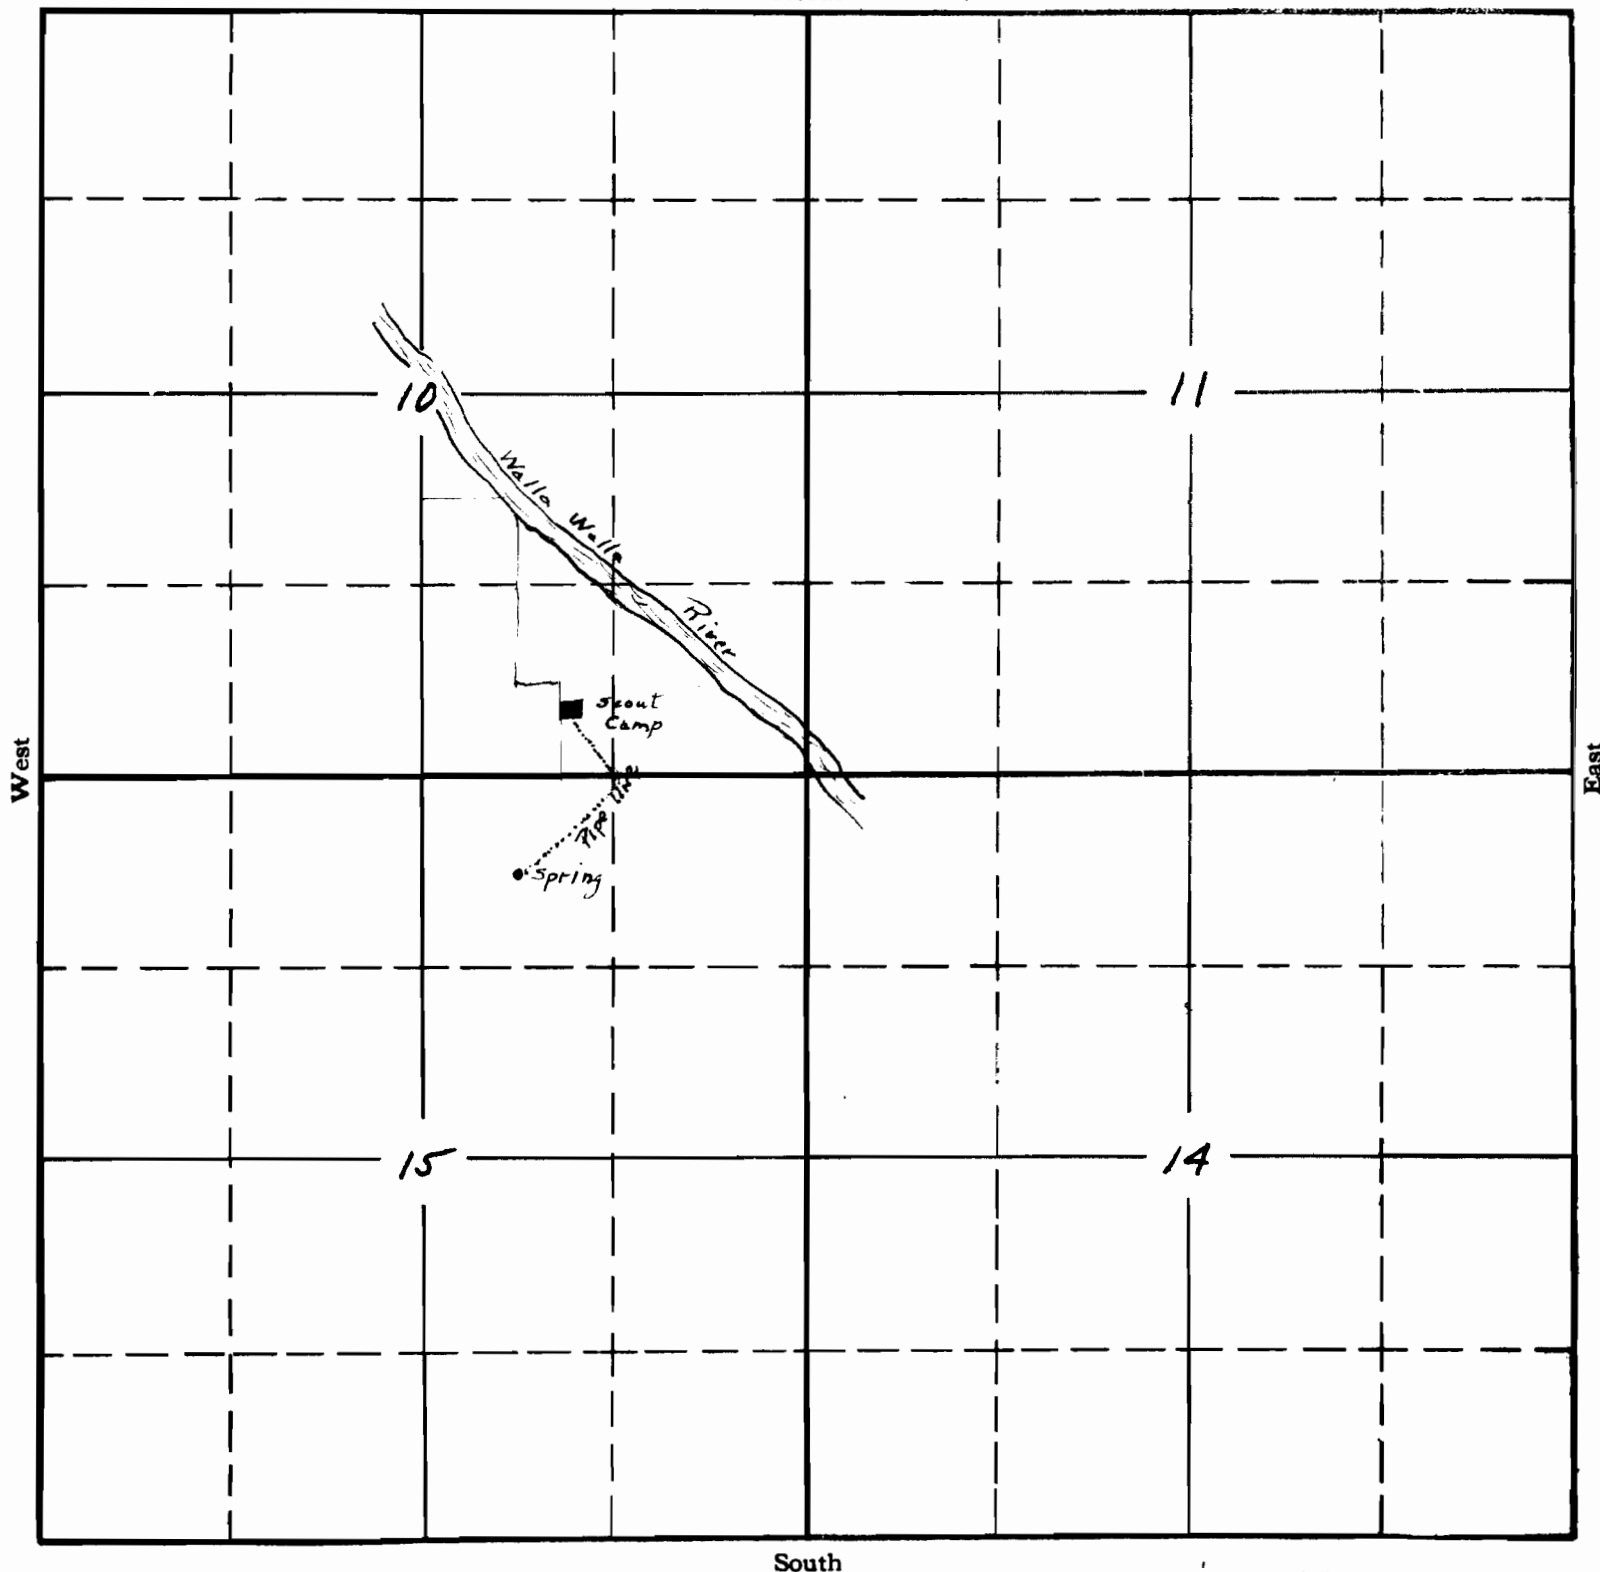

South

APPLICATION No. *15946*

PERMIT No. *11785*