


SECTION

1

TOWNSHIP 37.5, RANGE 7 W., W. M.

North

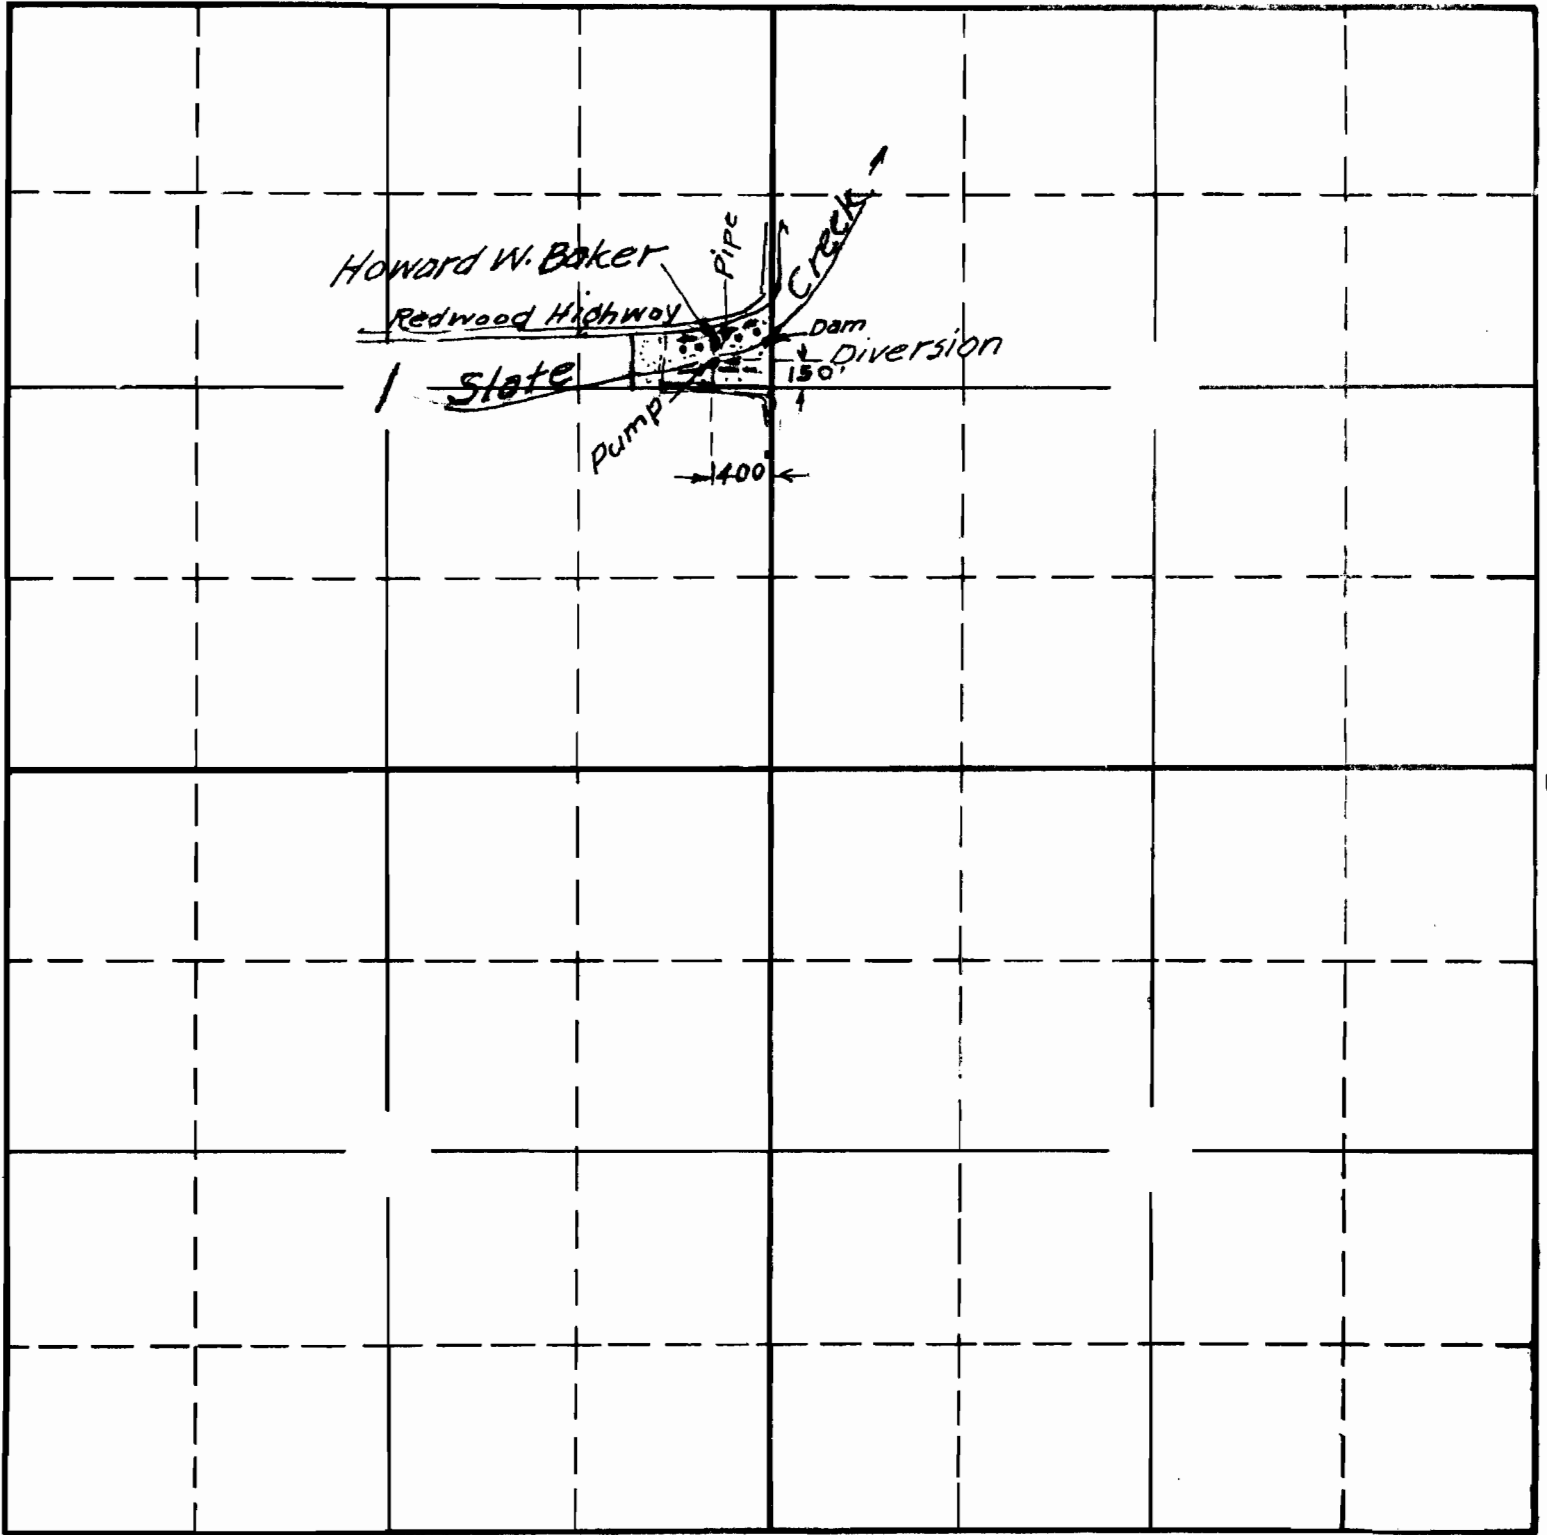

South

APPLICATION No. 15949

PERMIT No. 11788