


SECTION

TOWNSHIP 33S, RANGE 2E, W. M.

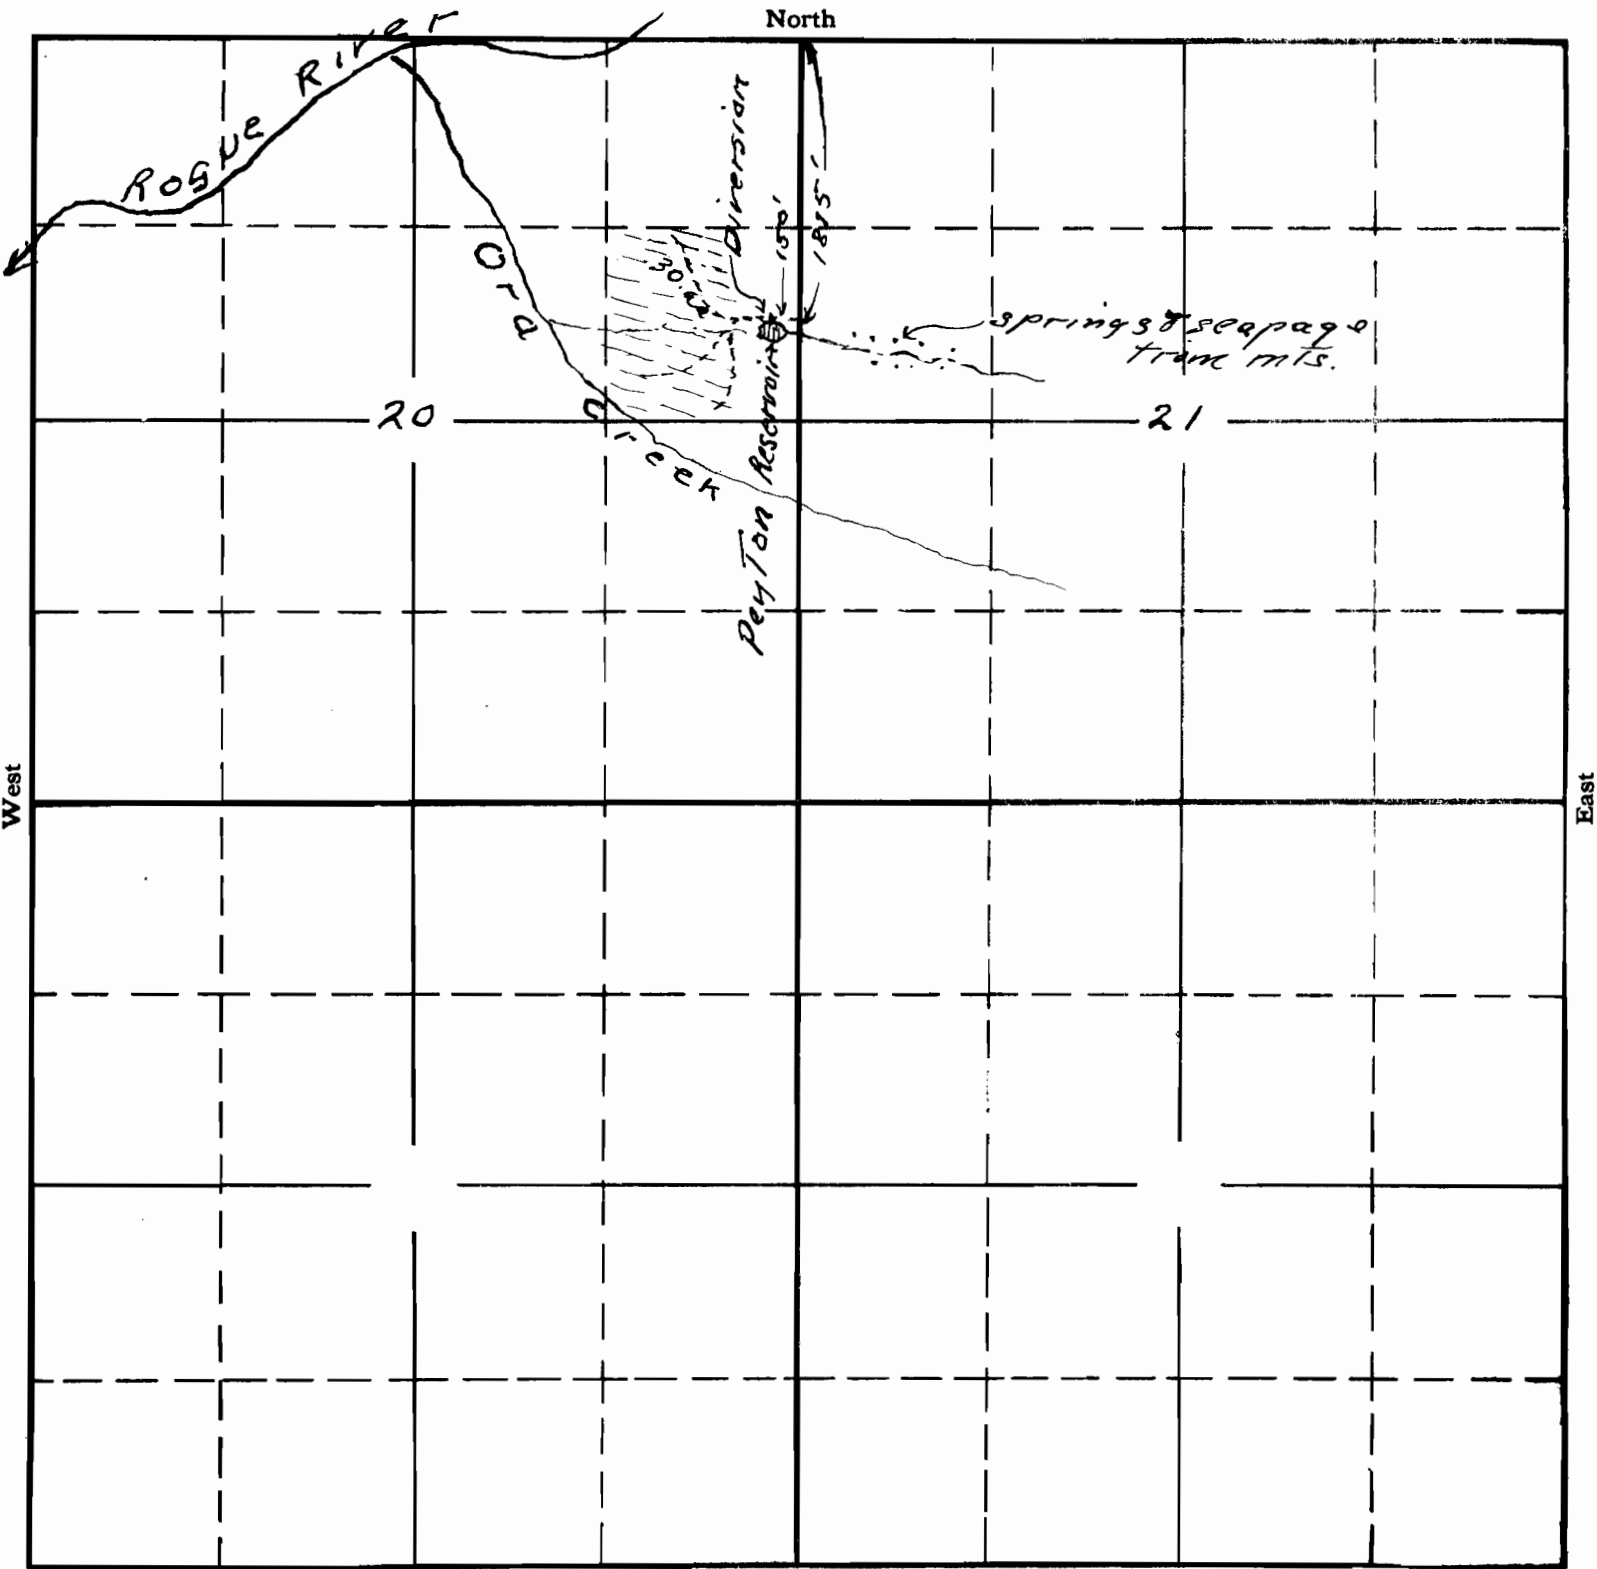

Map to accompany application of J.E. Peyton for irrigation of 15 ac ^{South} APPLICATION No. 15959
 Supplemental and 15 ac this app. Total 30.00 PERMIT No. 11793
 From Peyton Reservoir