


SECTION

TOWNSHIP 45, RANGE 8W, W. M.

North

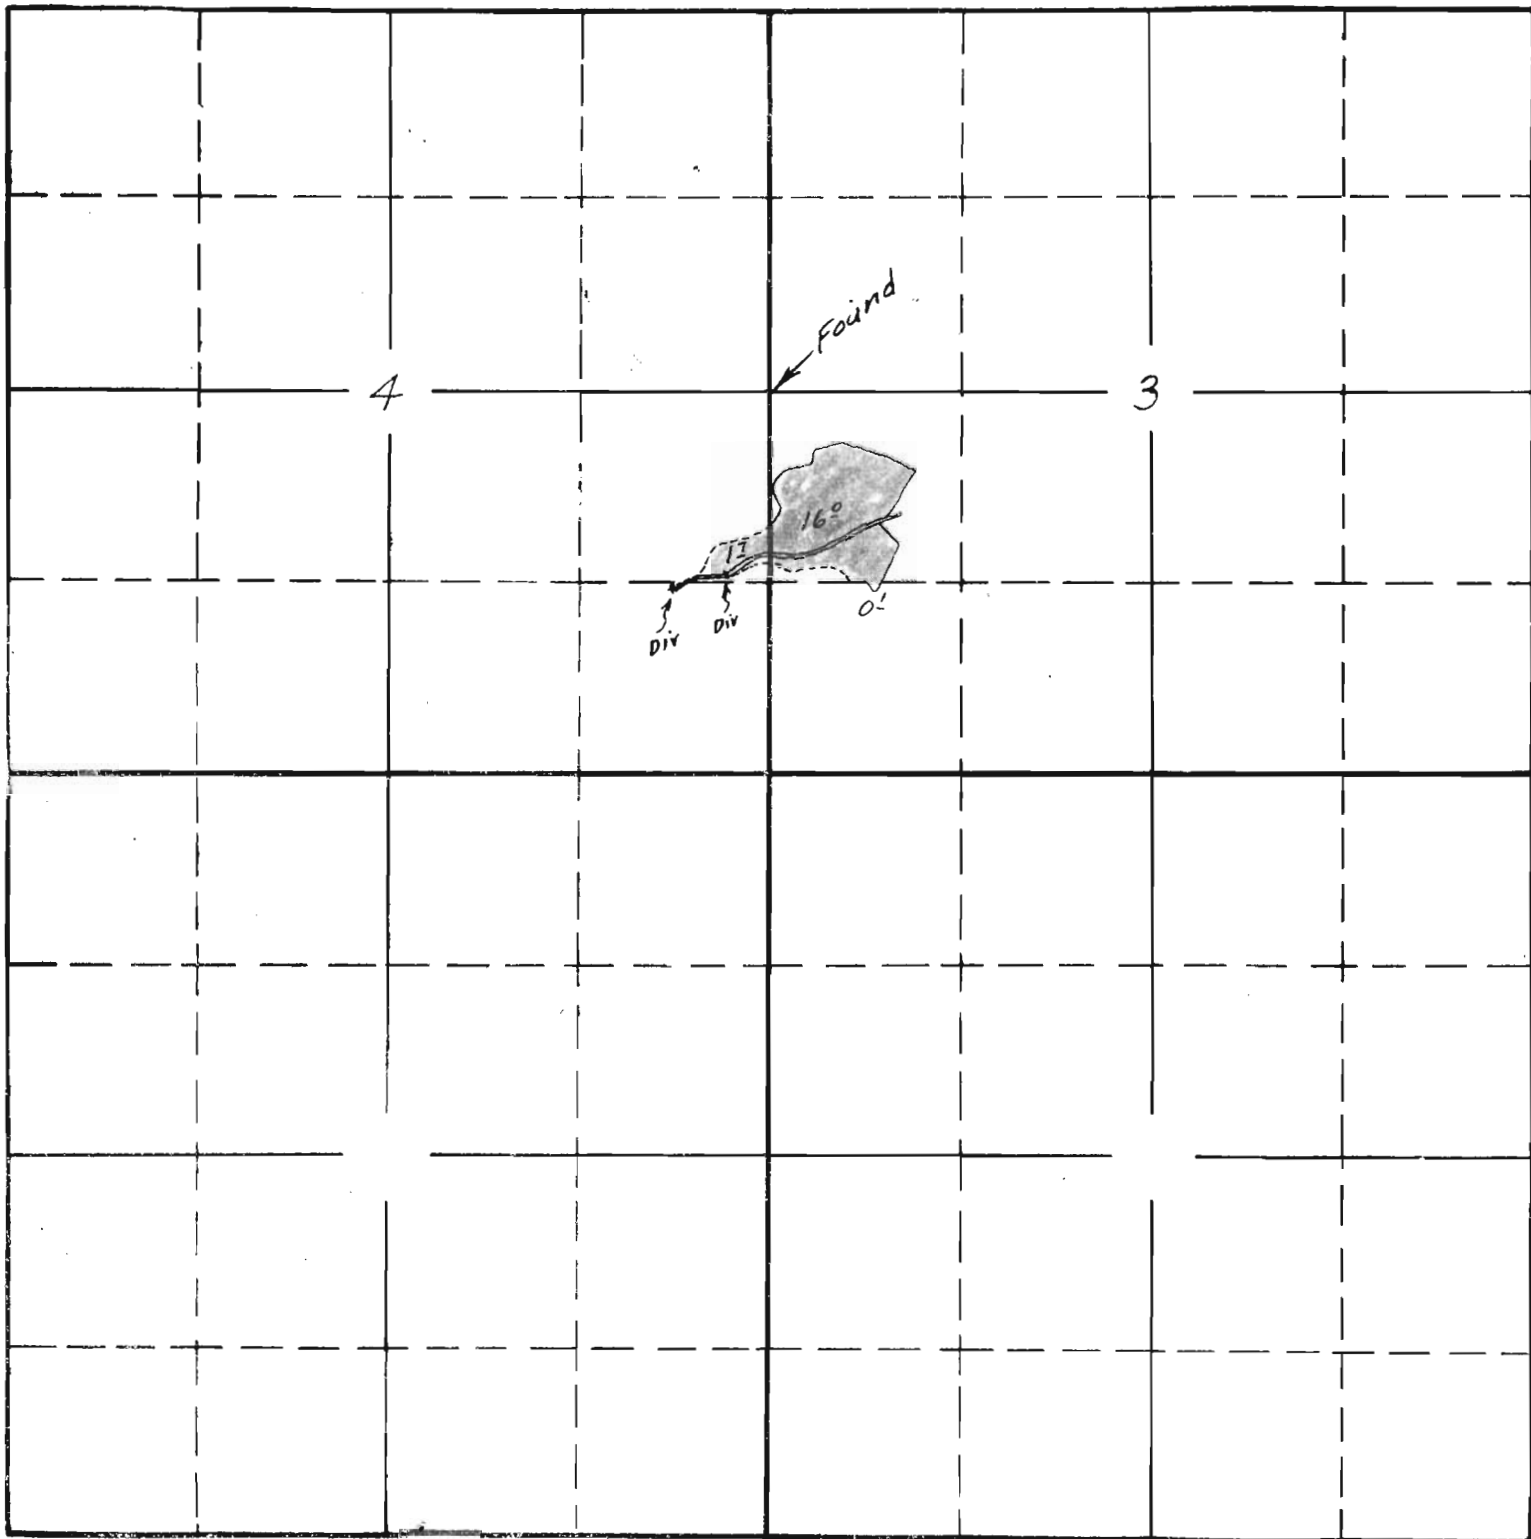

South

Surveyed by (AC June) 1939

APPLICATION No. 15969  
PERMIT No. 11800

Nestucca River  
518

POWDER CR.

1720' ditch  
77 Acres


2 Acres

ditch 700'

Wood Flume  
296

566' W of the  
70' N of the  
NE Cor of the SE 1/4  
of the SE 1/4 Sec 4

200' W of the NE Cor  
20' N of the SE 1/4  
of the SE 1/4 of Sec 4

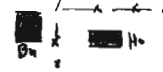

A.C. Browning

A.C. BROWNING  
IRRIGATION WATER RIGHT IN  
SEC'S 3 AND 4, T.4.S.R.8.W.W.M  
TILLAMOOK COUNTY, OREGON

Scale 1" = 400' Co. Surv.  
July, 1935. W.E. Anderson

App. No. 15969  
Per. No. 11800

SEC 4      3      T.4.S.R.8.W.W.M  
9      10      T.4.S.R.8.W.W.M

1-16-15969



OR