


SECTION

5

TOWNSHIP 19 S, RANGE R1E, W. M.

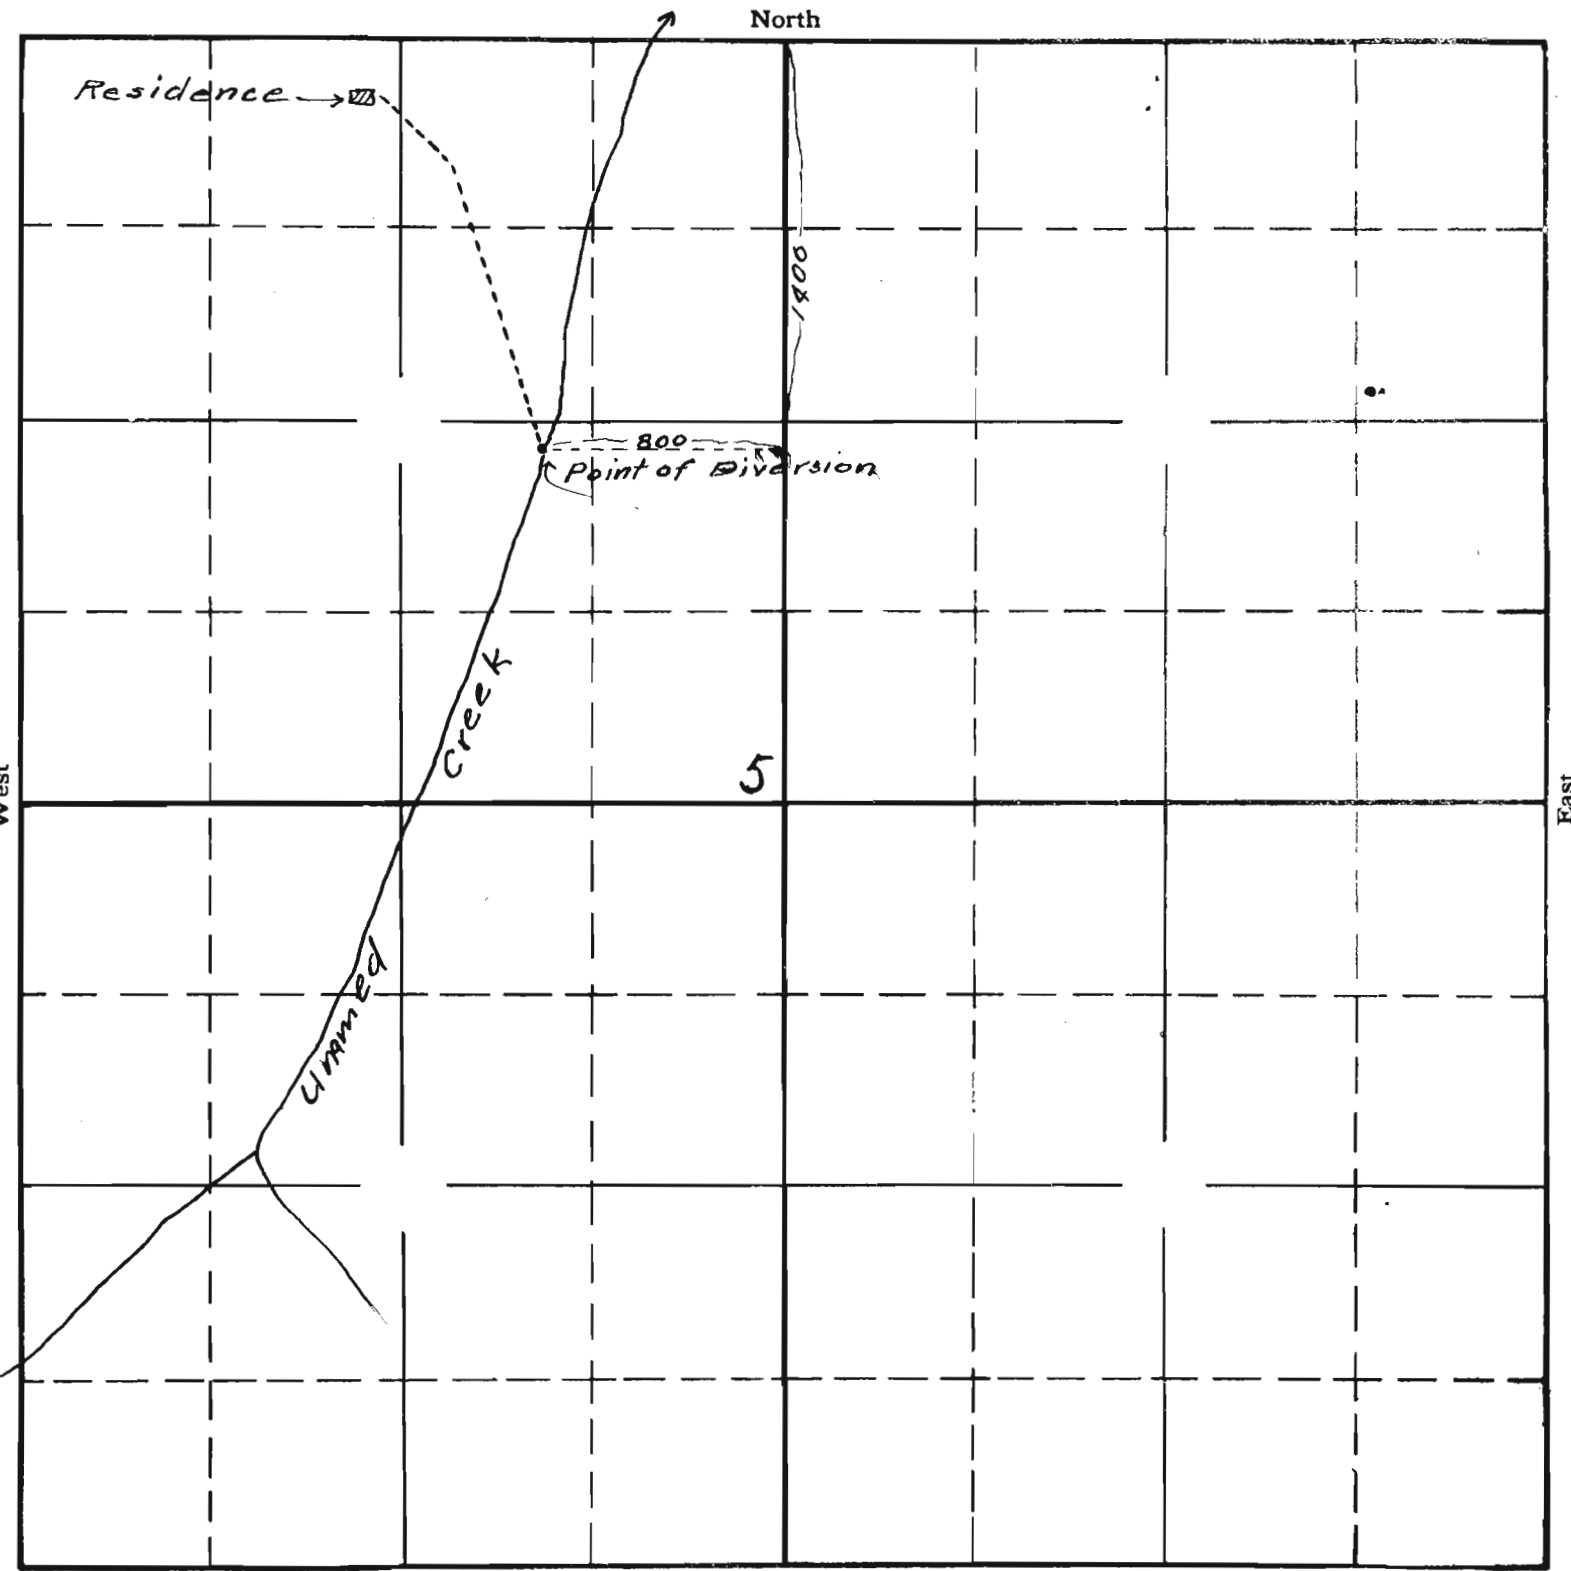


RECEIVED
 JUN 15 1985

APPLICATION No. 15985
 PERMIT No. 11810

SECTION

TOWNSHIP 19S, RANGE 1E, W. M.

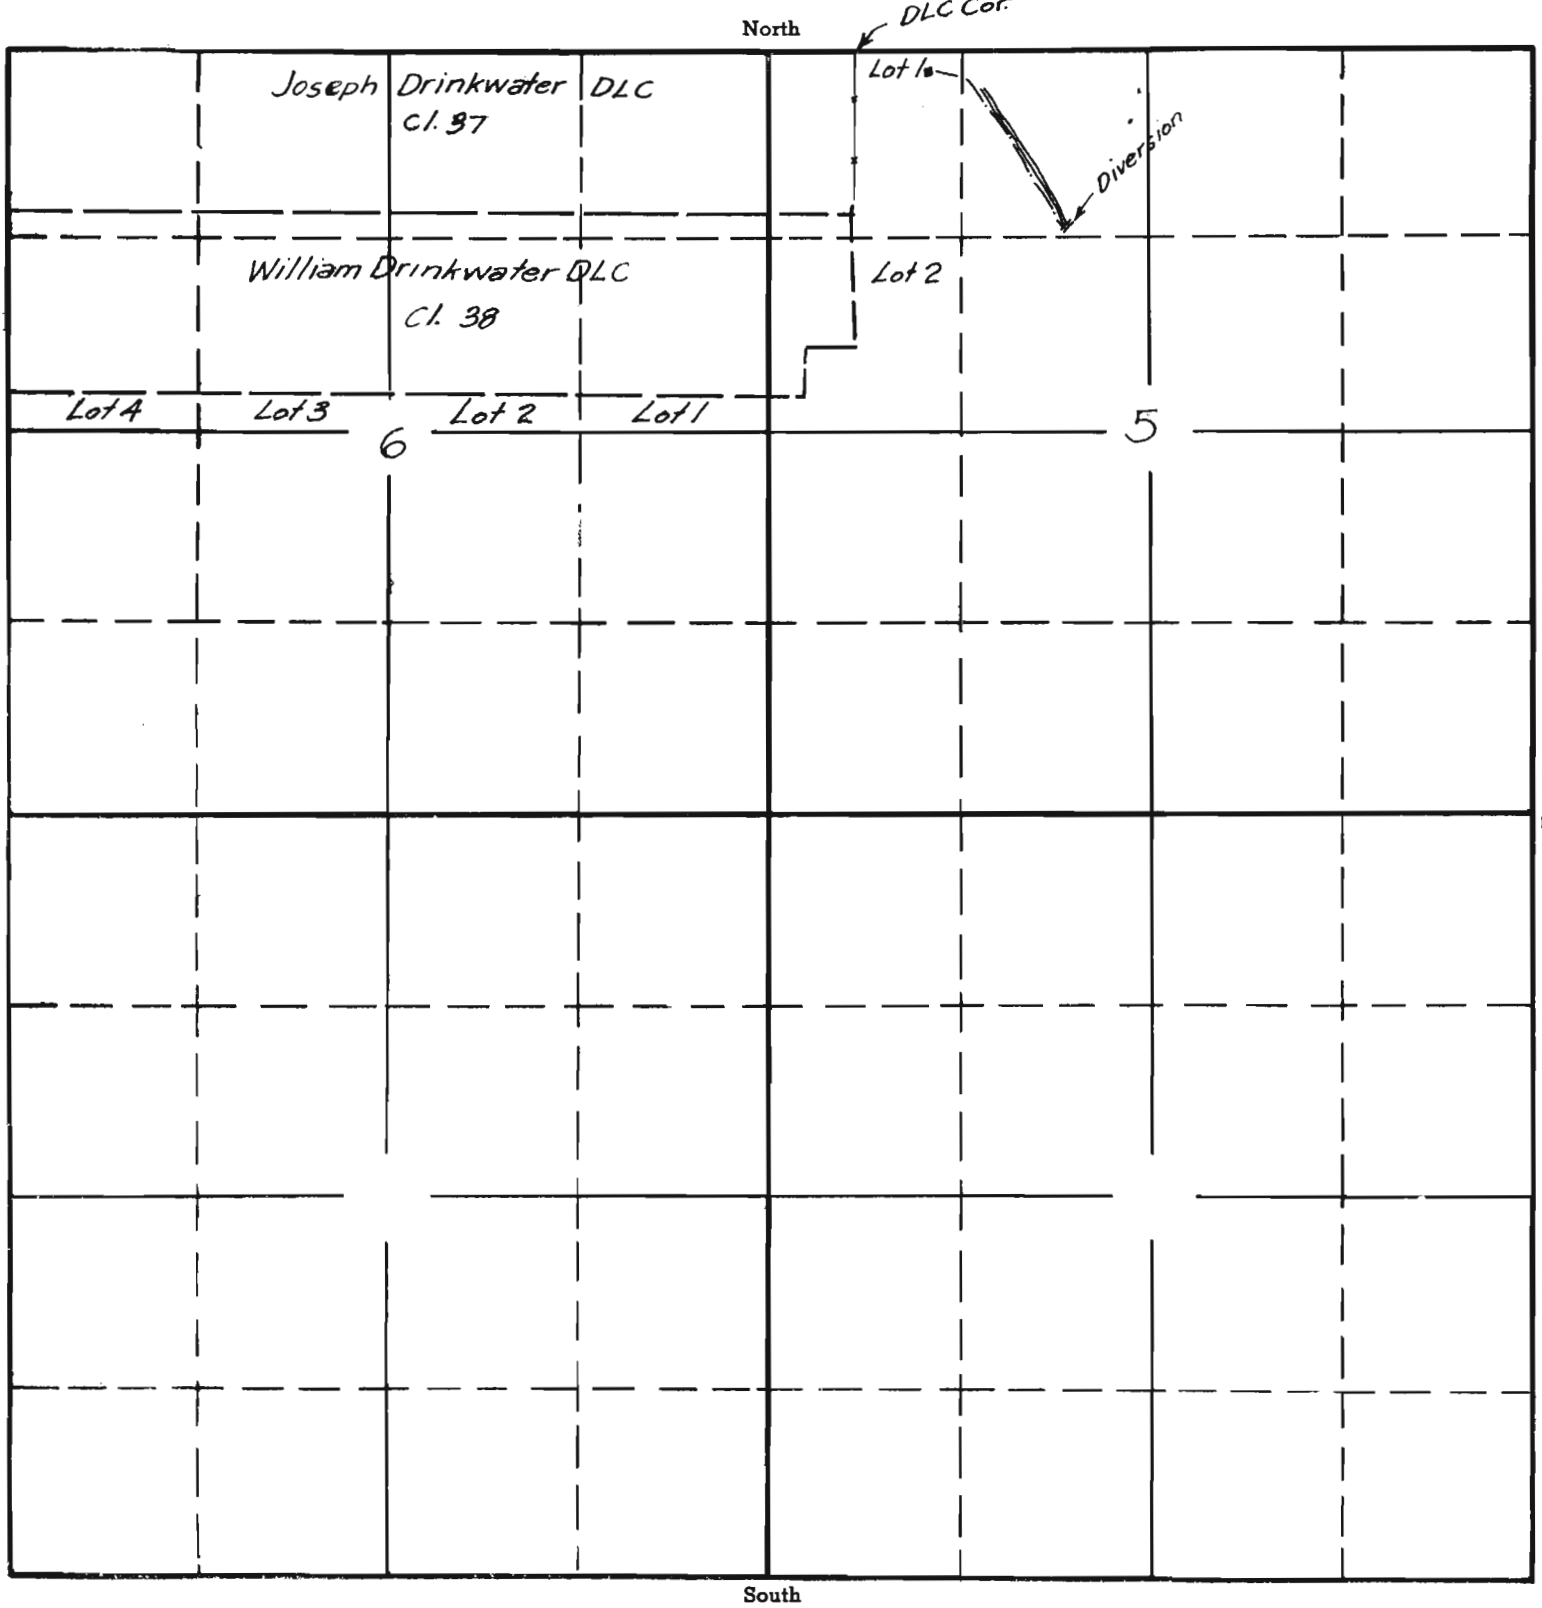

APPLICATION No. 15985
PERMIT No. 11810