


SECTION

TOWNSHIP 3 S , RANGE 1 E , W. M.

North

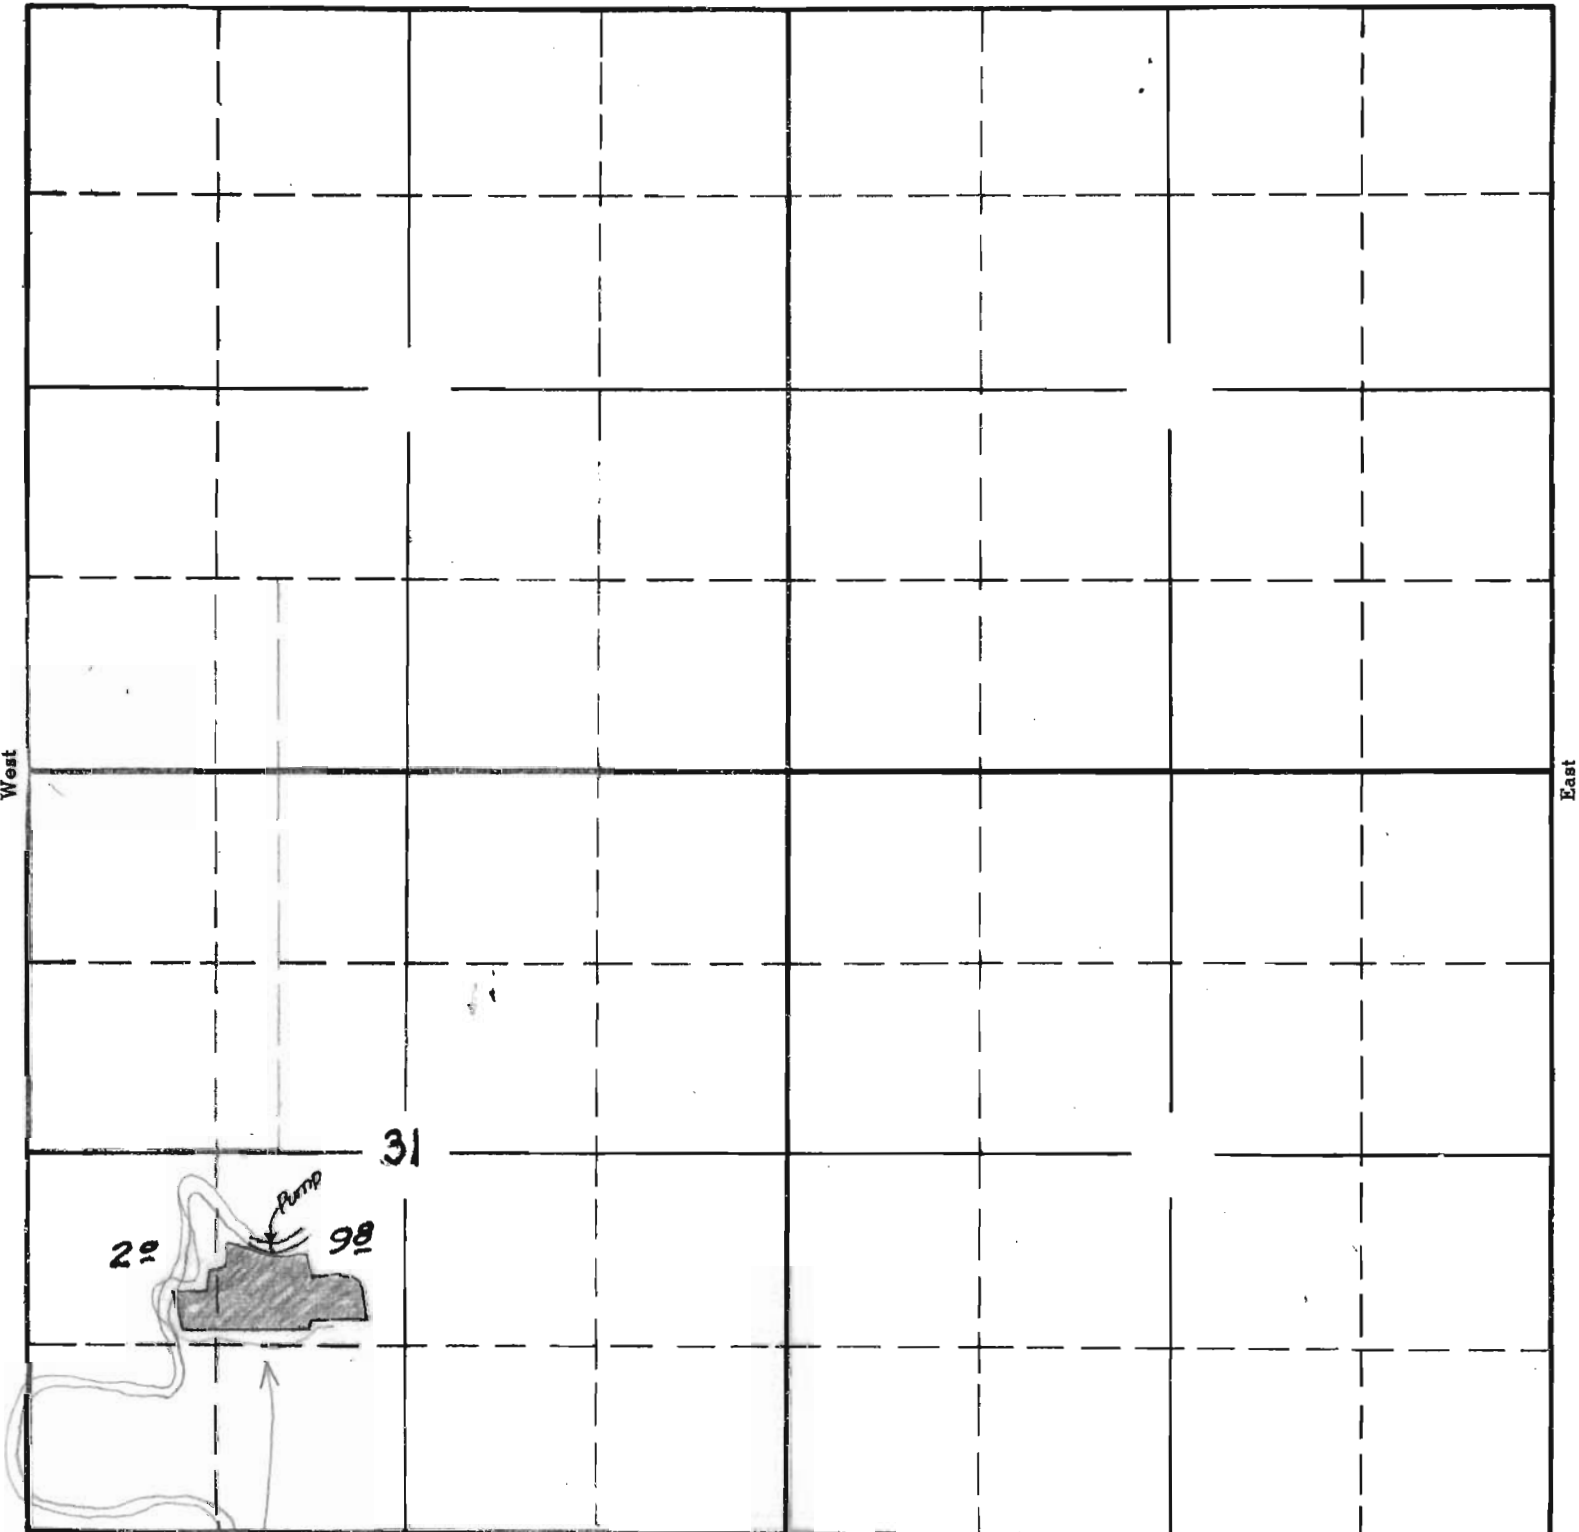

20 Pump 98

31


South

Correct Location

APPLICATION No. 15998
PERMIT No. 11819

SECTION

TOWNSHIP 35, RANGE 1E, W. M.

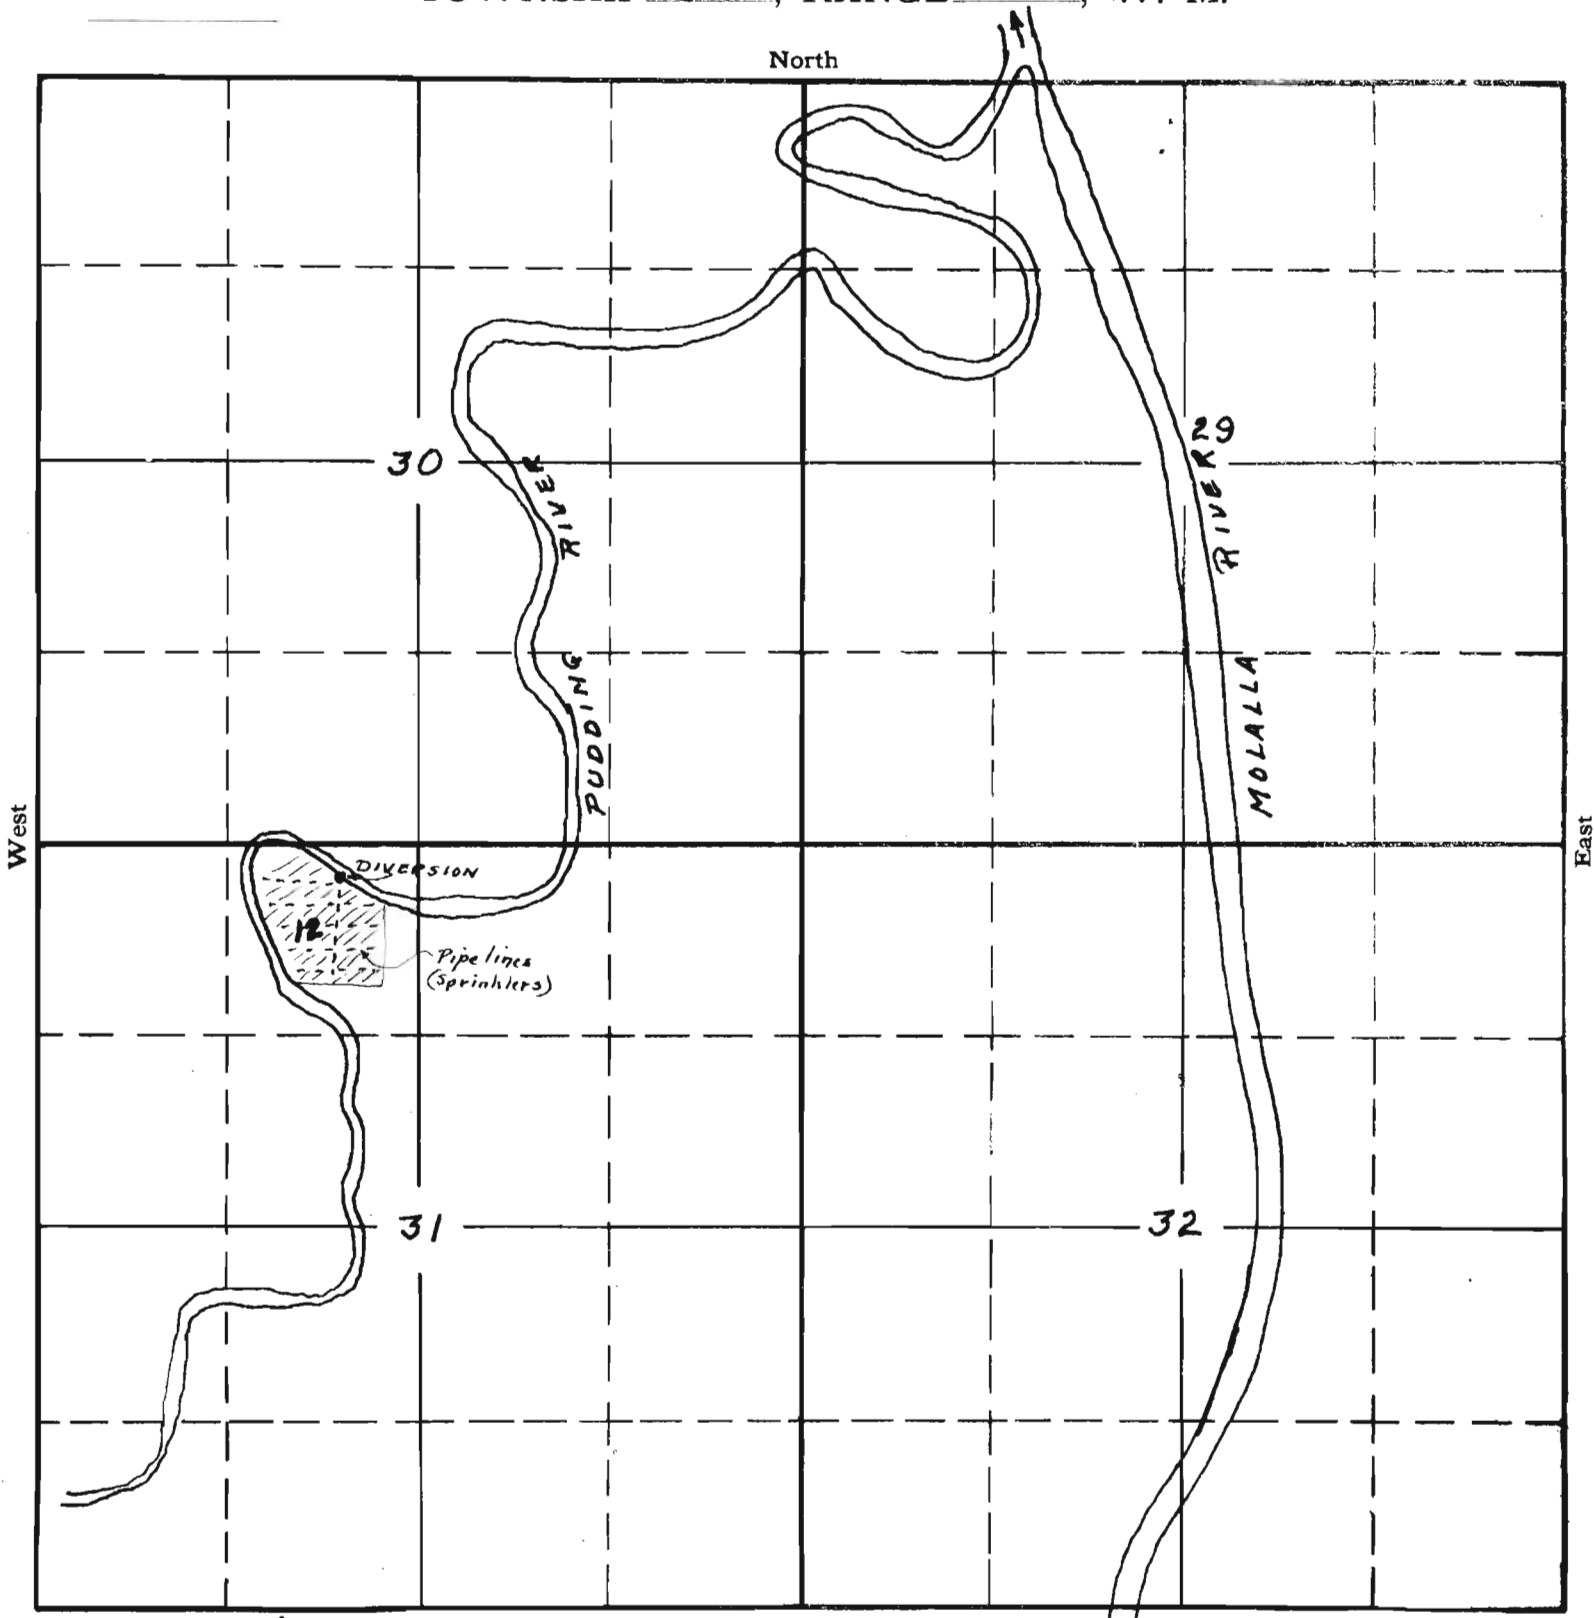

Copied from applicant's sketch - 8/19/35-

South

2-33-OK

APPLICATION No. 15998

PERMIT No. 11819