


SECTION

13

24

TOWNSHIP 10S, RANGE 2W, W. M.

North

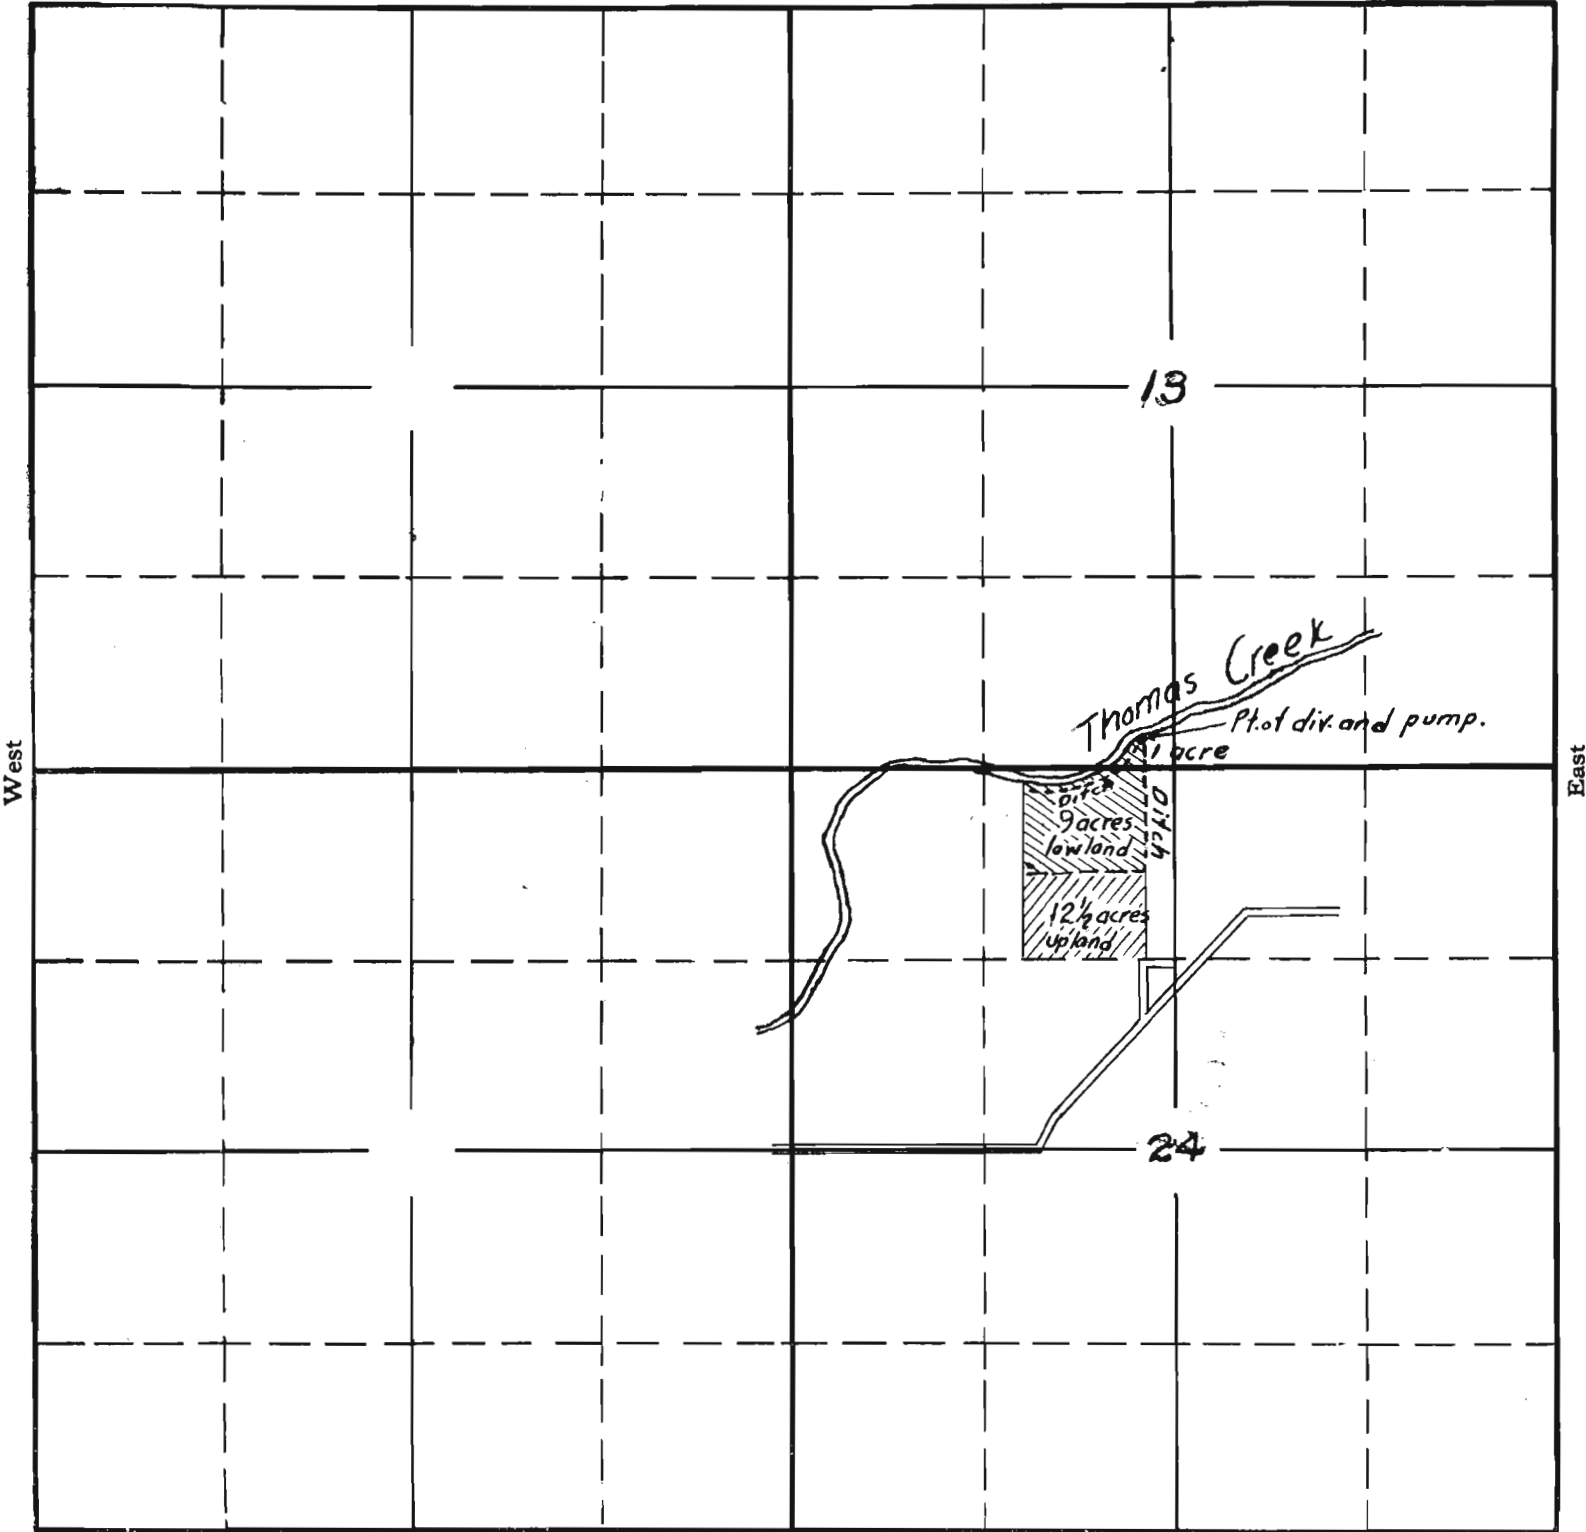


South

2-51-16008-OK
APPLICATION No. 16008
PERMIT No. 11823

SECTION

TOWNSHIP 105, RANGE 2W, W. M.

North

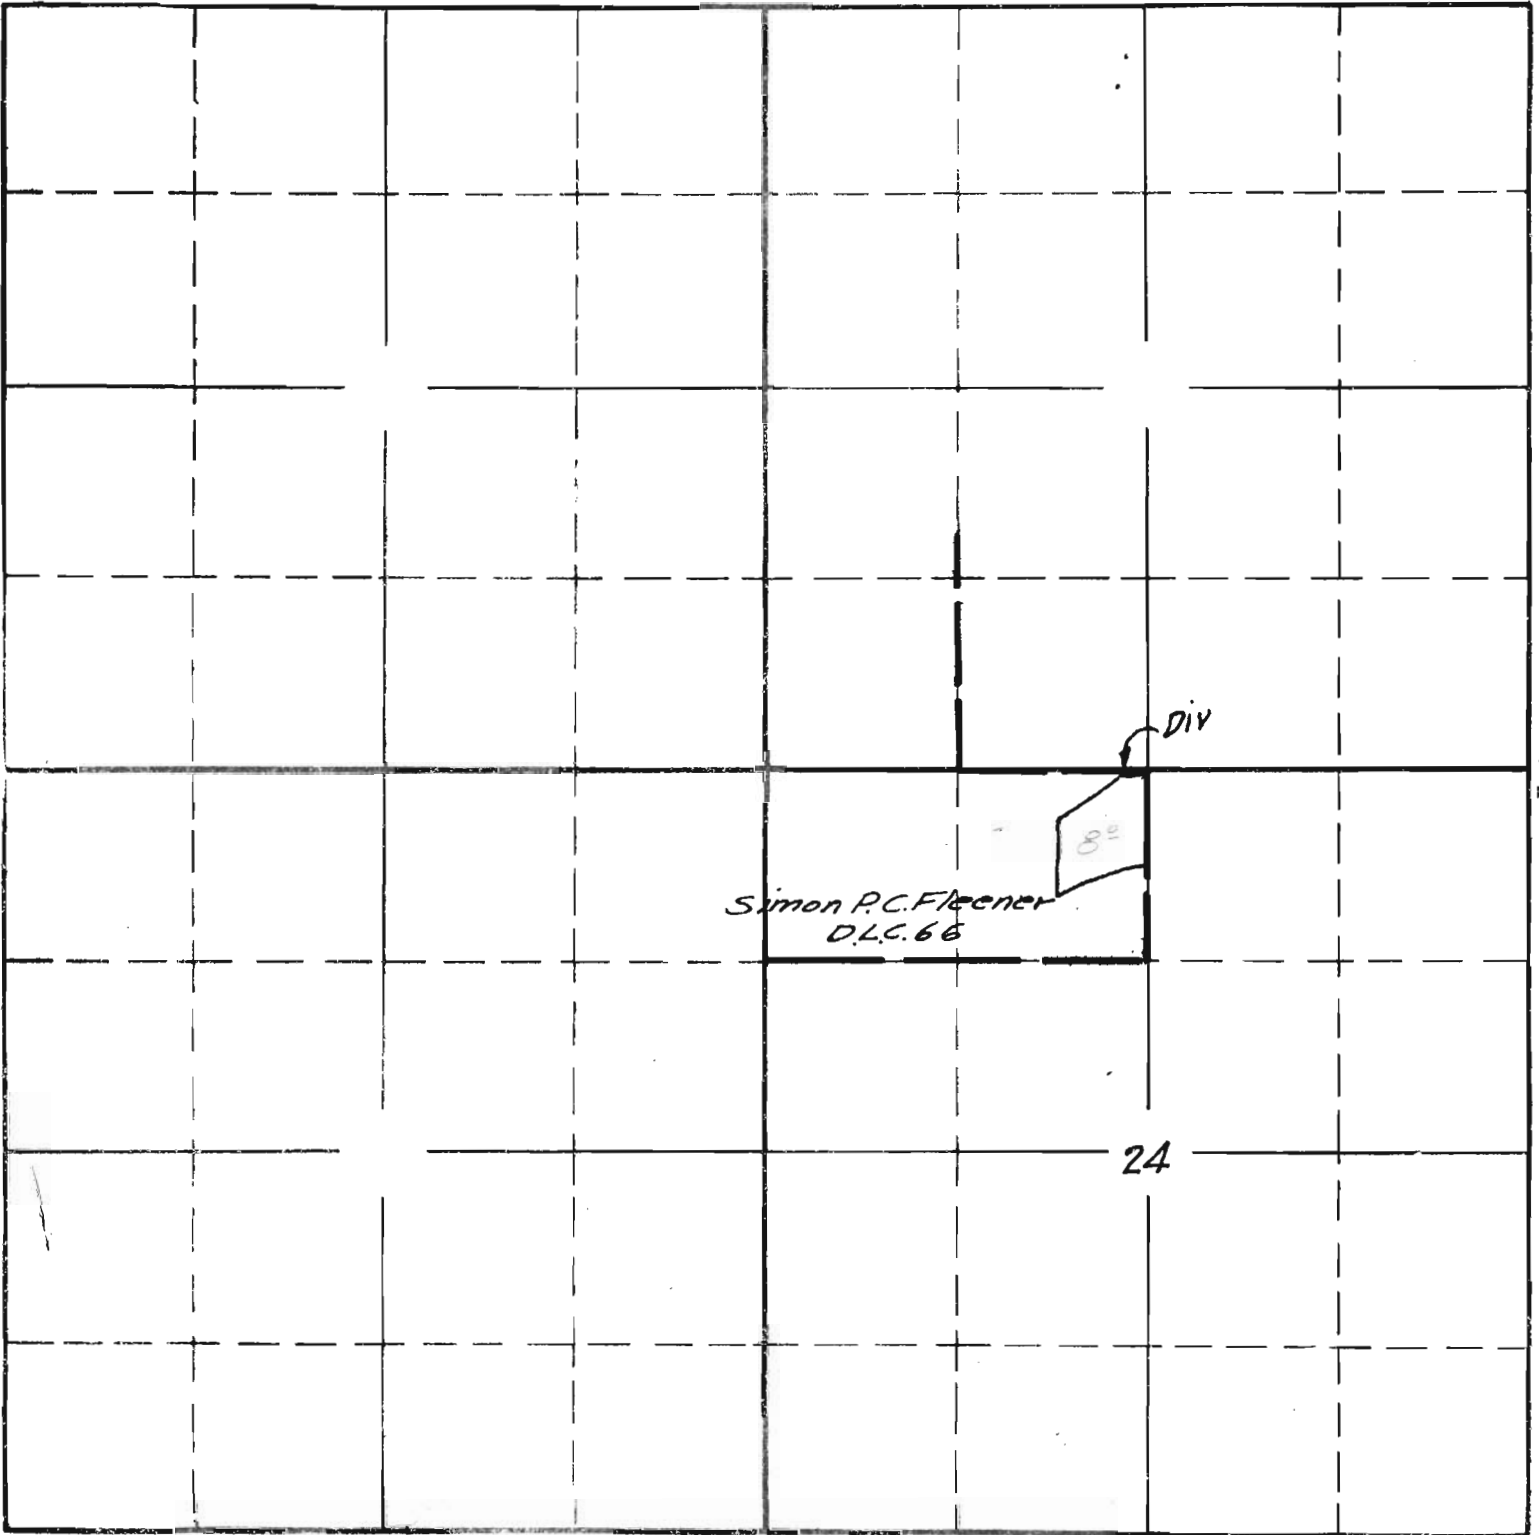

West

East

24

Surveyed May 29 1940 C.A.C.

South

APPLICATION No. 16008
PERMIT No. 11823