


SECTION

TOWNSHIP 85, RANGE 46E, W. M.

North

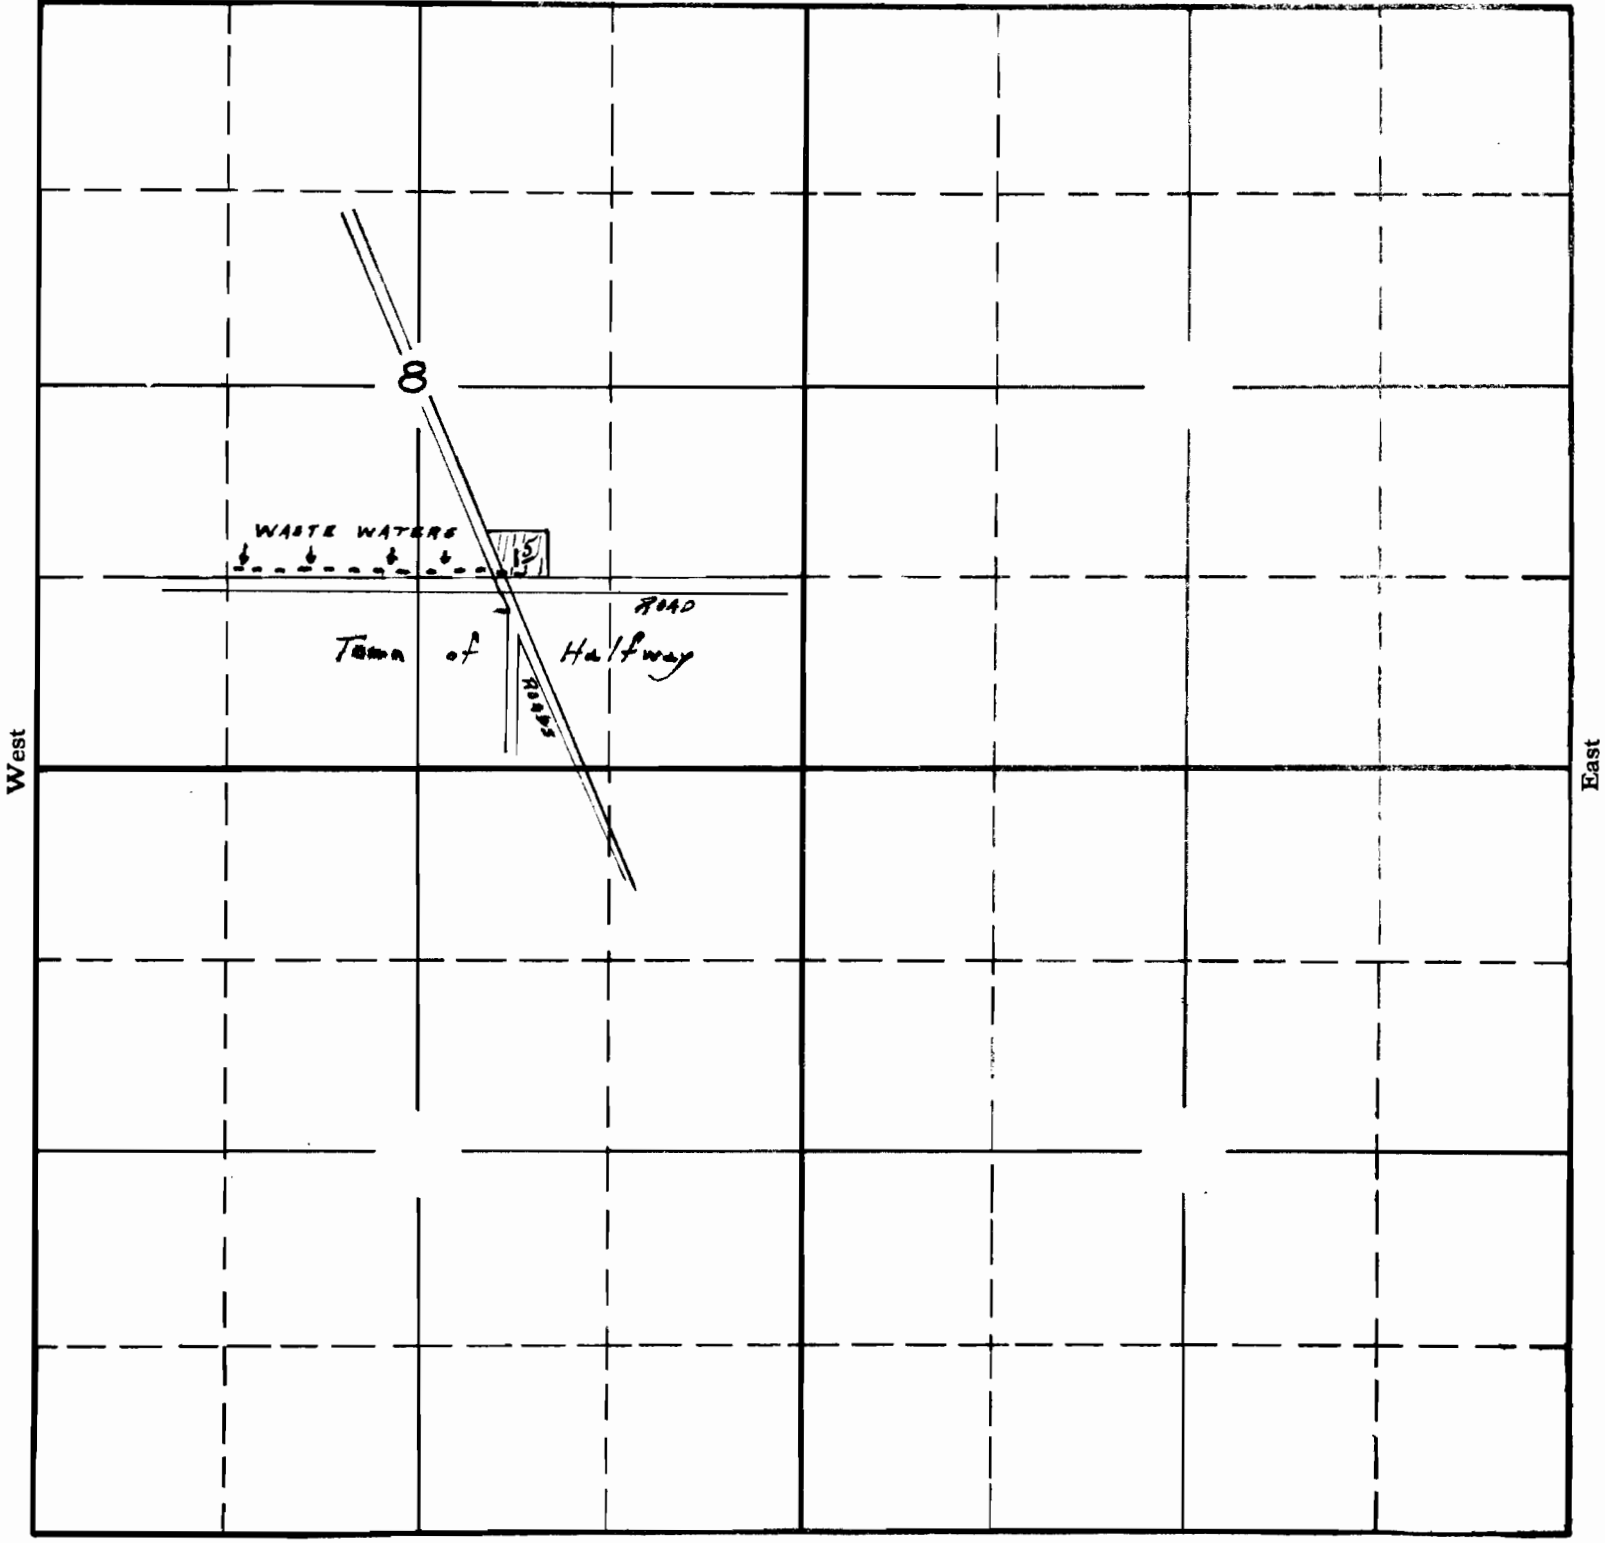

South

APPLICATION No. 15991
PERMIT No. 11834