


Section

31

Township 36 S. R. 14 W. W. M. r

Pipeline 50'

North

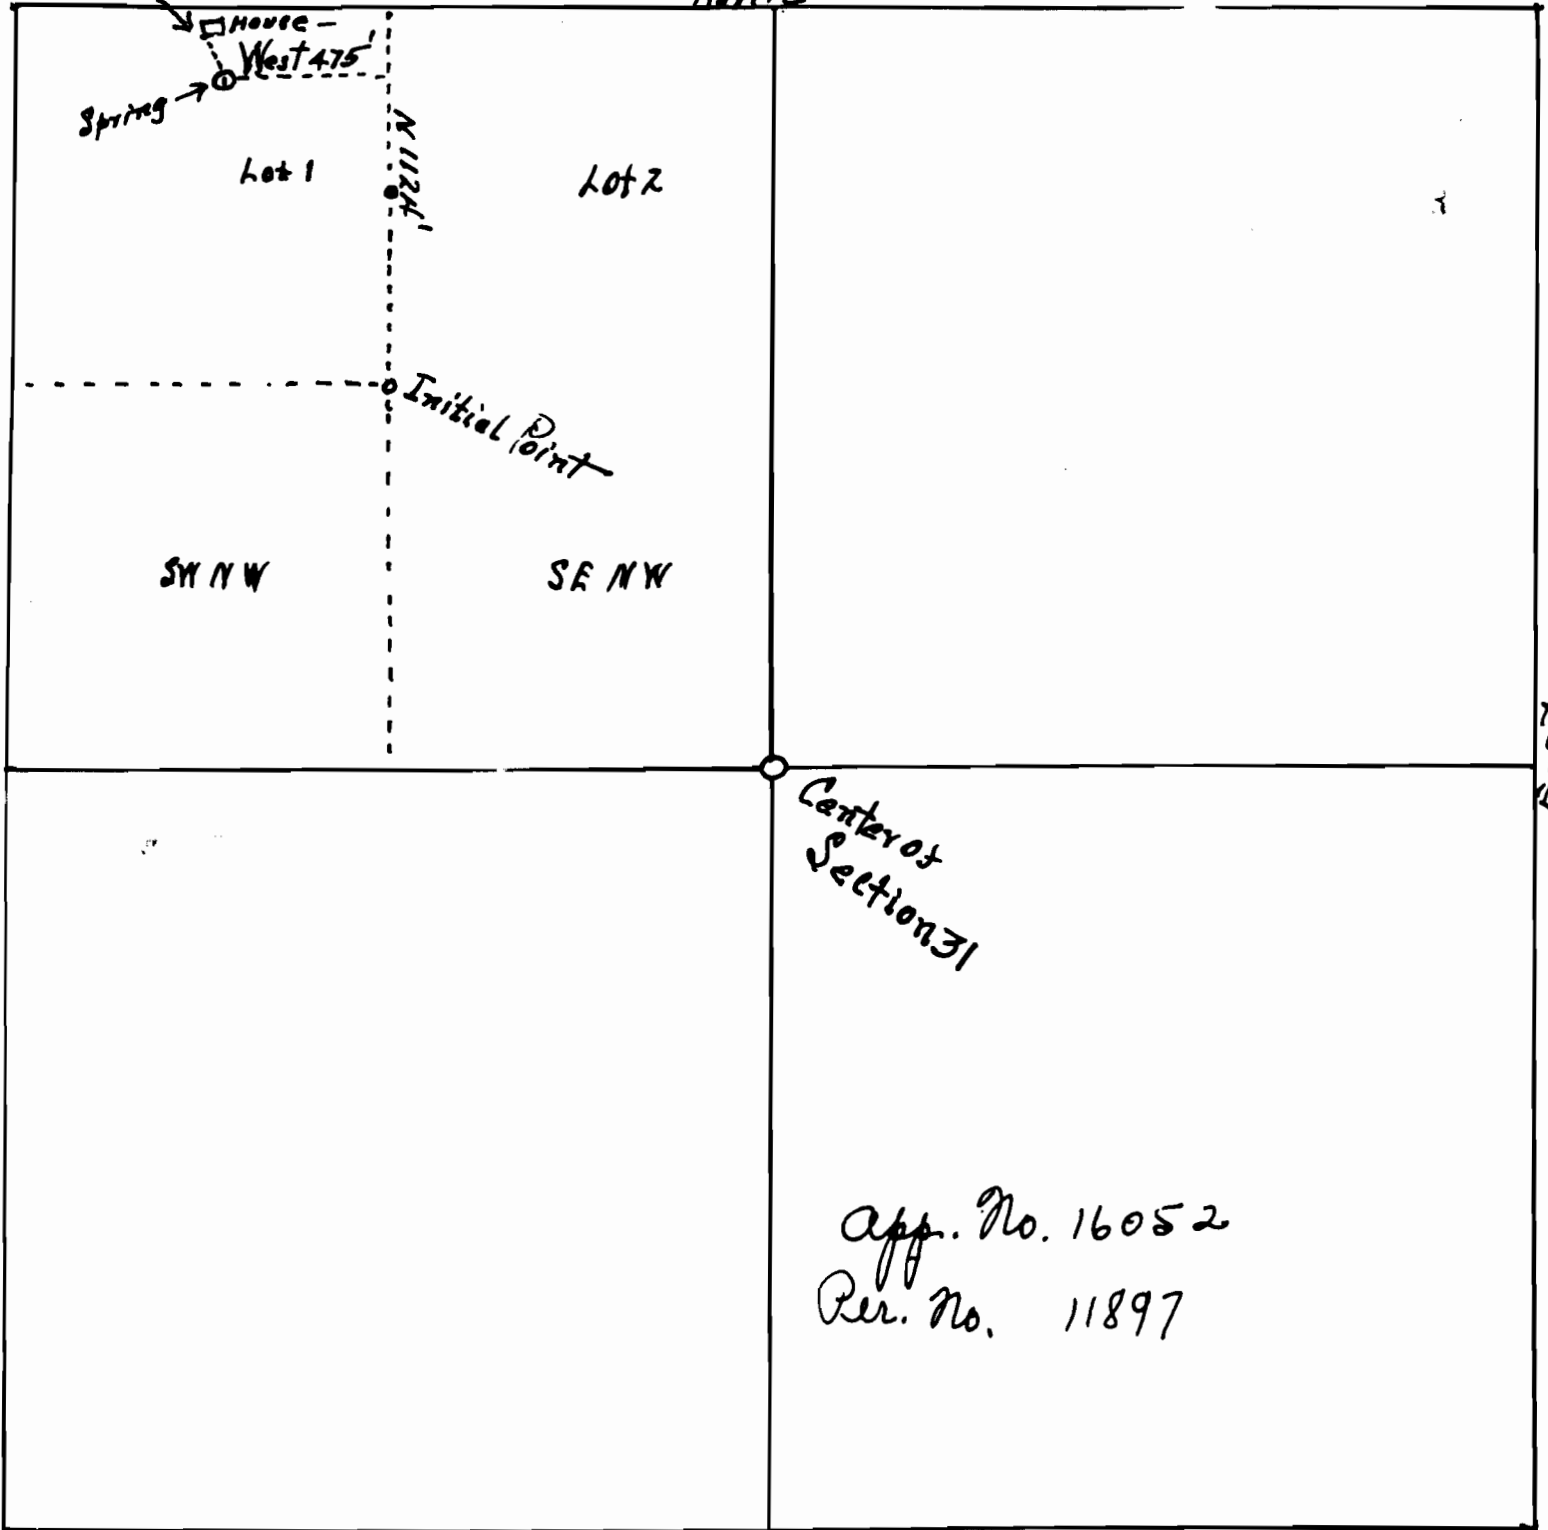

Scale 1" = 660'

South