

SECTION


31

TOWNSHIP 35S, RANGE 1W, W. M.

North

West

East

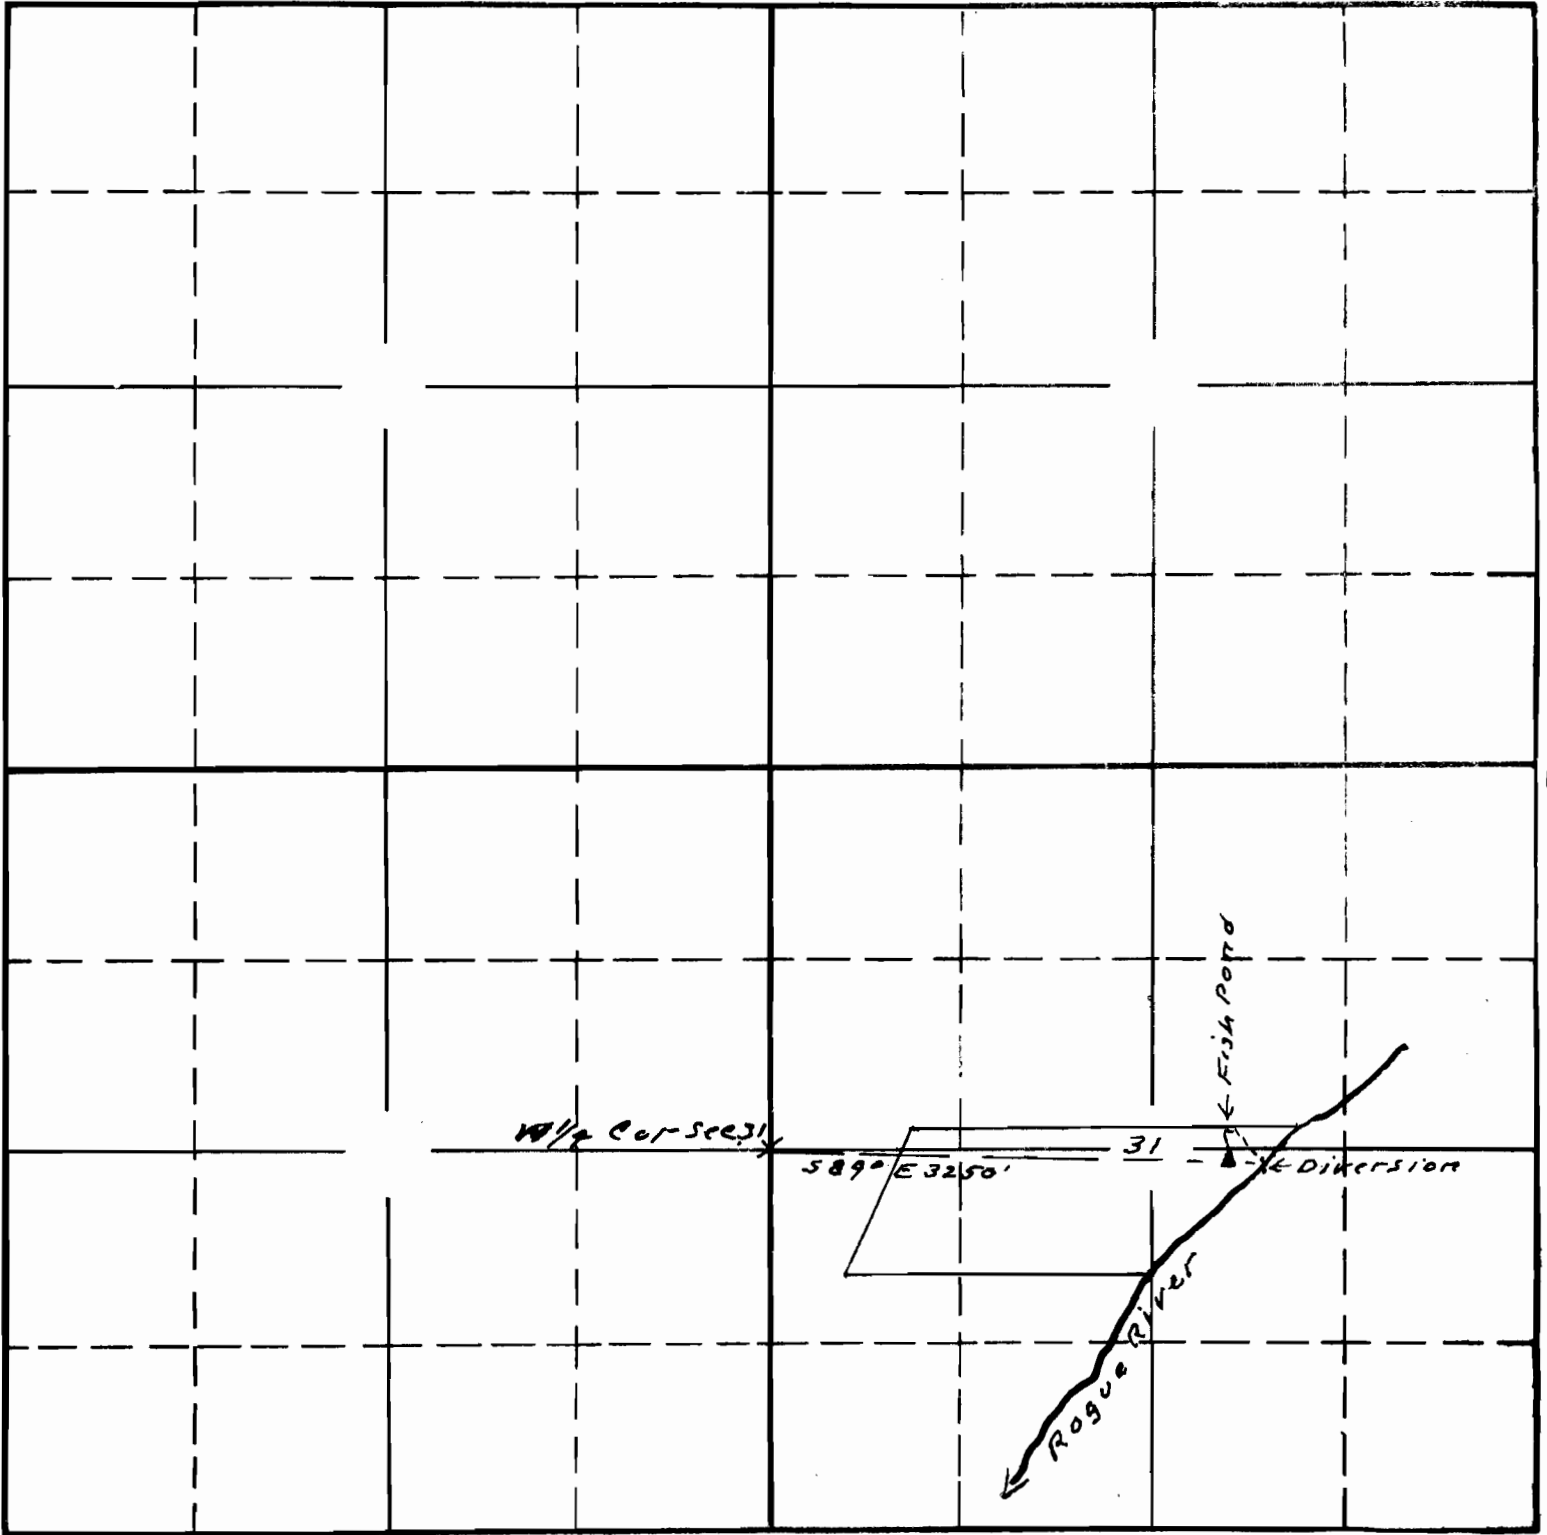

Sketch showing location of South diversion and use, to accompany application of Albert C Allen.

APPLICATION No. 16081
 PERMIT No. 11905