


SECTION 32

TOWNSHIP 29S, RANGE 12, W. M.

North

West

East

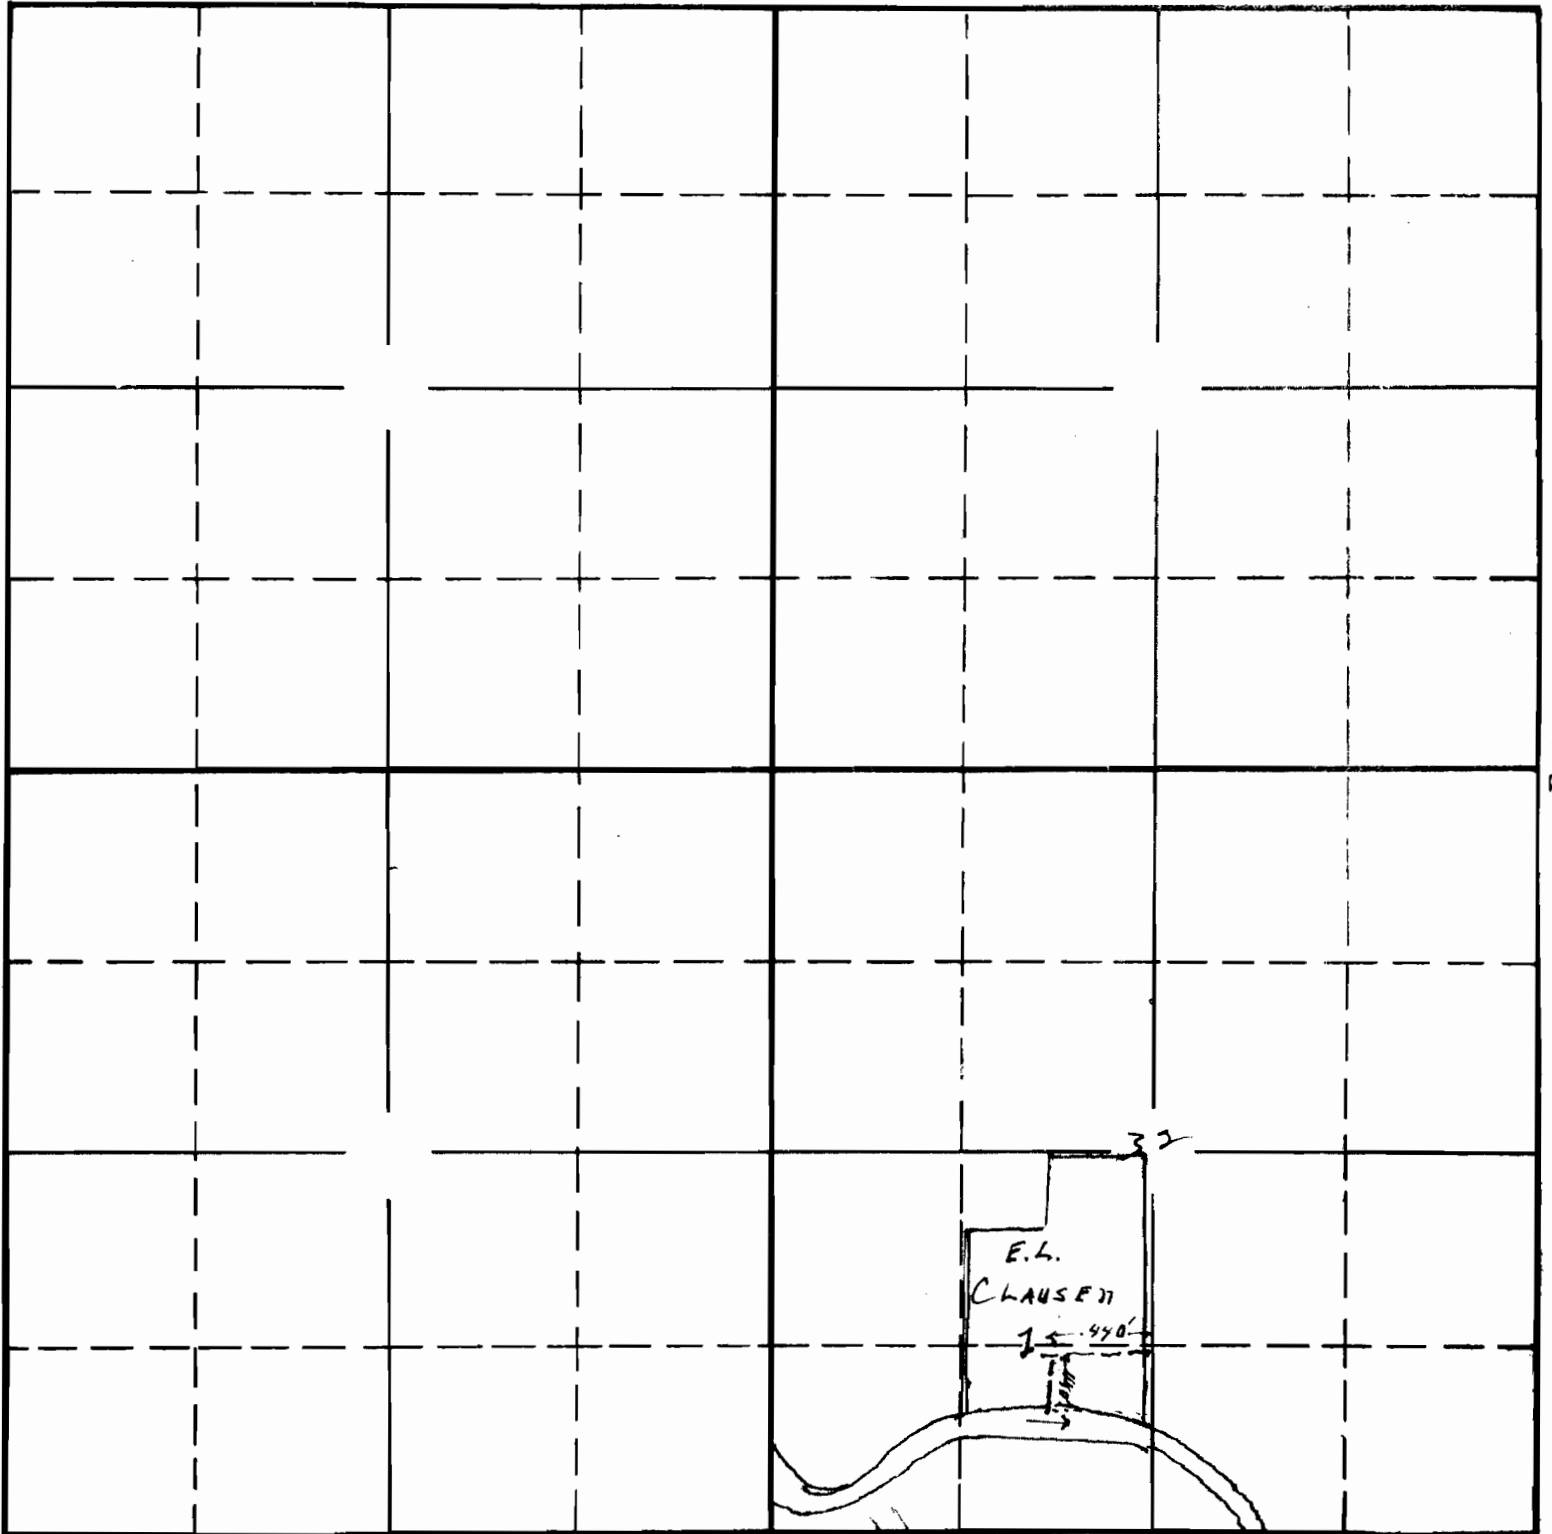

South

APPLICATION No. 16094

PERMIT No. 11914