


SECTION 8

TOWNSHIP 36.S, RANGE 14.W, W. M.

North

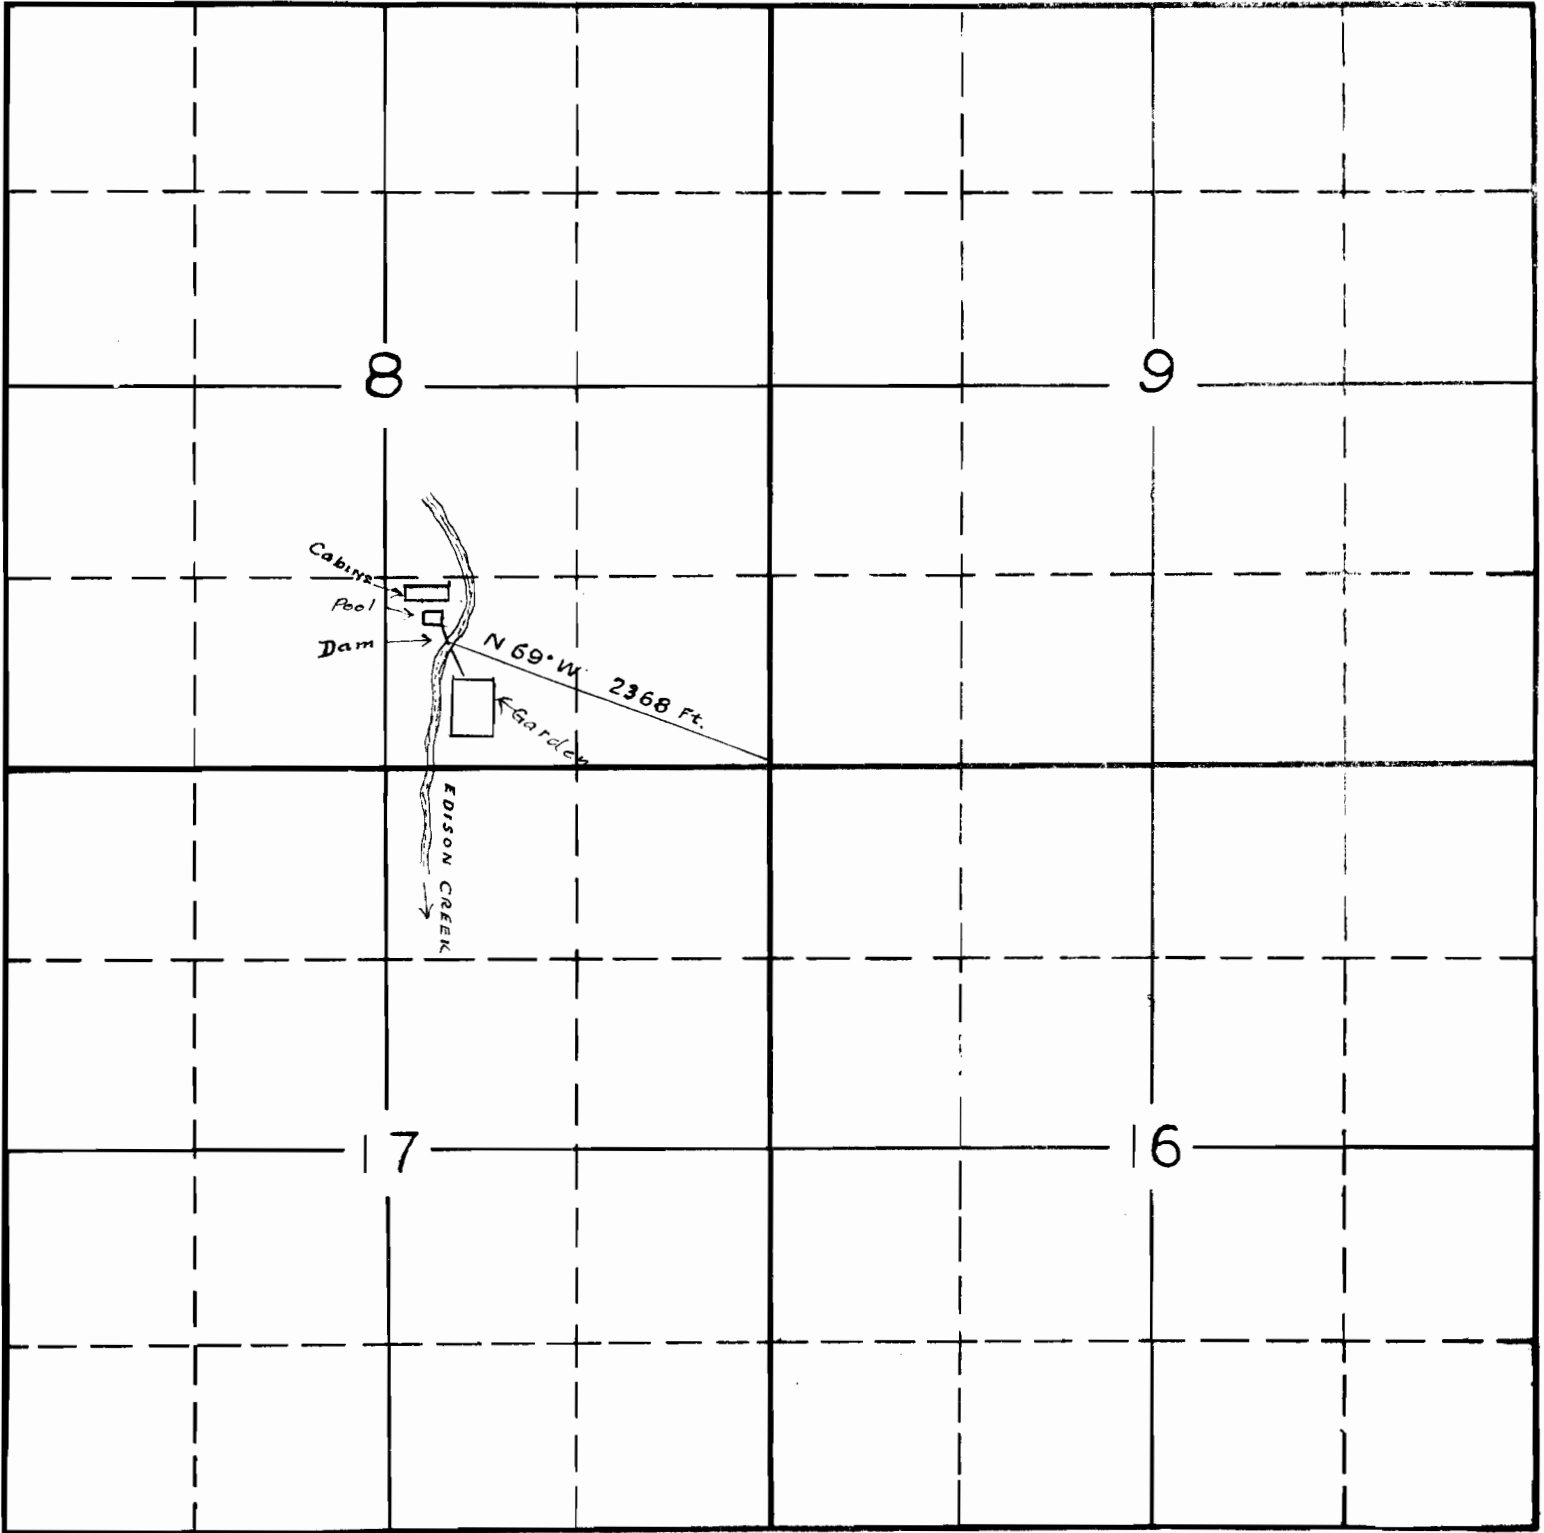

South

APPLICATION No. 16096  
PERMIT No. 11916