


SECTION

TOWNSHIP 45, RANGE 14E, W. M.

North

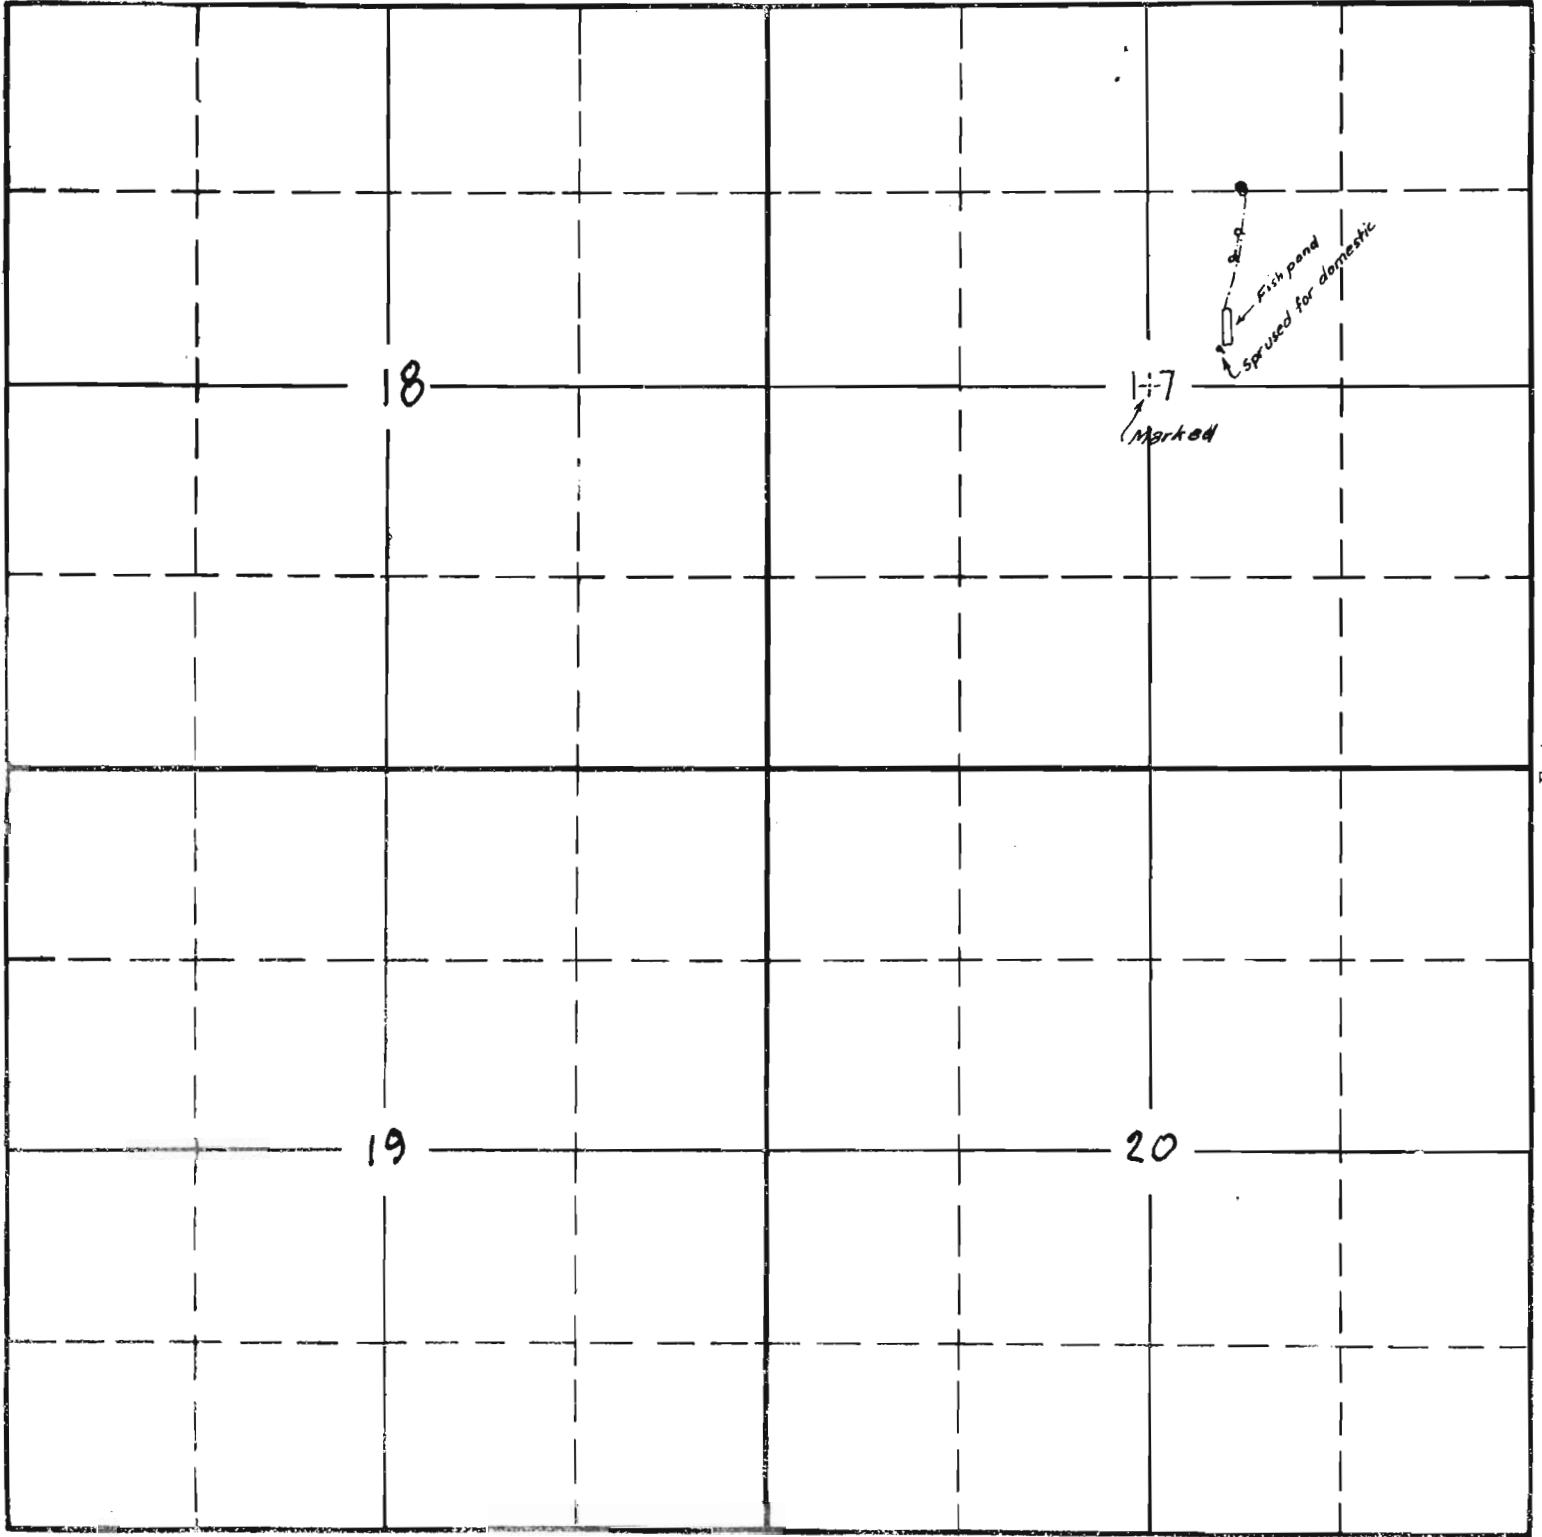


South

APPLICATION No. { 16131
 { 16232
PERMIT No. { 11936
 { 12051

SECTION

TOWNSHIP 45, RANGE 14E, W. M.

North

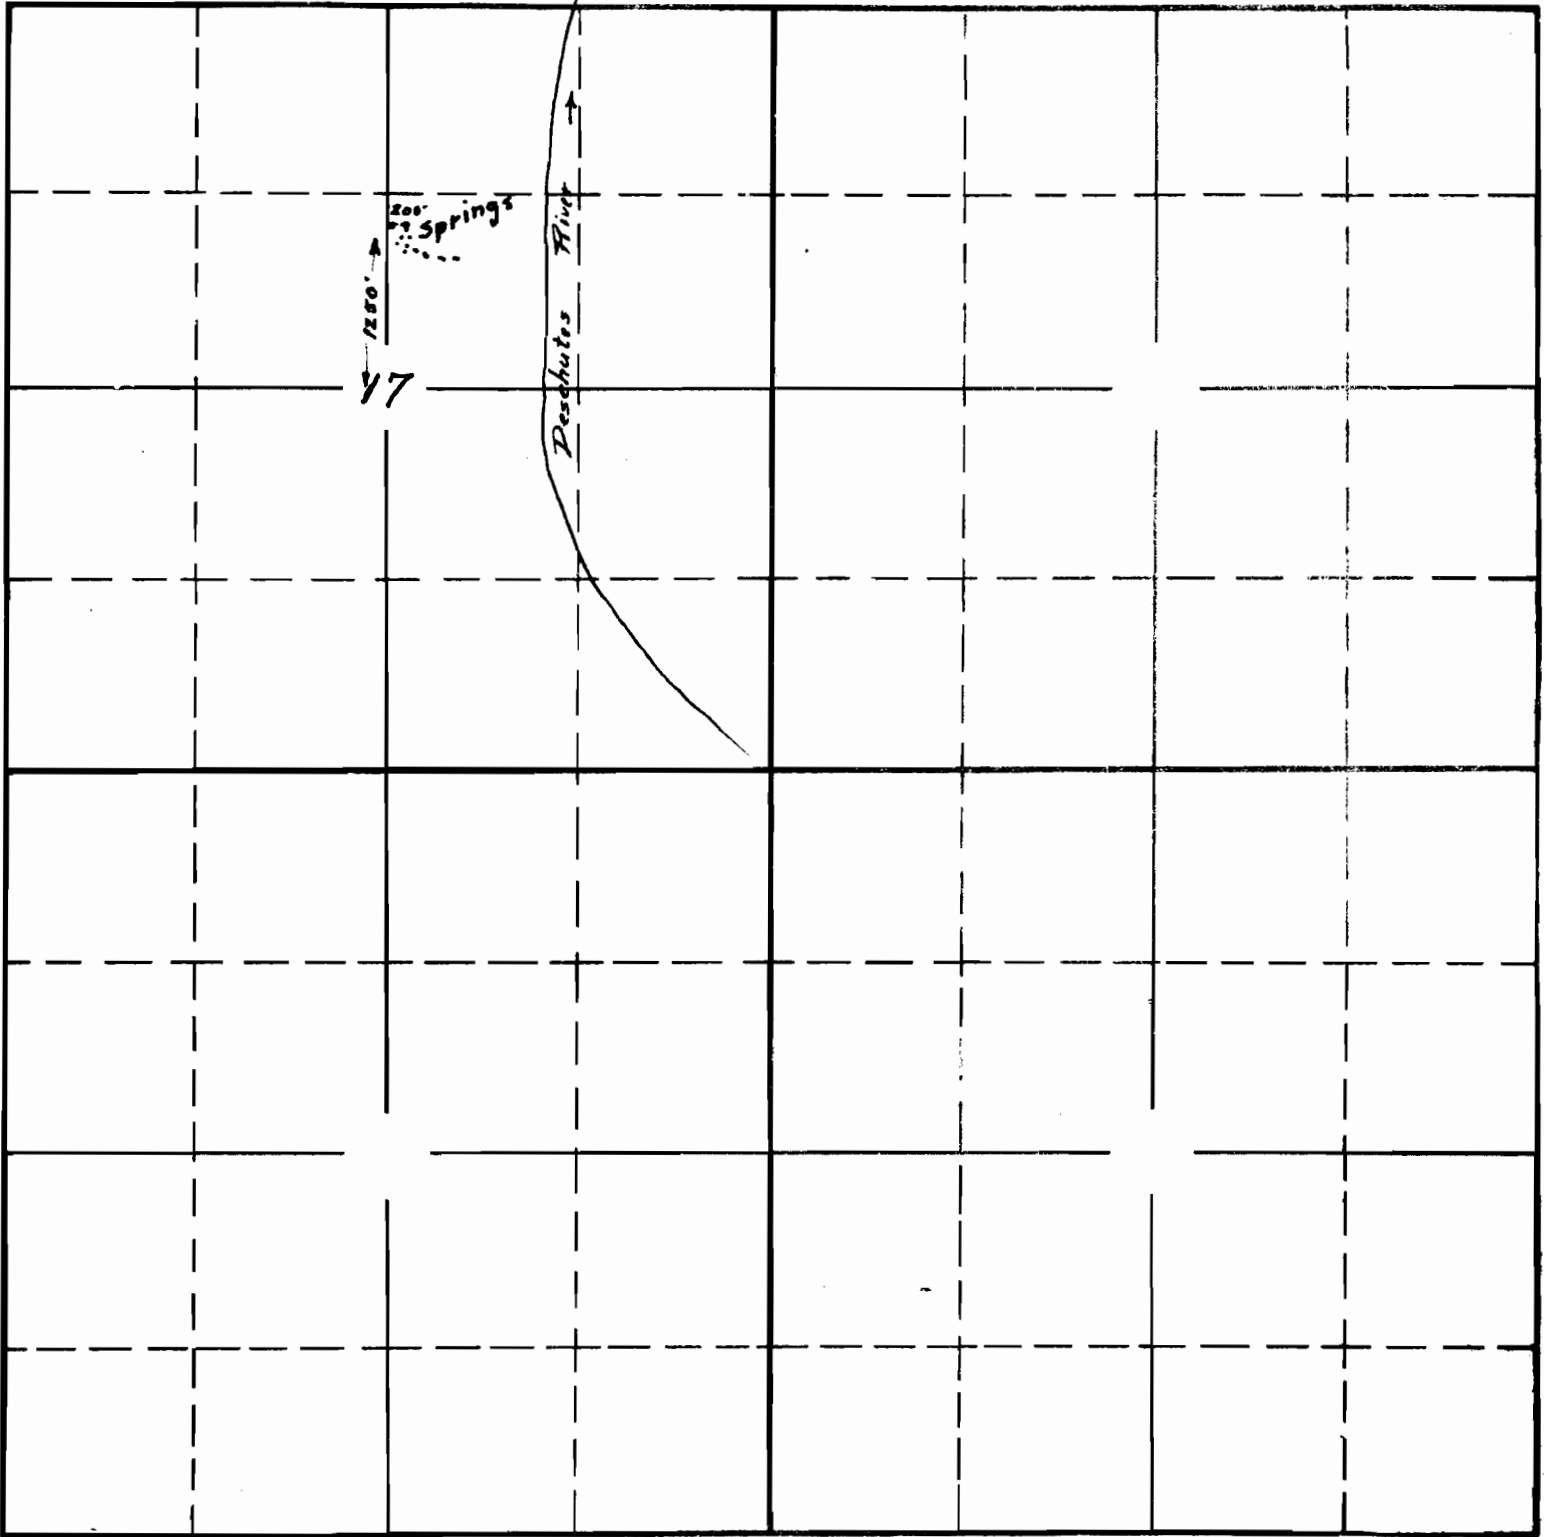

South

5-18-16131-^{OK}
APPLICATION No. 16131
PERMIT No. 11936