


Surveyed June 1 1931  
G.D.G.

APPLICATION No. 16002  
PERMIT No. 11939

TOWNSHIP 45, RANGE 10W, W. M.

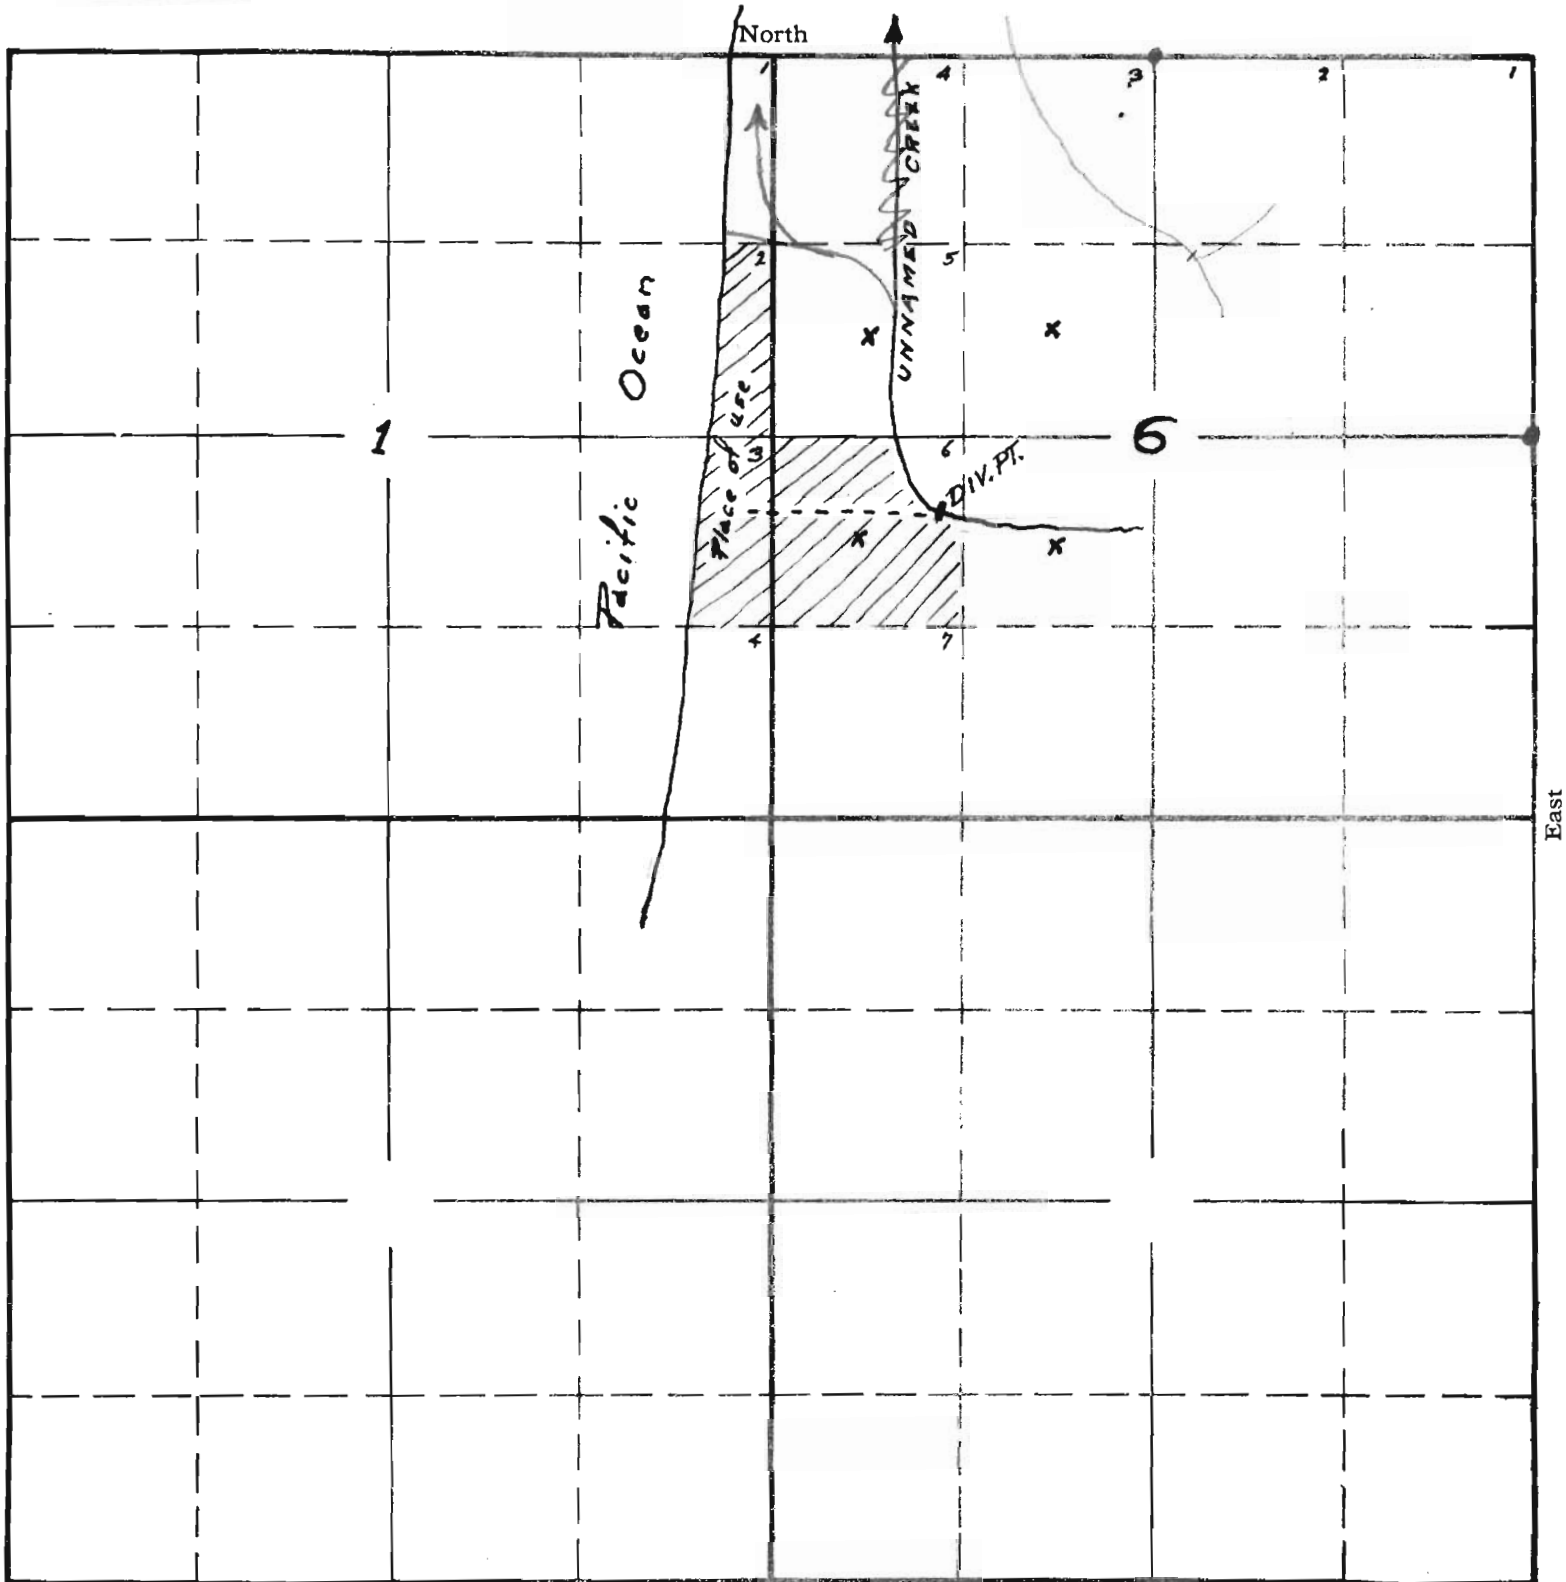

Prepared from applicant's sketch - 11/8/35-

1- 16002  
APPLICATION No. 16002  
PERMIT No. 11939