


27

TOWNSHIP 39S, RANGE 2W, W. M.

North

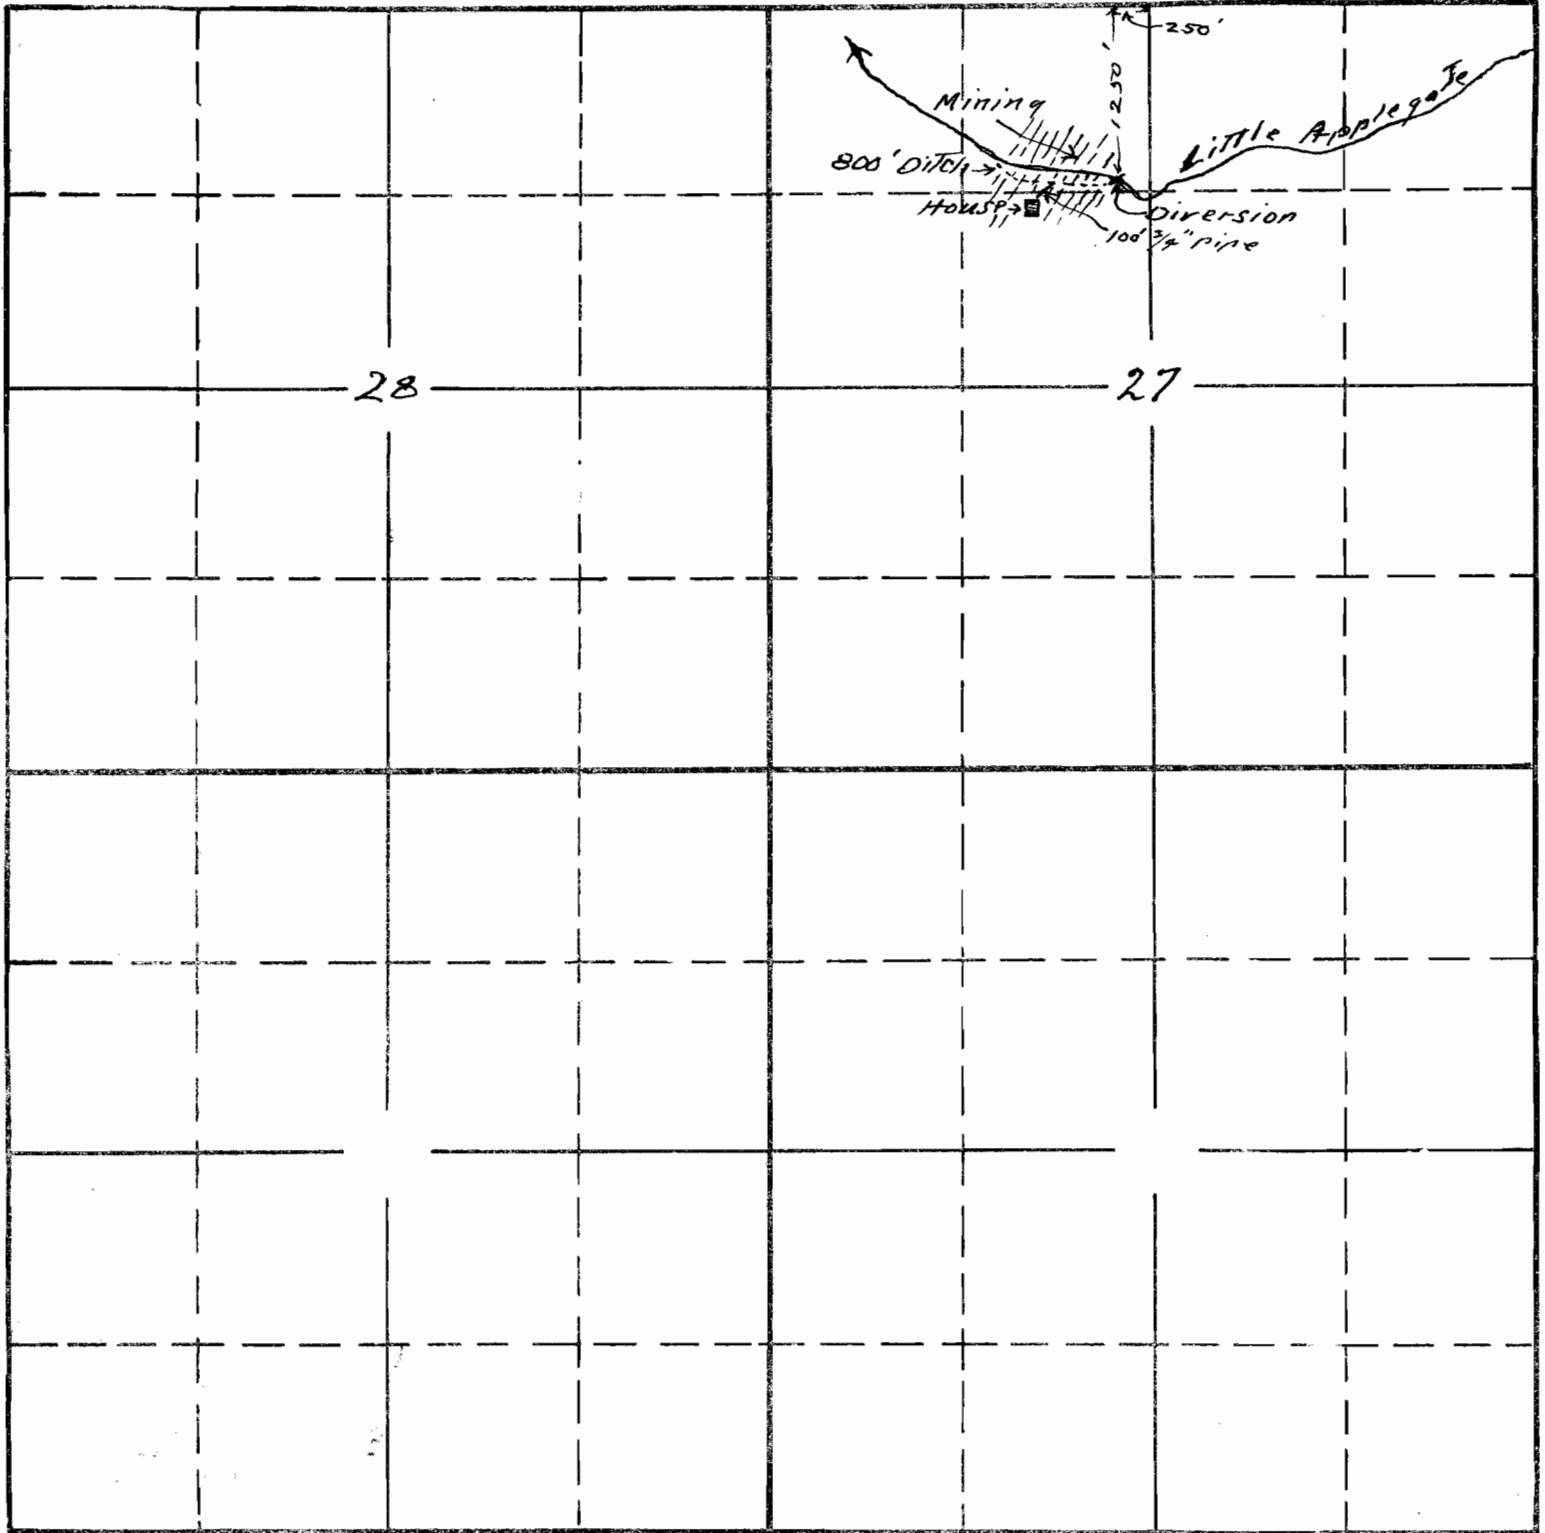

Map to accompany application of
 Chas # Sanger for use of the waters
 of Little Applegate River for mining
 and domestic purposes

APPLICATION No. 16168
 PERMIT No. 11981