


SECTION

TOWNSHIP 25, RANGE 45E, W. M.

North

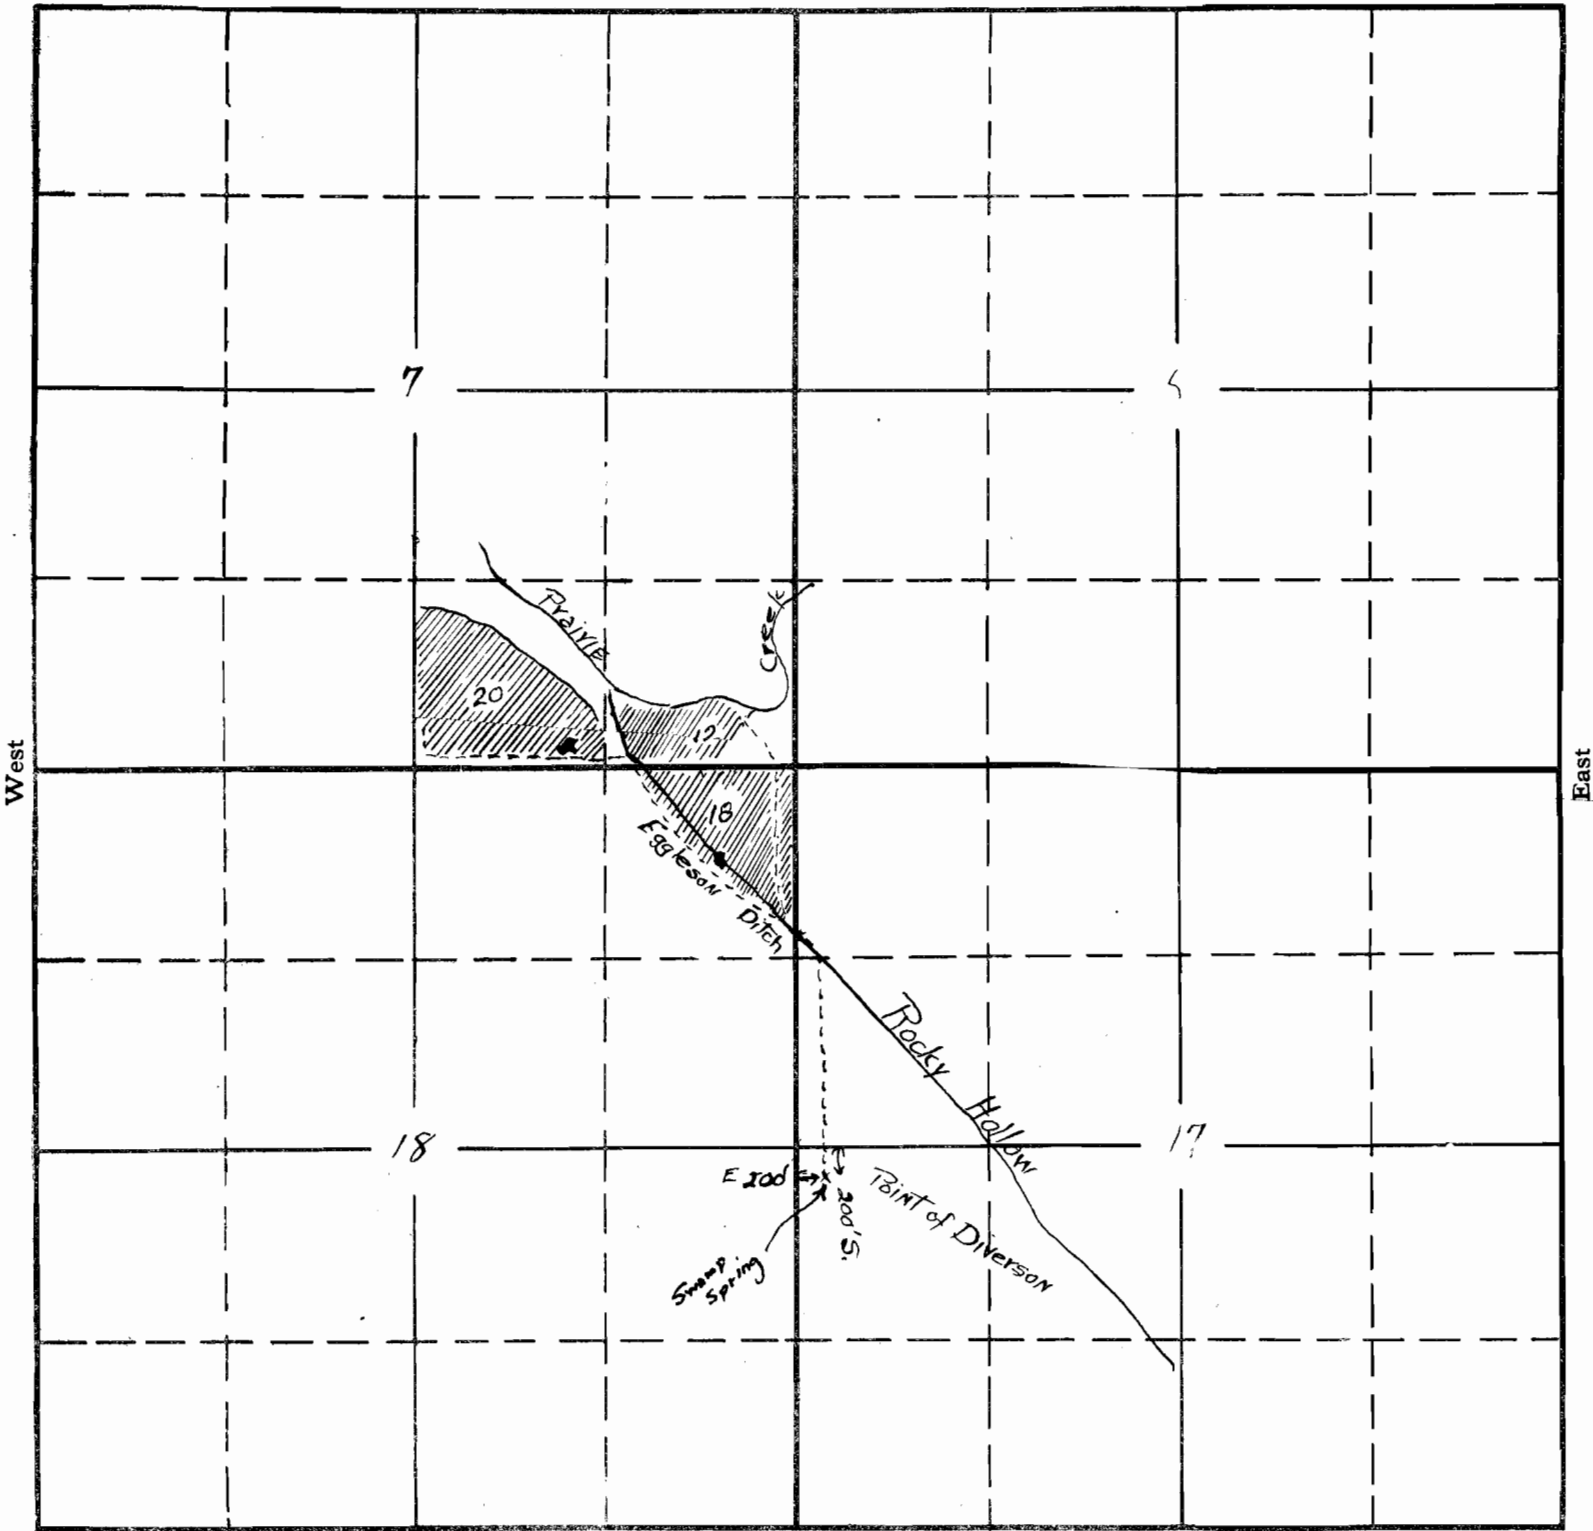

South

8-20 1669
 APPLICATION No. 16169
 PERMIT No. 11982