


T. 45, R. 39E.

App. 16193
Per. 12010

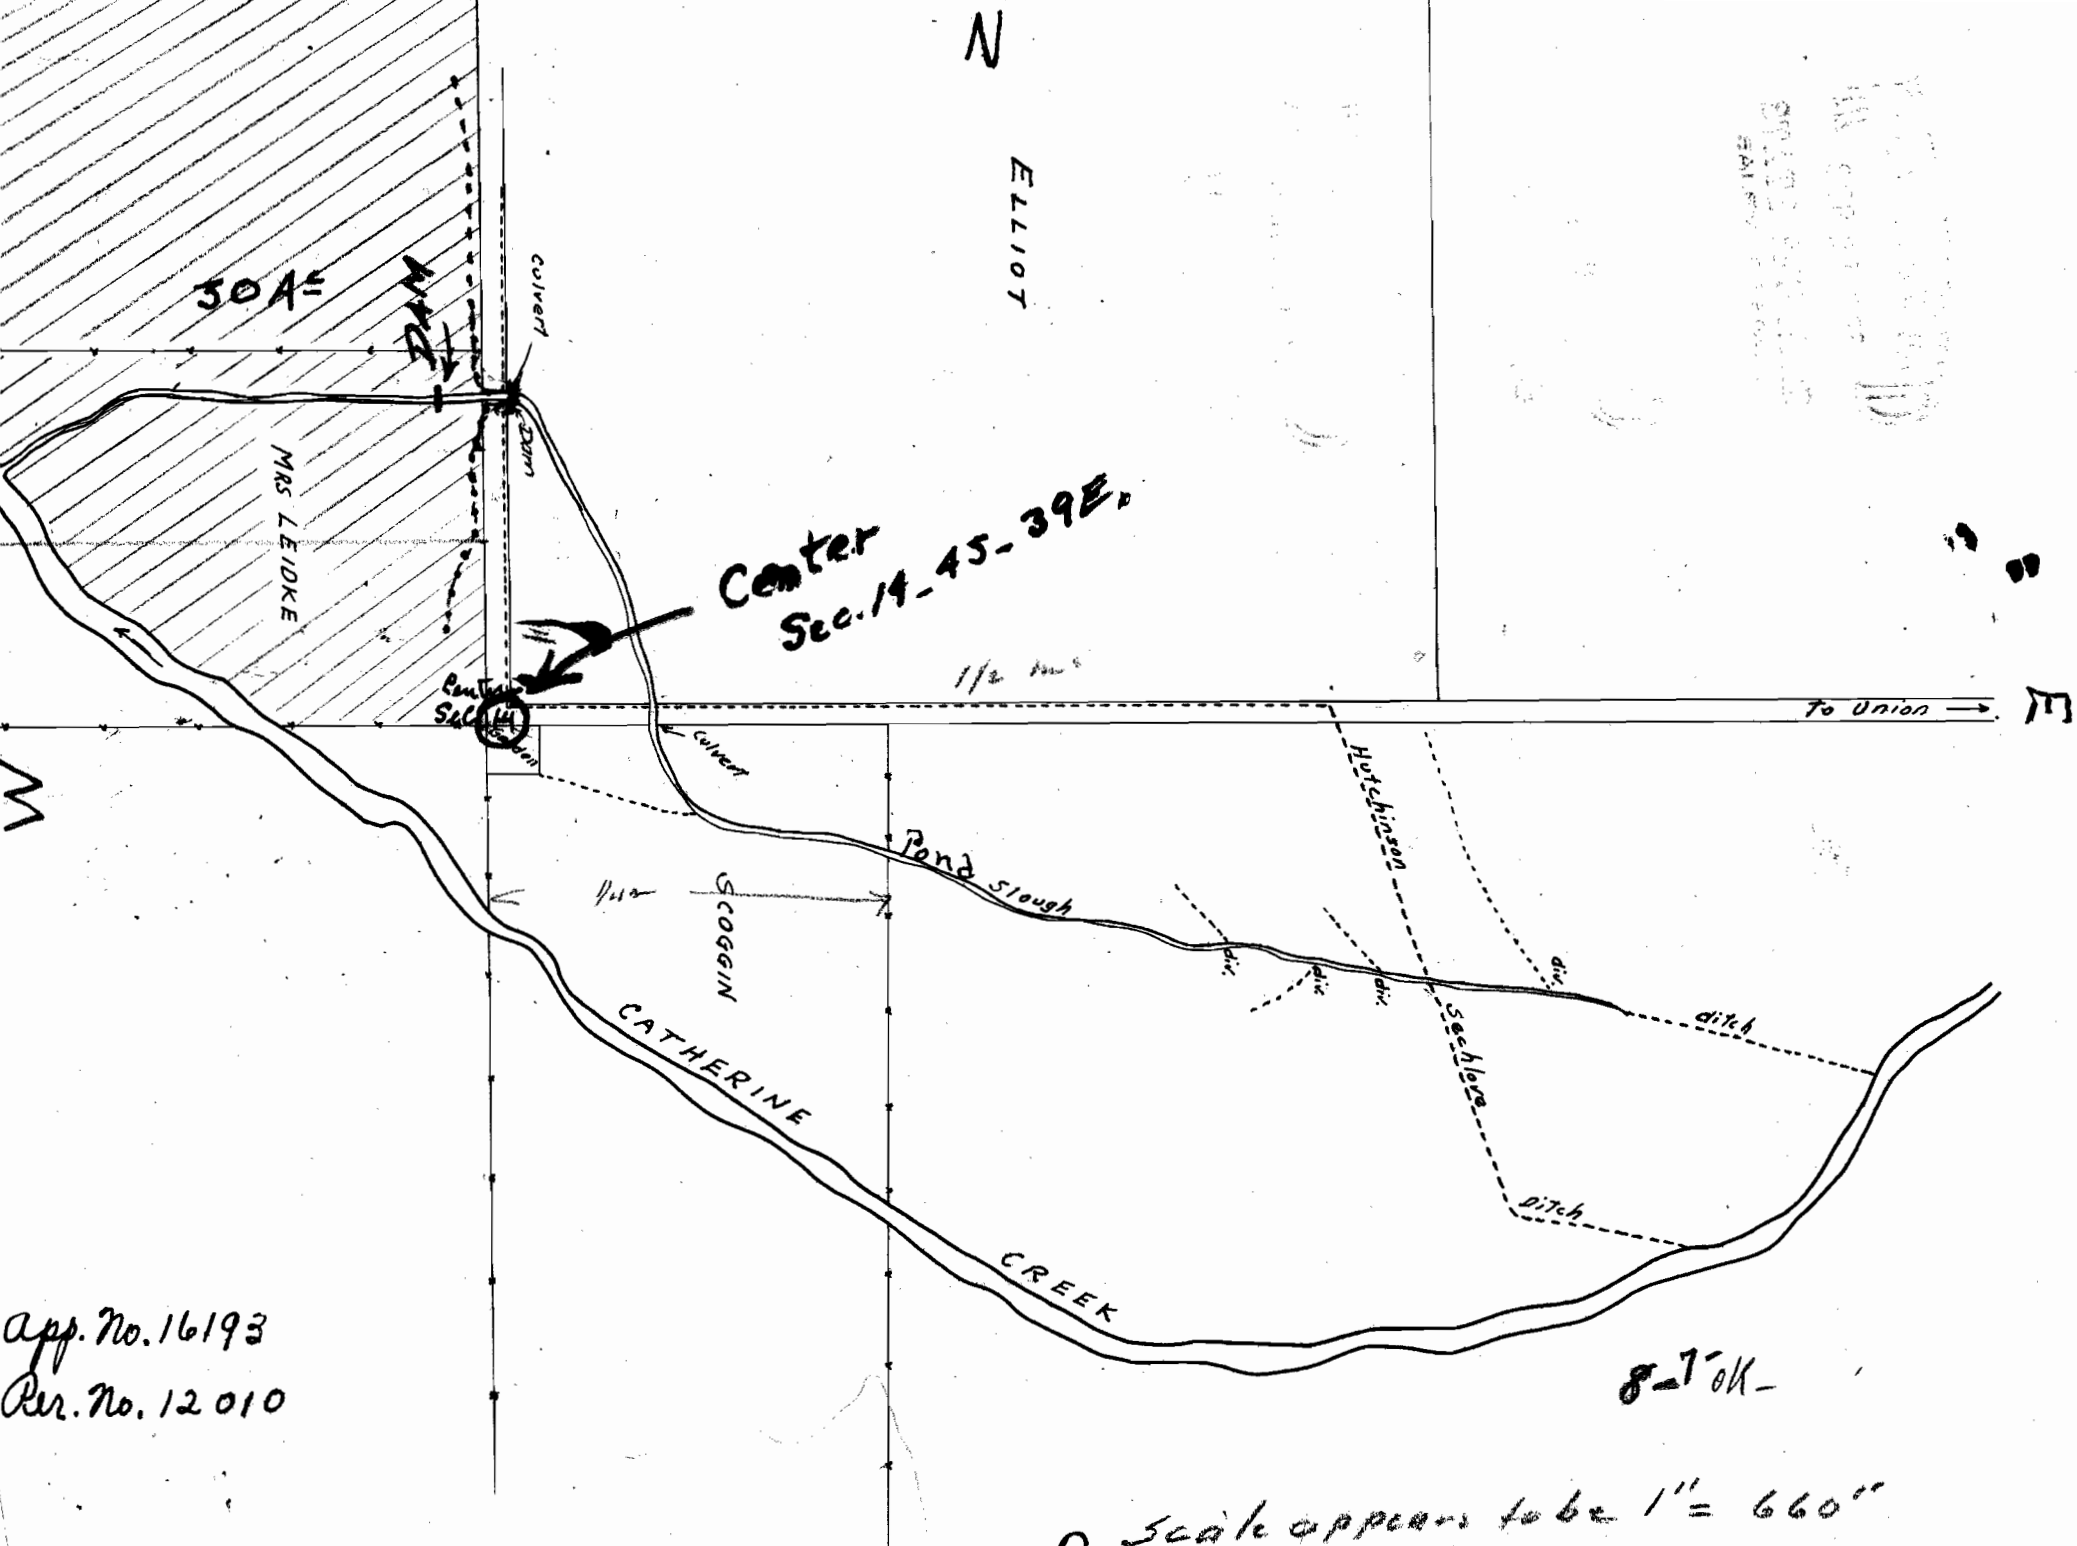

App. No. 16193
 Per. No. 12010

S scale appears to be 1" = 660'