


SECTION

\_\_\_\_\_  
\_\_\_\_\_  
\_\_\_\_\_

TOWNSHIP 35, RANGE 1E, W. M.

North

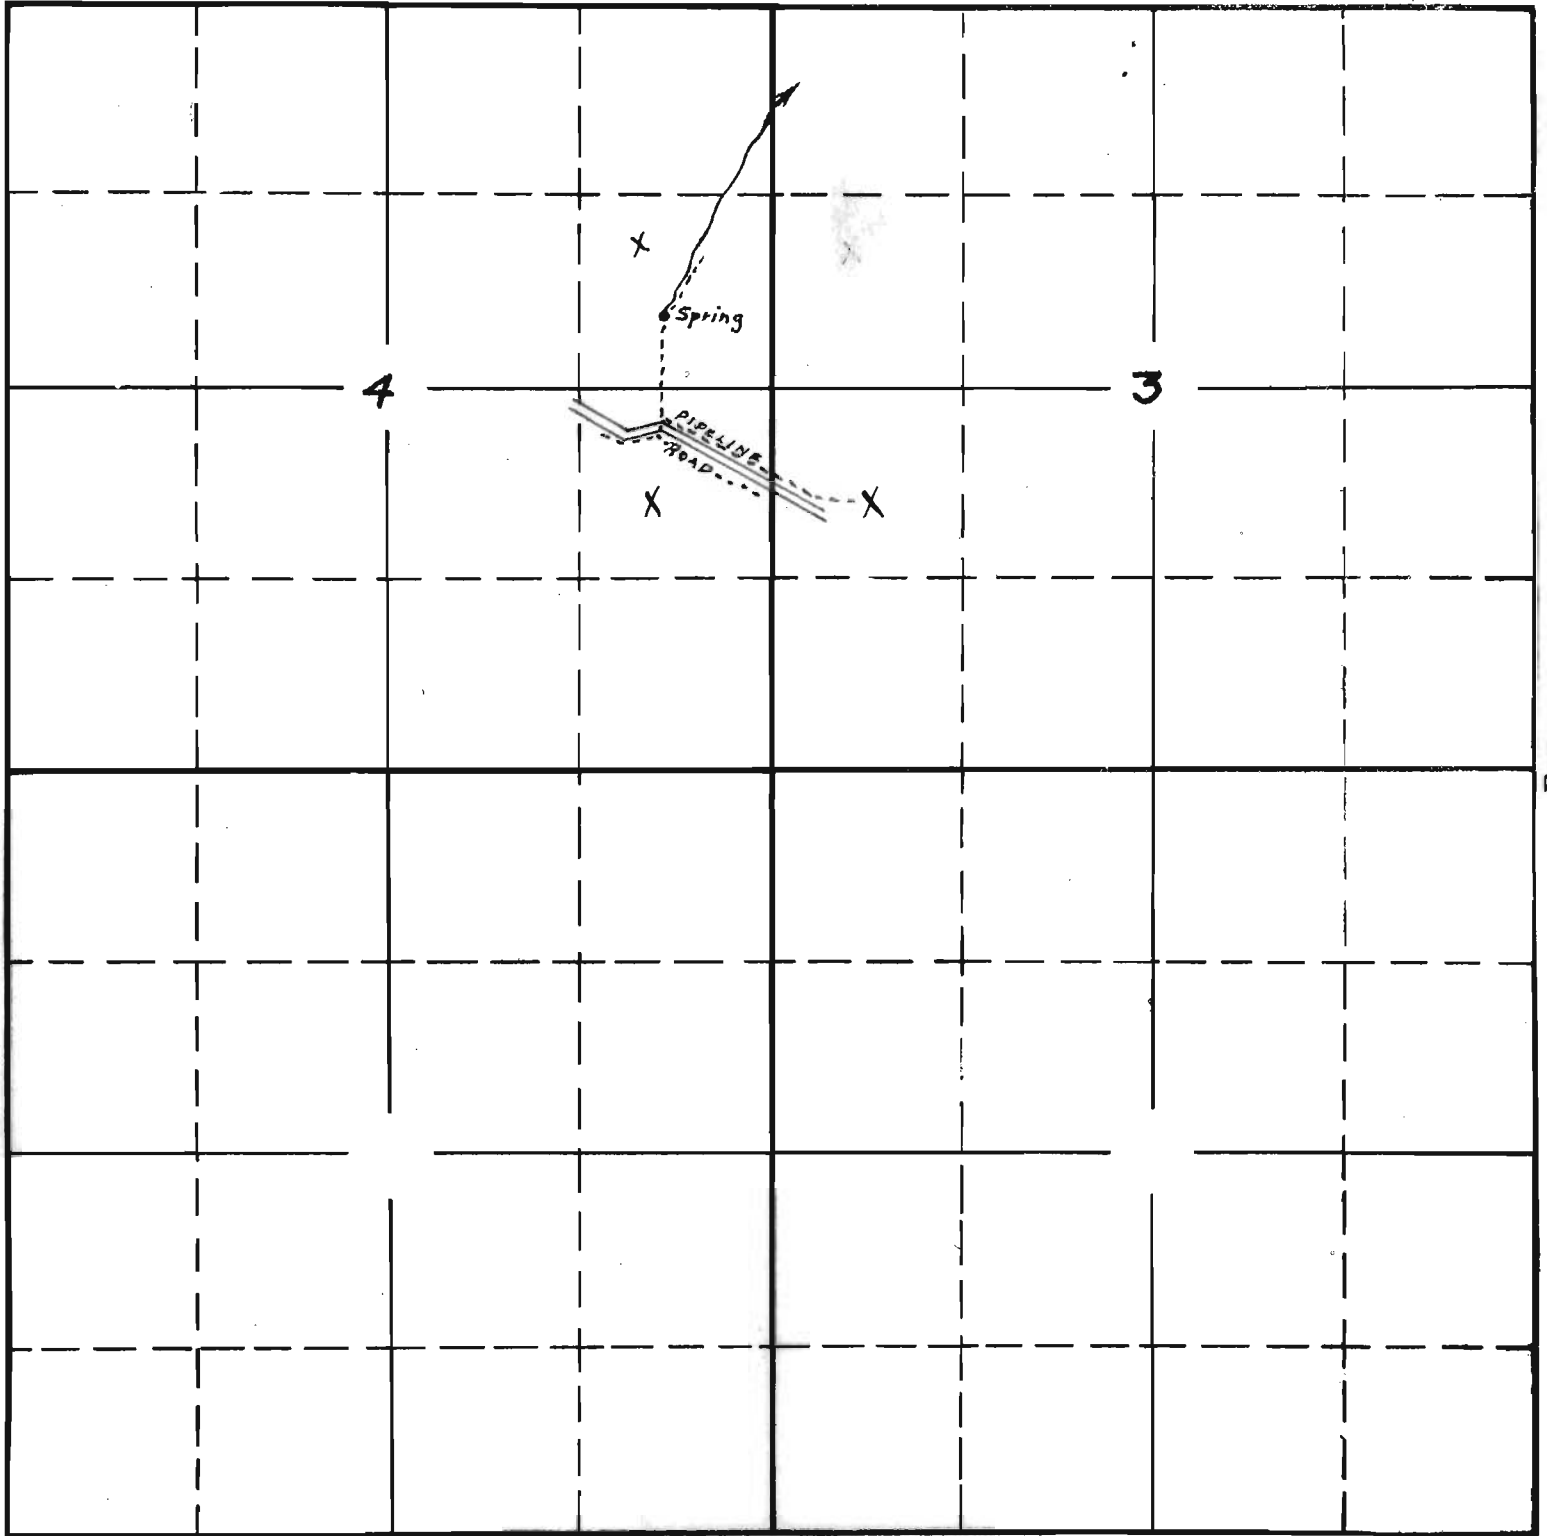

X Indicates location of places of use


RECEIVED  
DEC 31 1935

STATE ENGINEER  
LALEM, OREGON

2-62B-16195-OK  
APPLICATION No. 16195  
PERMIT No. 12012

SECTION

TOWNSHIP 35, RANGE 1E, W. M.

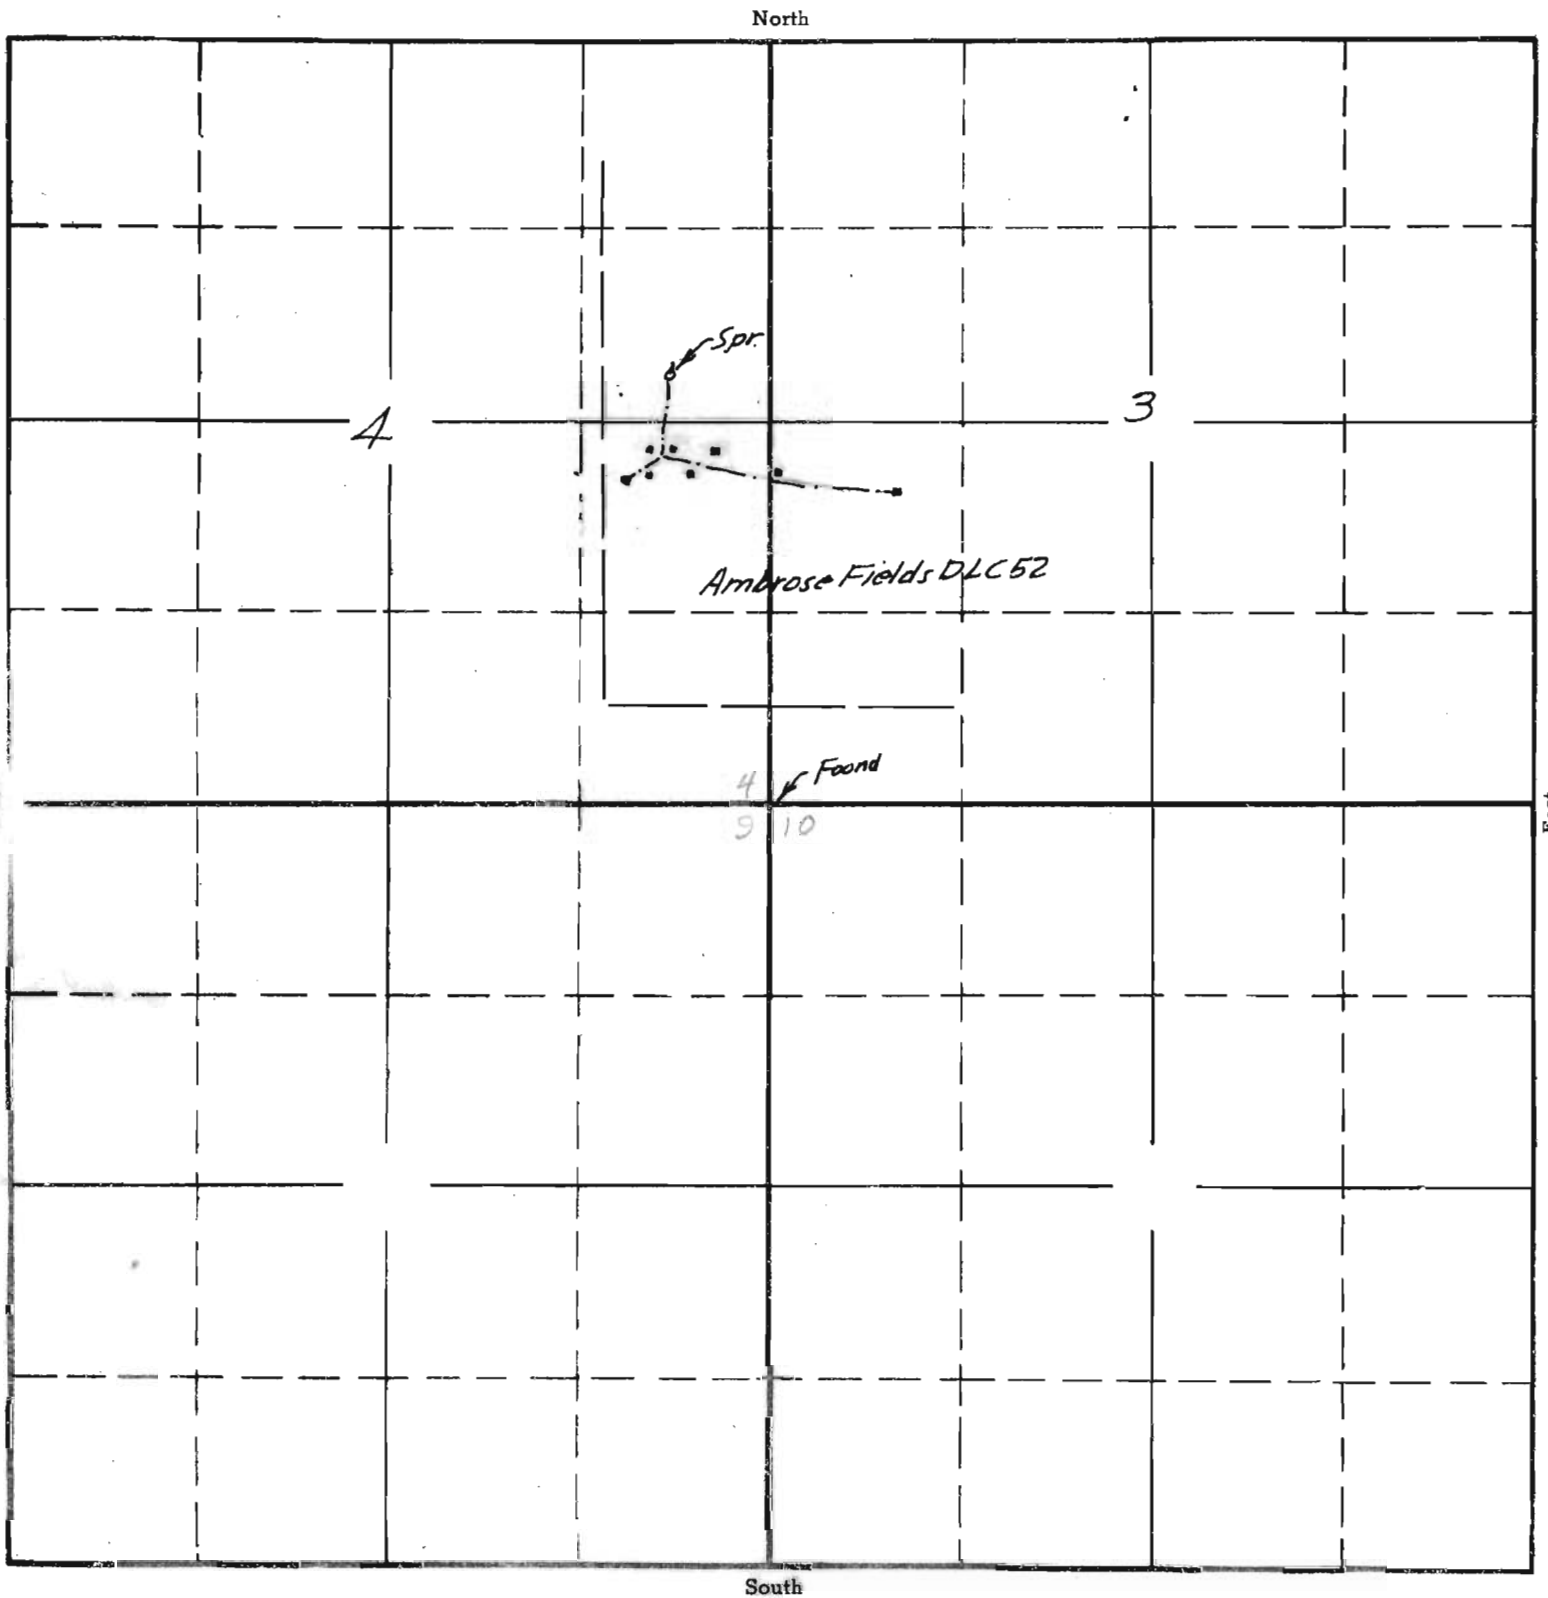

*Proof survey  
cab*

APPLICATION No. 16195

PERMIT No. 12012