

SECTION

\_\_\_\_\_


\_\_\_\_\_

\_\_\_\_\_

\_\_\_\_\_

TOWNSHIP 39S, RANGE 2E, W. M.

North

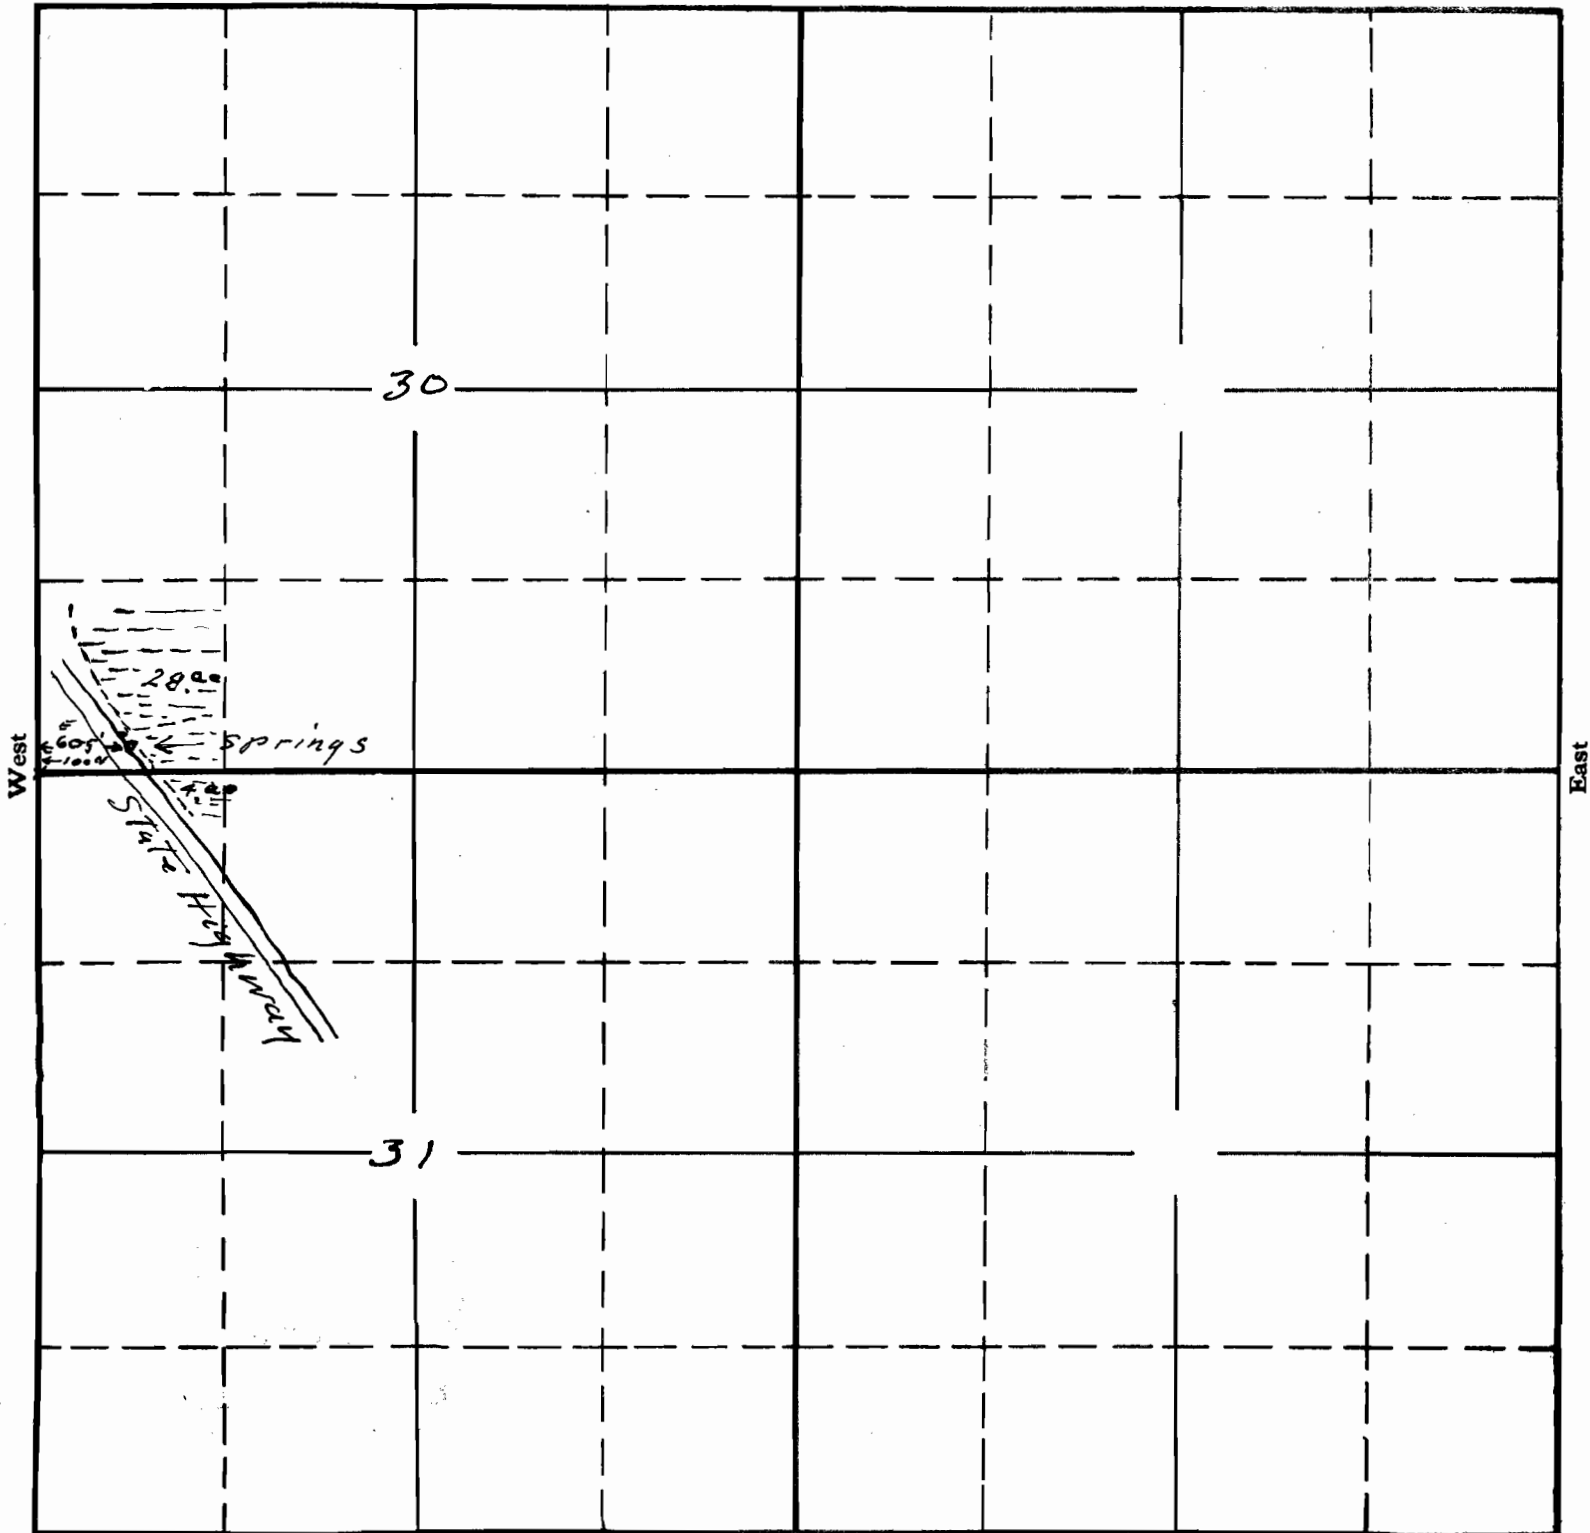

Sketch from description furnished by  
 DW Kincaid to accompany application APPLICATION No. 16197  
 for the supplement use of waters from PERMIT No. 12013  
 small springs arising on State Highway R.W.  
 for irrigation purposes