


SECTION

1  
\_\_\_\_\_  
\_\_\_\_\_  
\_\_\_\_\_

TOWNSHIP 25, RANGE 3W, W. M.

North

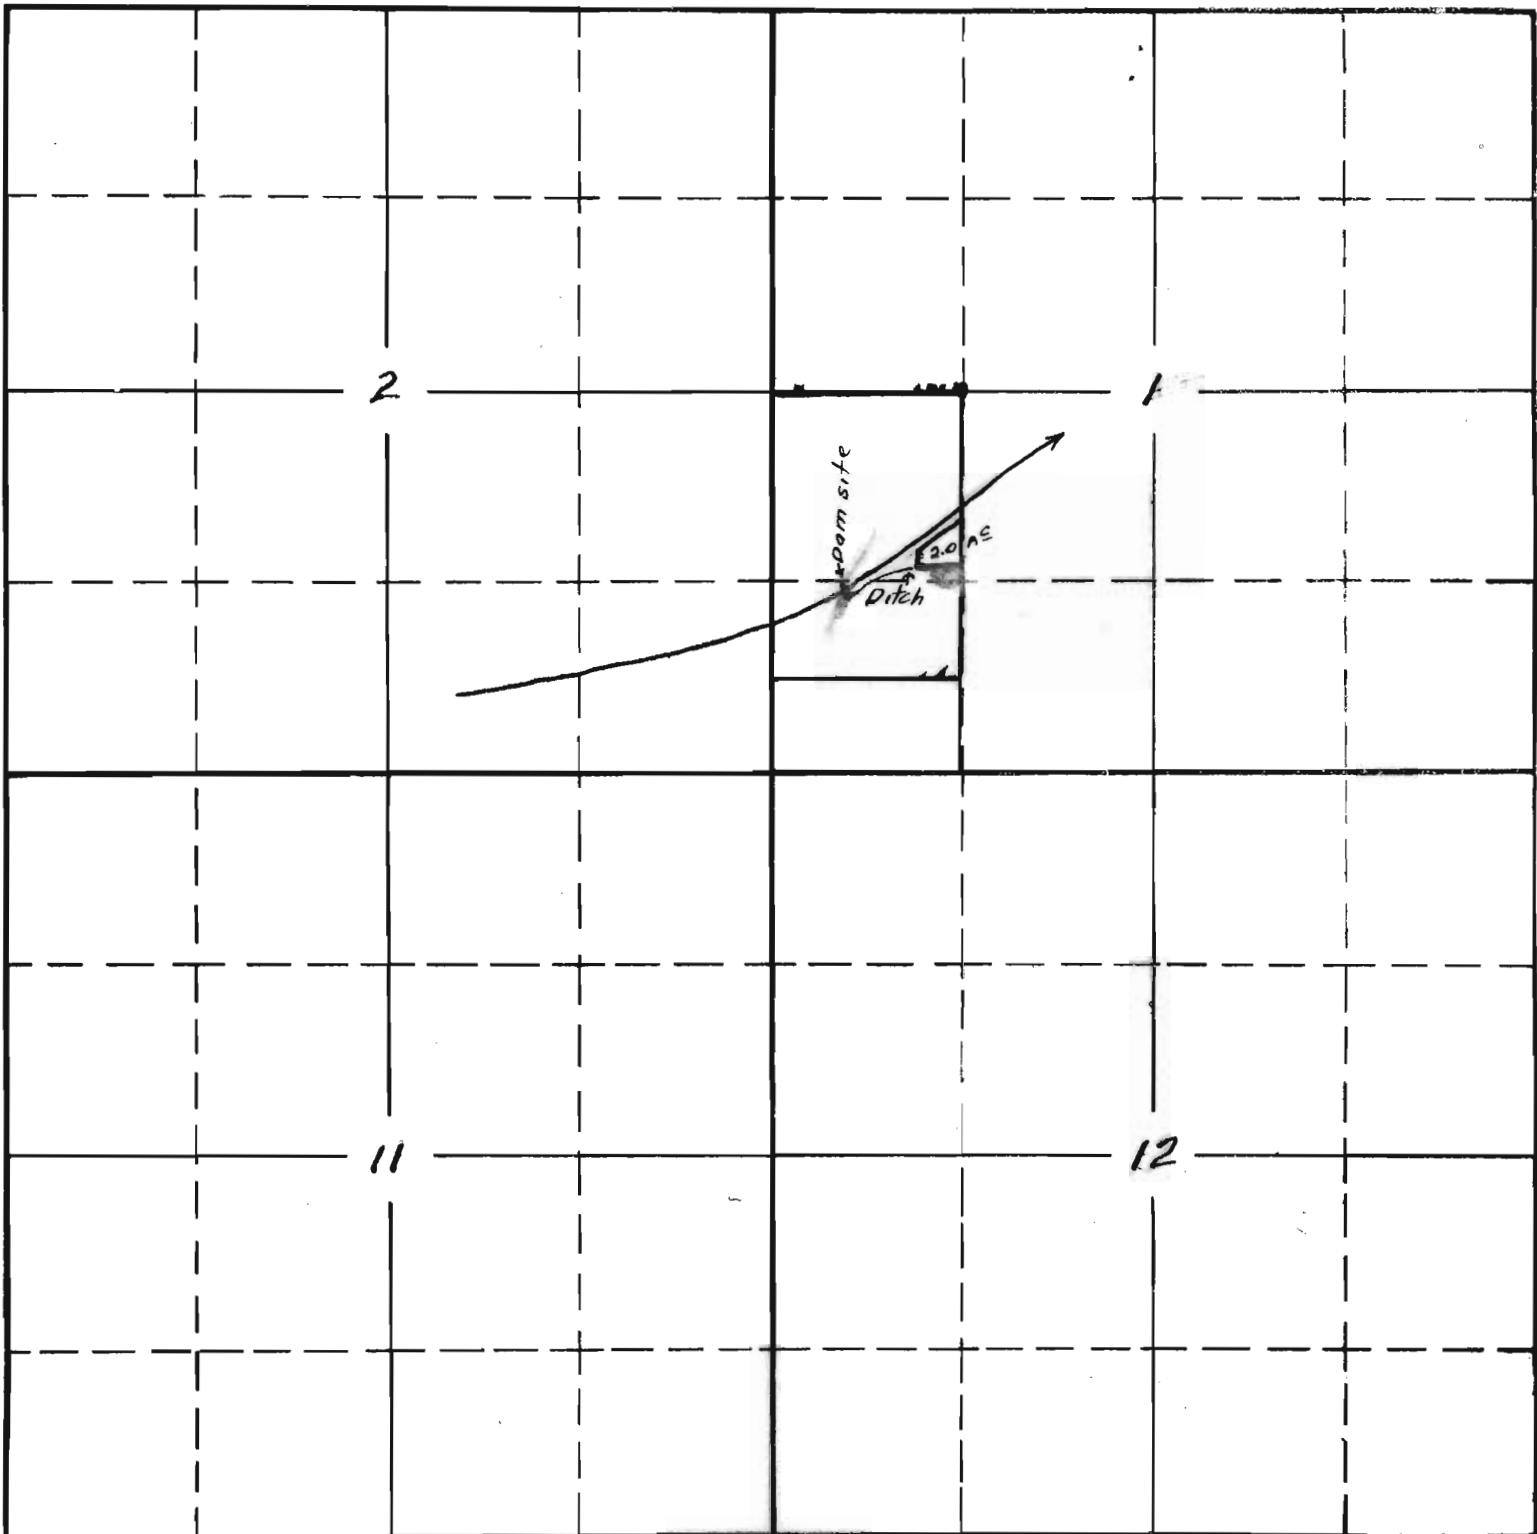

South

West

East


RECEIVED  
 FEB 7 1936  
 STATE ENGINEER  
 SALEM, OREGON

2-62B-16239-06  
 APPLICATION No. 16239  
 PERMIT No. 12054

SECTION

TOWNSHIP 25, RANGE 31N, W. M.

North

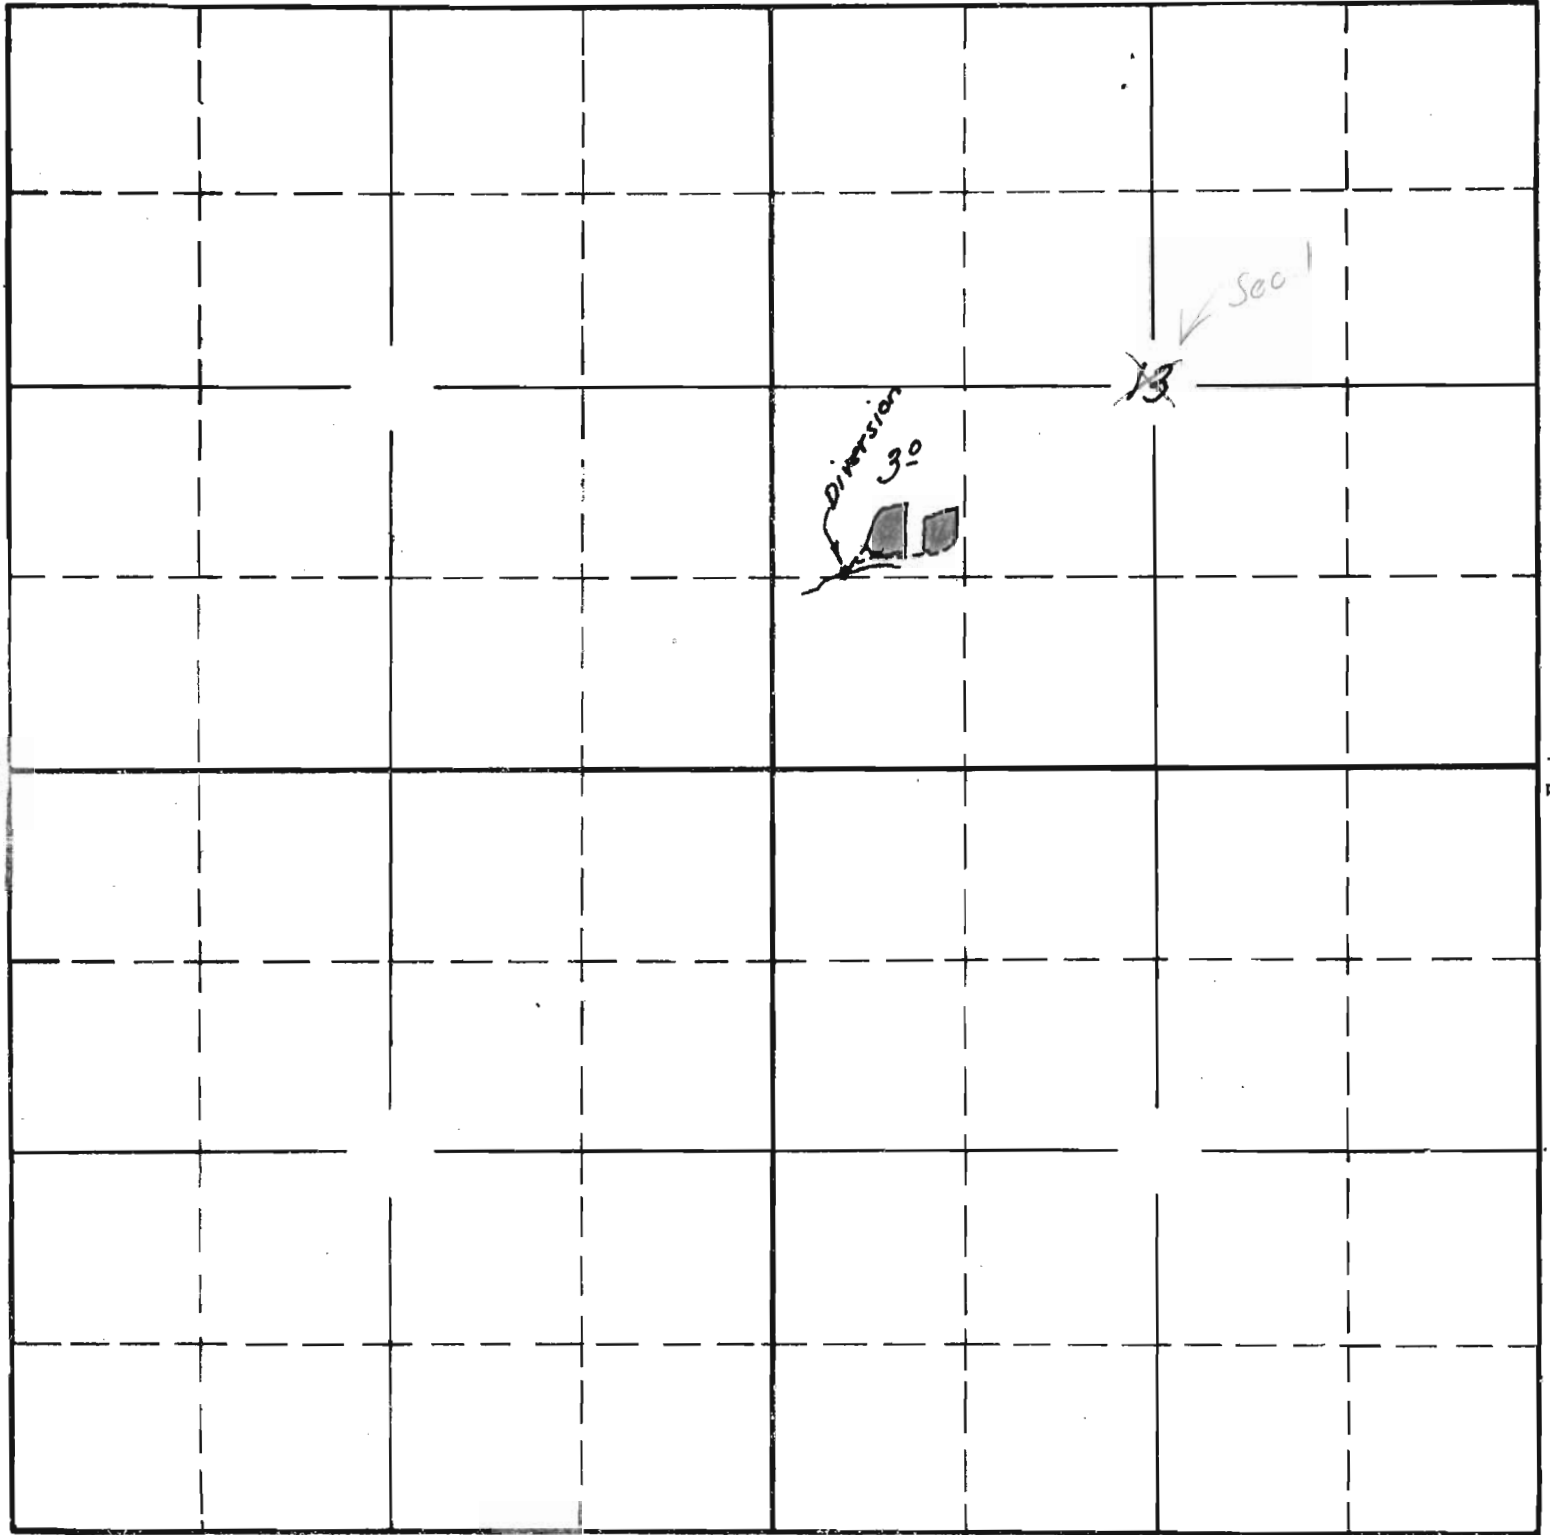

West

East

Surveyed June 12 1940 B.A.B.

South

APPLICATION No. 16239

PERMIT No. 12054