


SECTION

TOWNSHIP 36 S, RANGE 3 W, W. M.

North

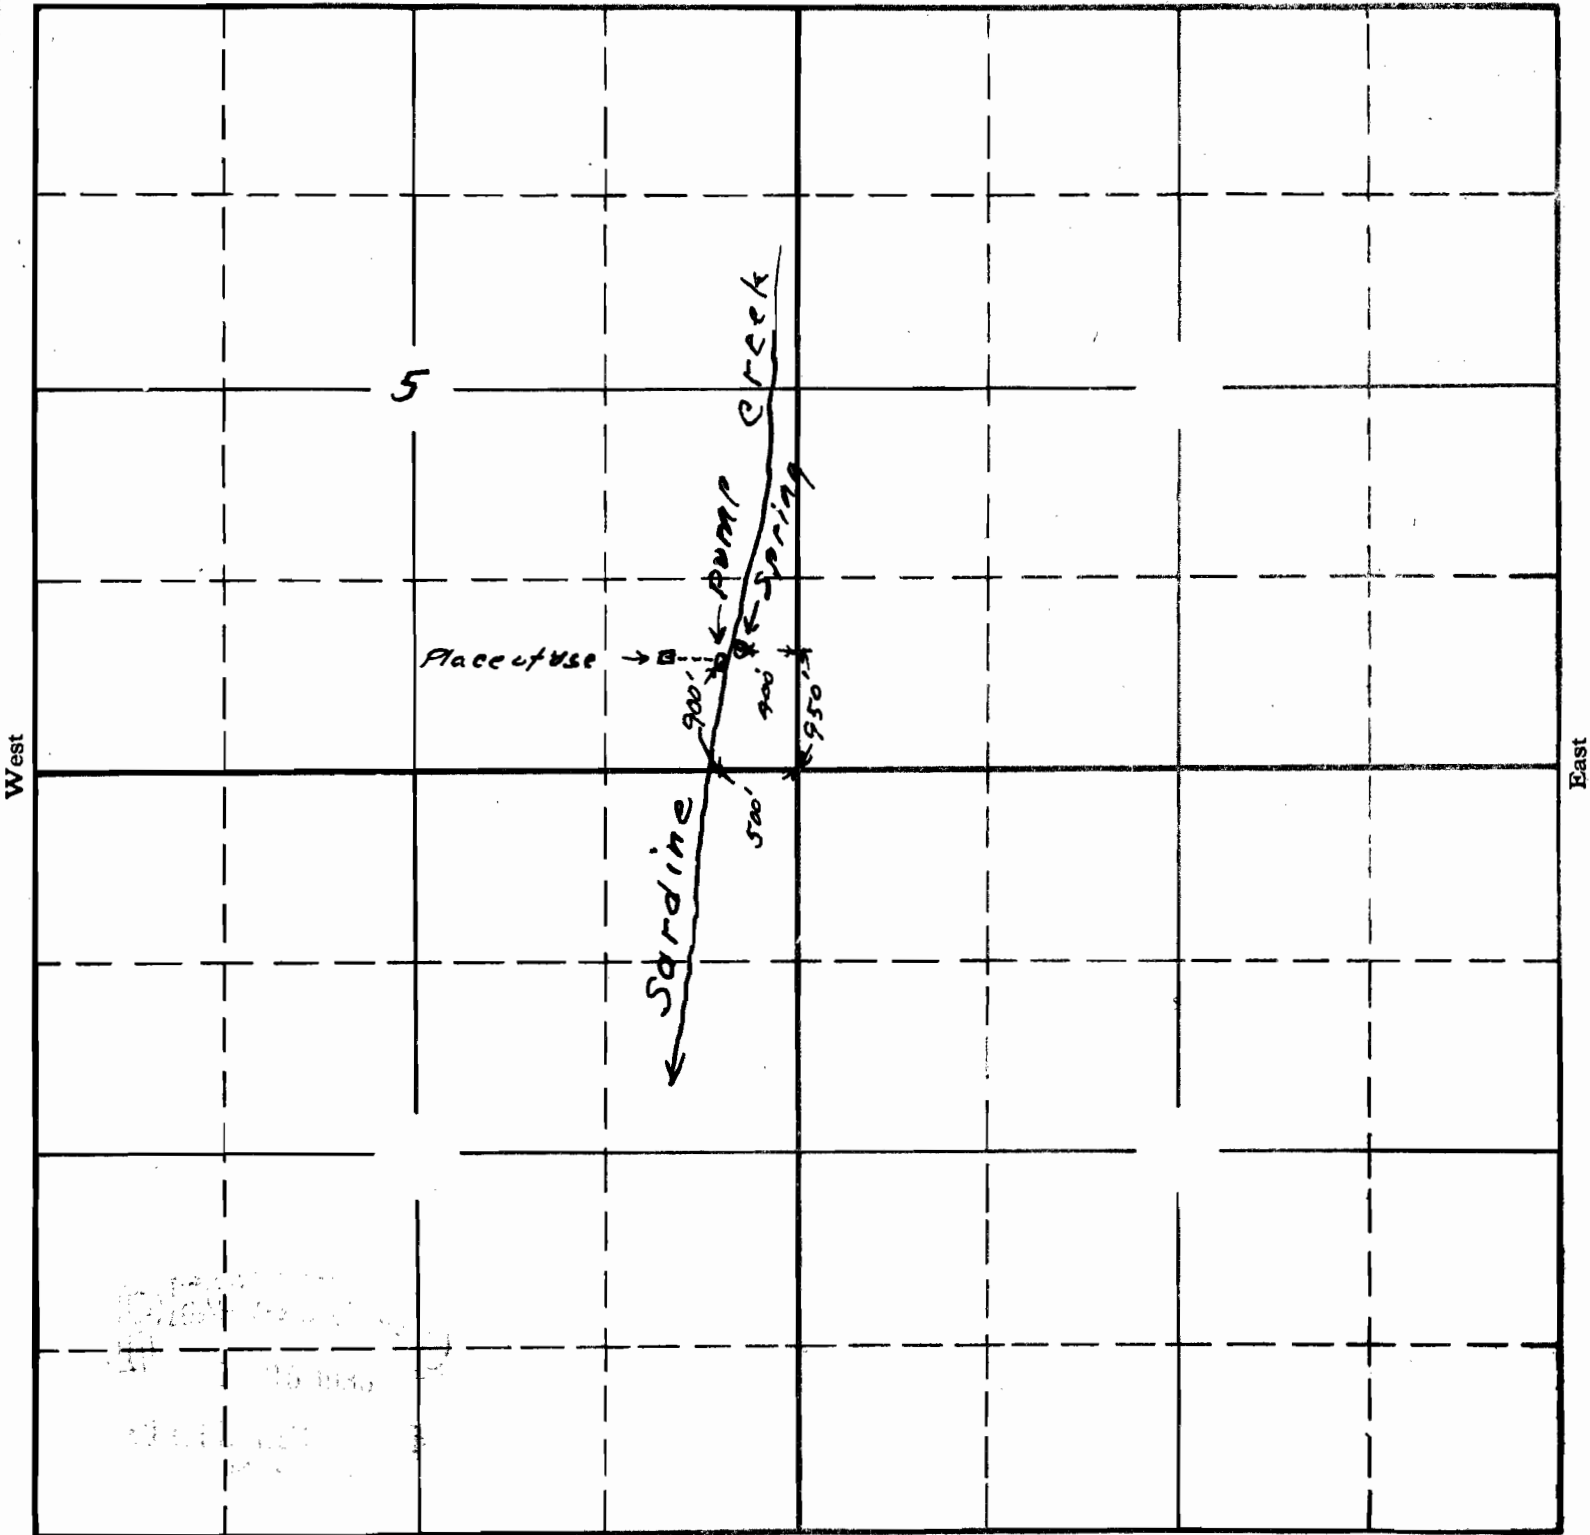

Sketch showing location of <sup>South</sup> pump and spring as measured by H Dunlap APPLICATION No. 16257  
 To accompany app. of Howard Dunlap PERMIT No. 12065  
 for appropriation of waters of Sardine Creek  
 and unnamed spring for domestic and garden