


Sec. 14
15
22
23
Tp. 35
R. 40E
W.M.

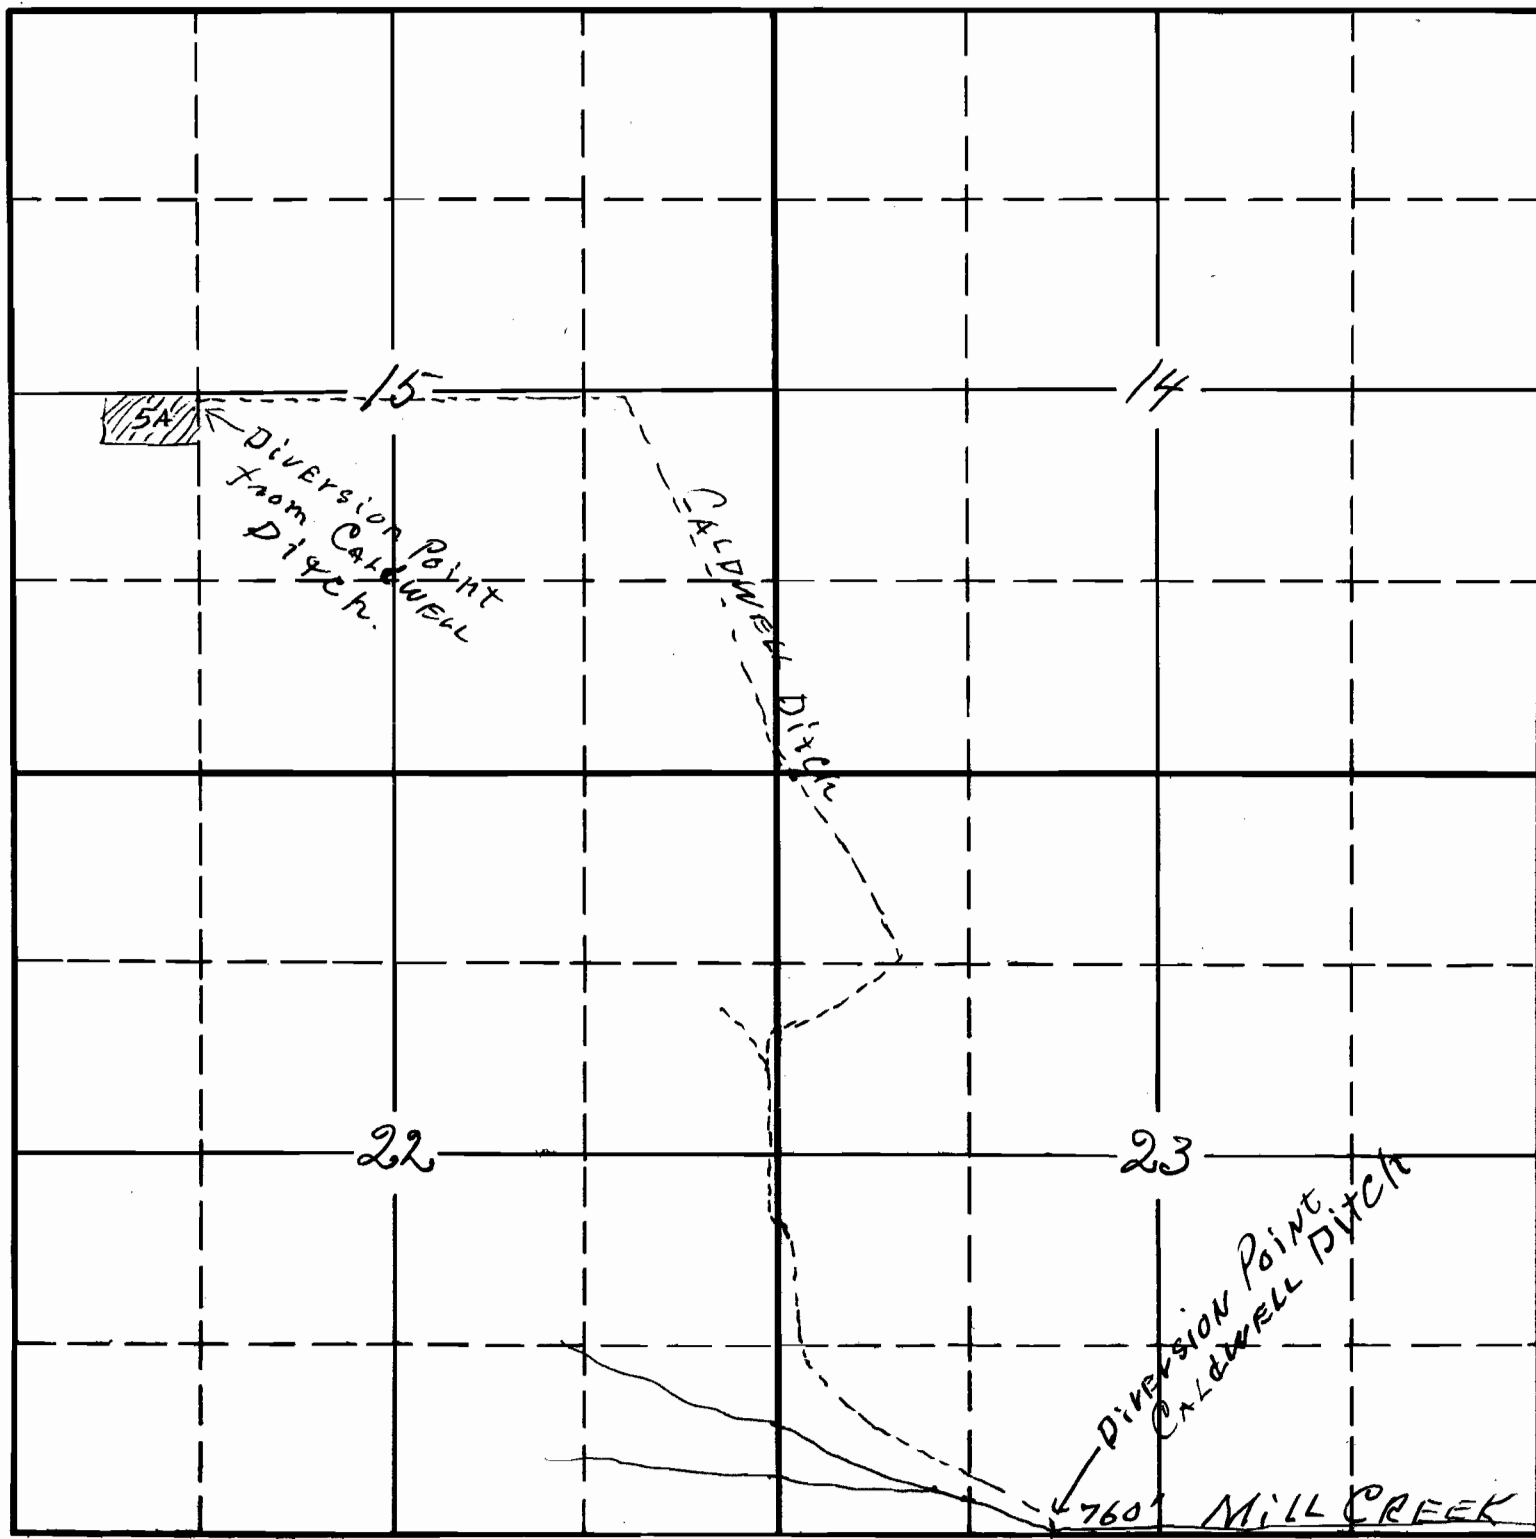


8-17-16236-14

App. No. 16236
Per. No. 12075

PLANNING
DIVISION
MAY 19 1966

Sec. 14
15
22
23
Tp. 35
R. 40E
Wm.

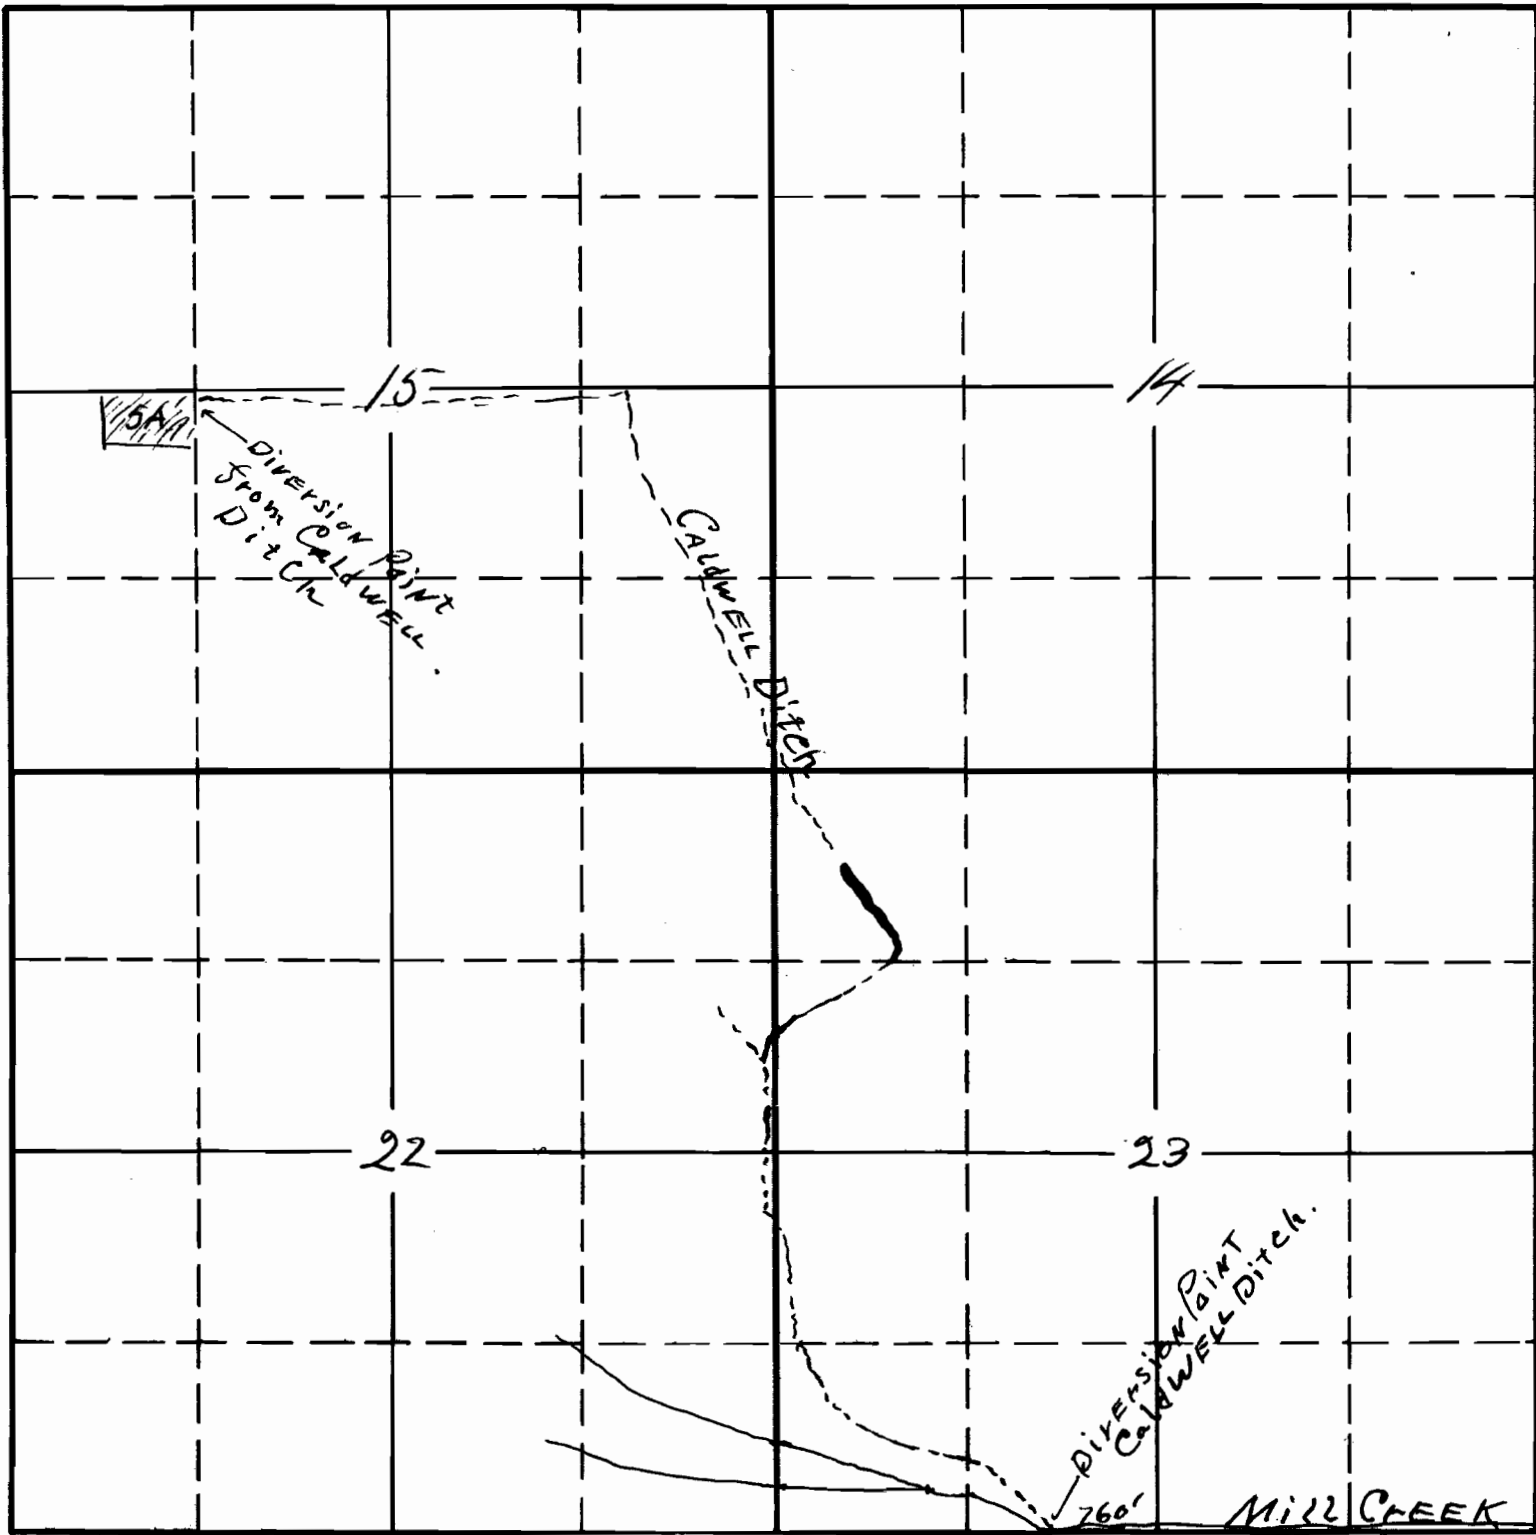

Succeeded