


SECTION

11

TOWNSHIP 35 S, RANGE 8 W, W. M.

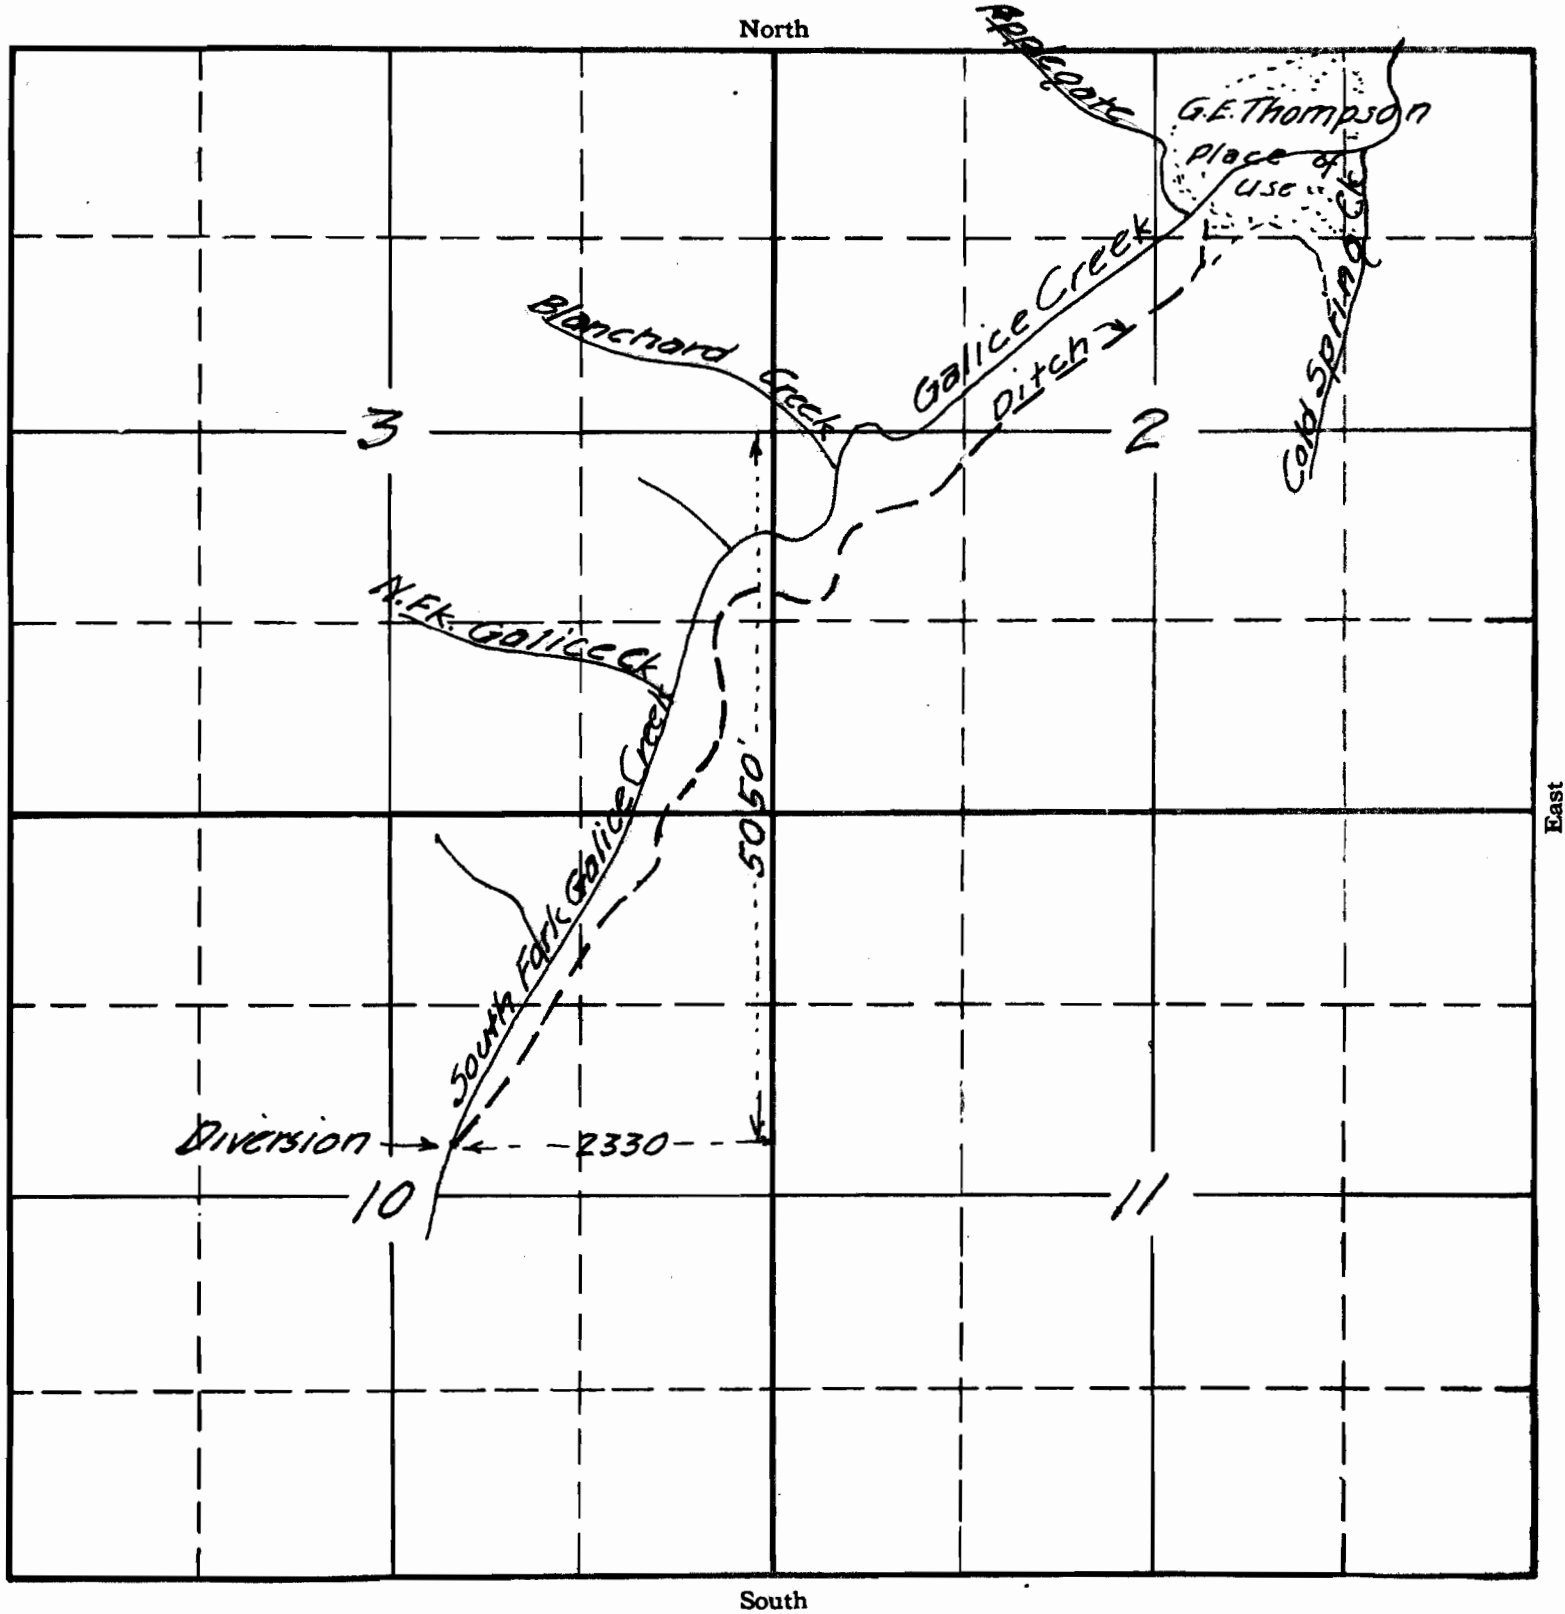

APPLICATION No. 16264
 PERMIT No. 12083

[Faint, illegible text]