

SECTION

16


17

20

21

TOWNSHIP 4S, RANGE 2E, W. M.

North

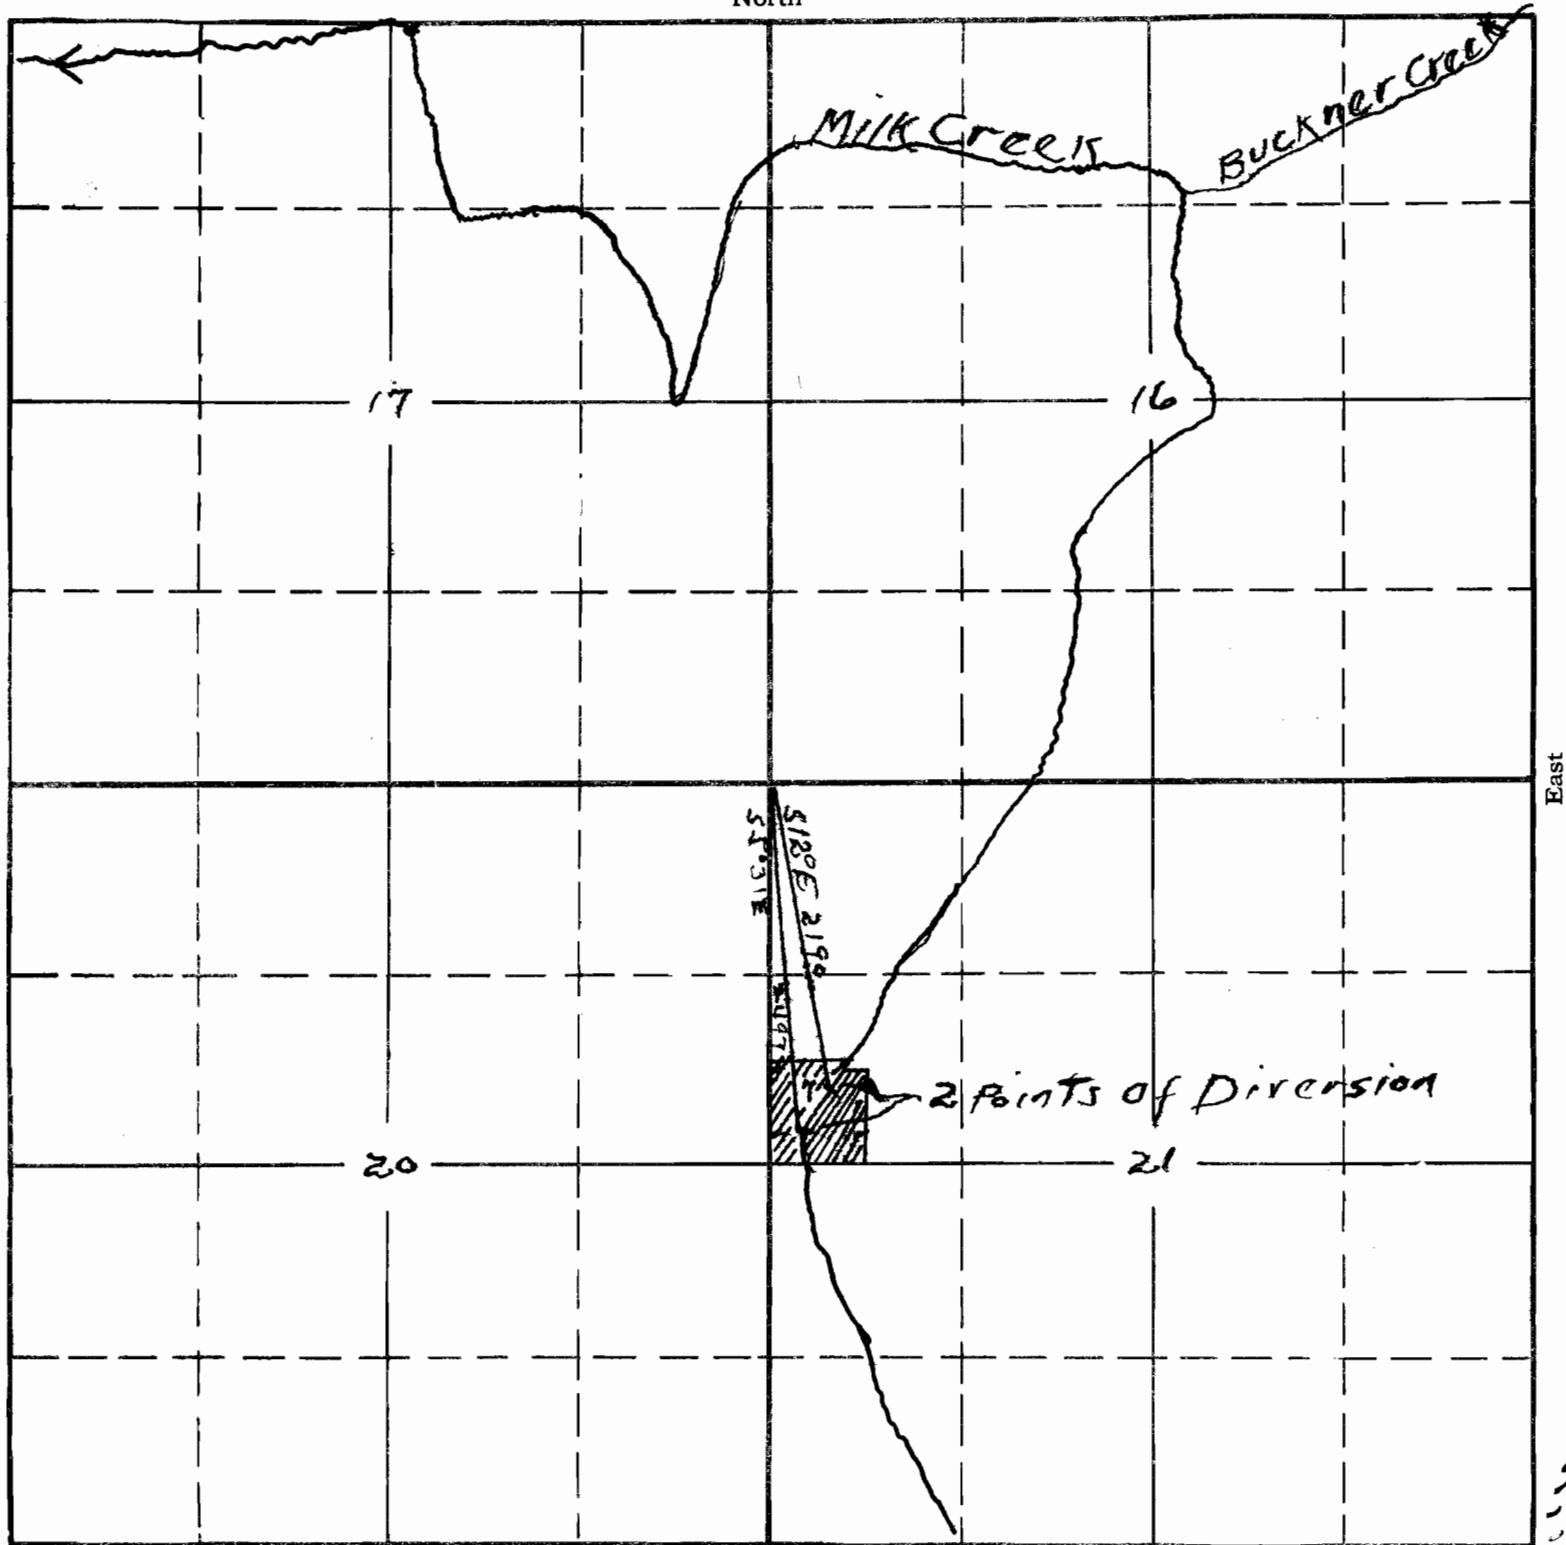


South

2-324-02-
APPLICATION No. 16293
PERMIT No. 12100

SECTION

TOWNSHIP 45, RANGE 2E, W. M.

North

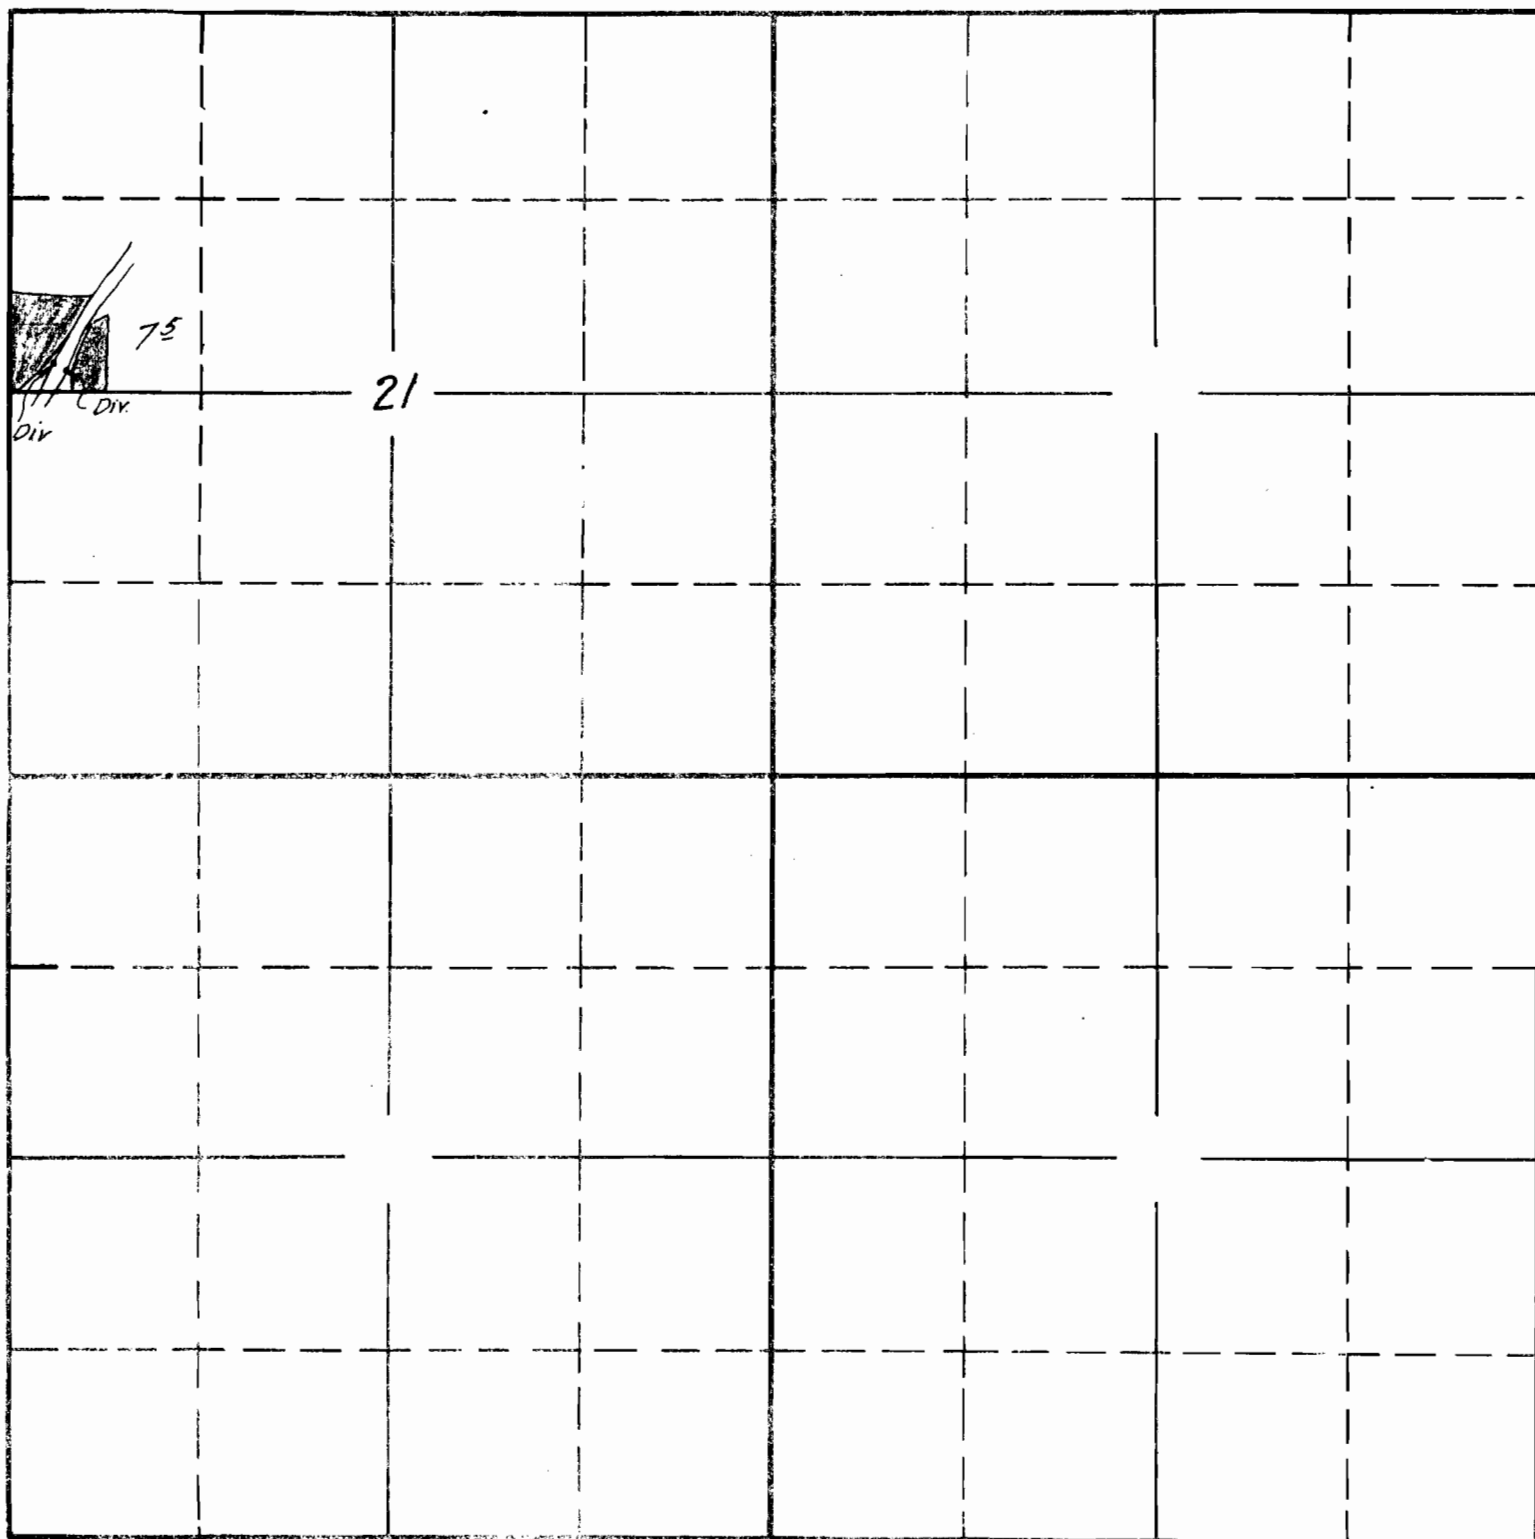

Surveyed May 28 1940 C.A.B.

APPLICATION No. 16293

PERMIT No. 12100