


SECTION

22 + 27

TOWNSHIP 115, RANGE 5W, W. M.

North

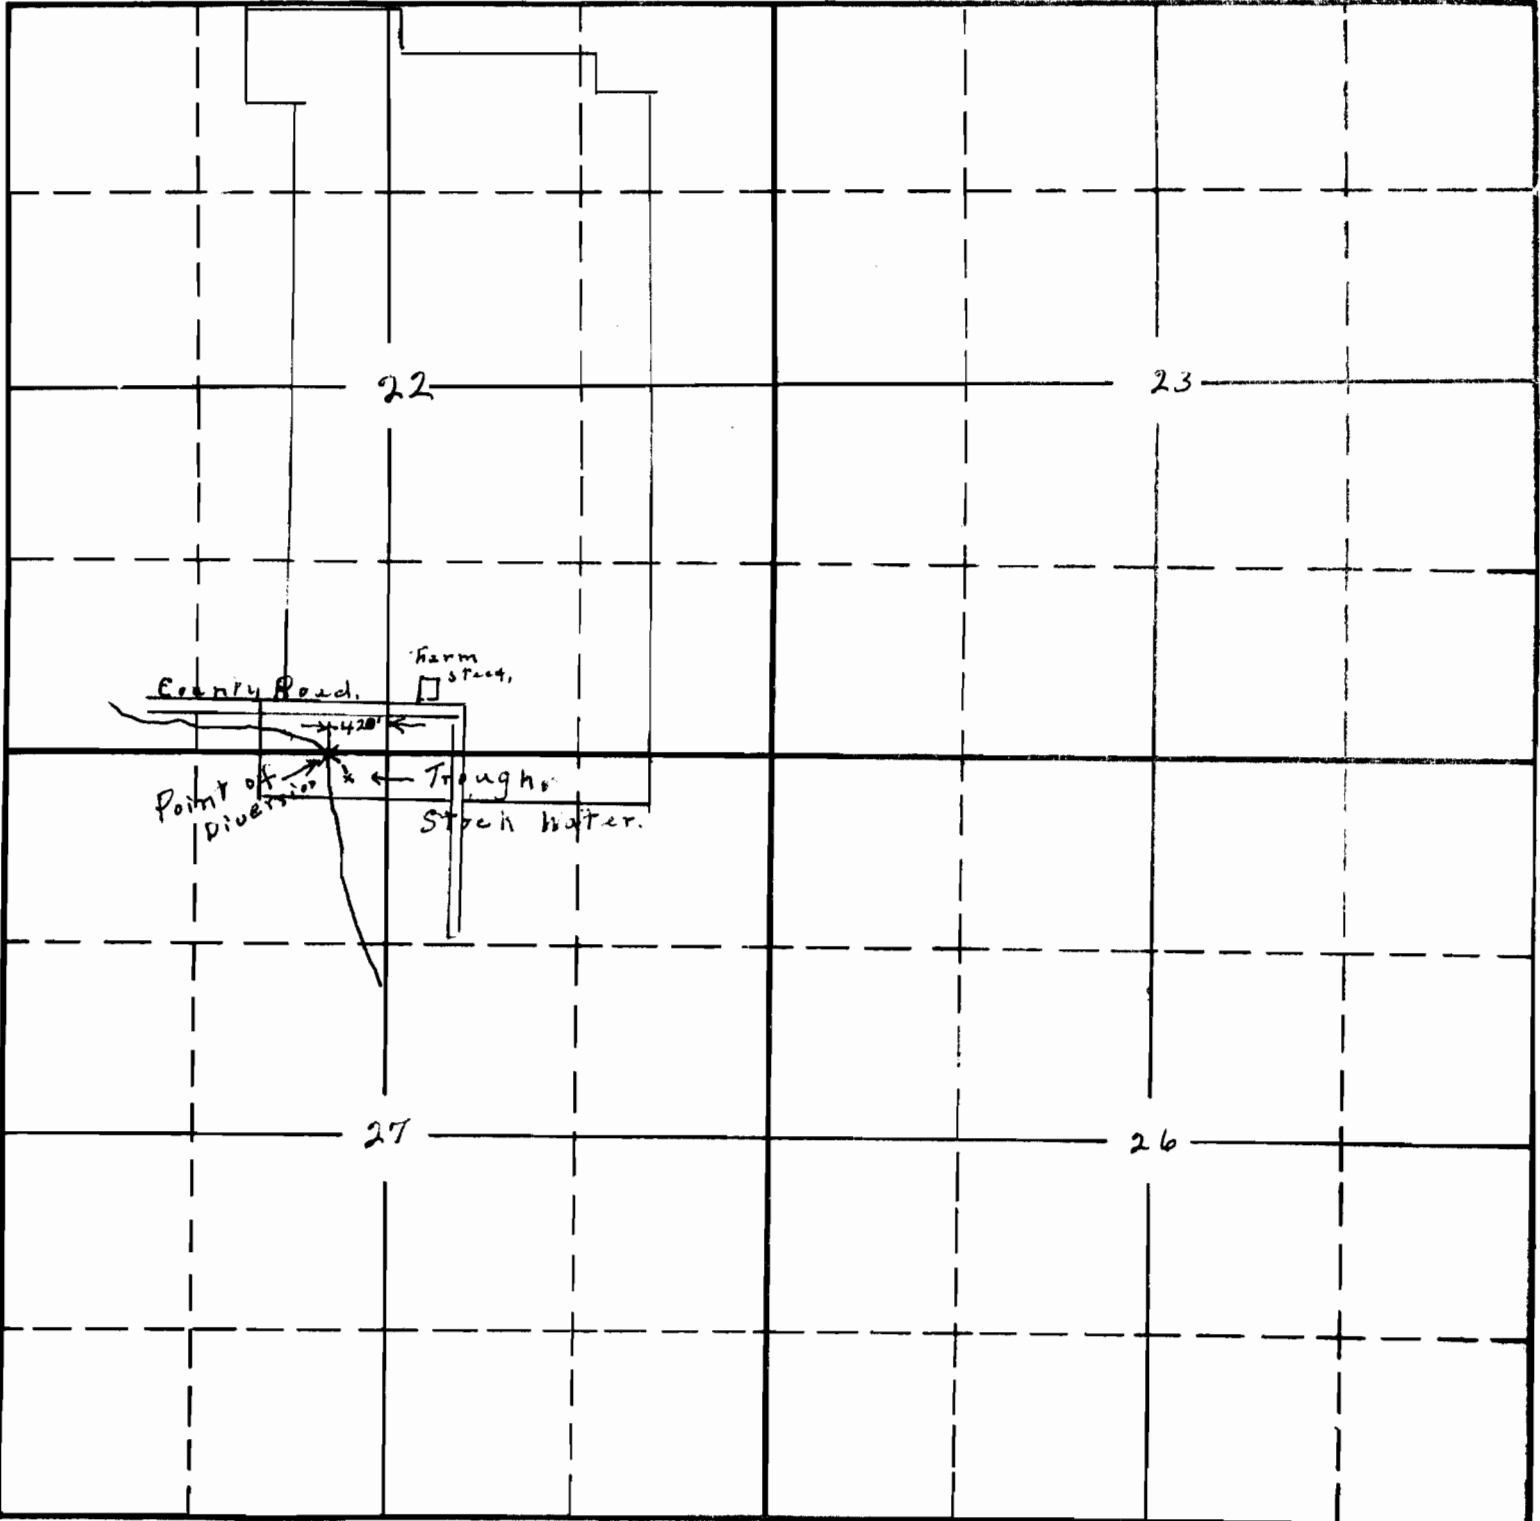

South

2-768-16296-AR  
APPLICATION No. 16296  
PERMIT No. 12101