


SECTION

14

TOWNSHIP 45, RANGE 1 W, W. M.

North

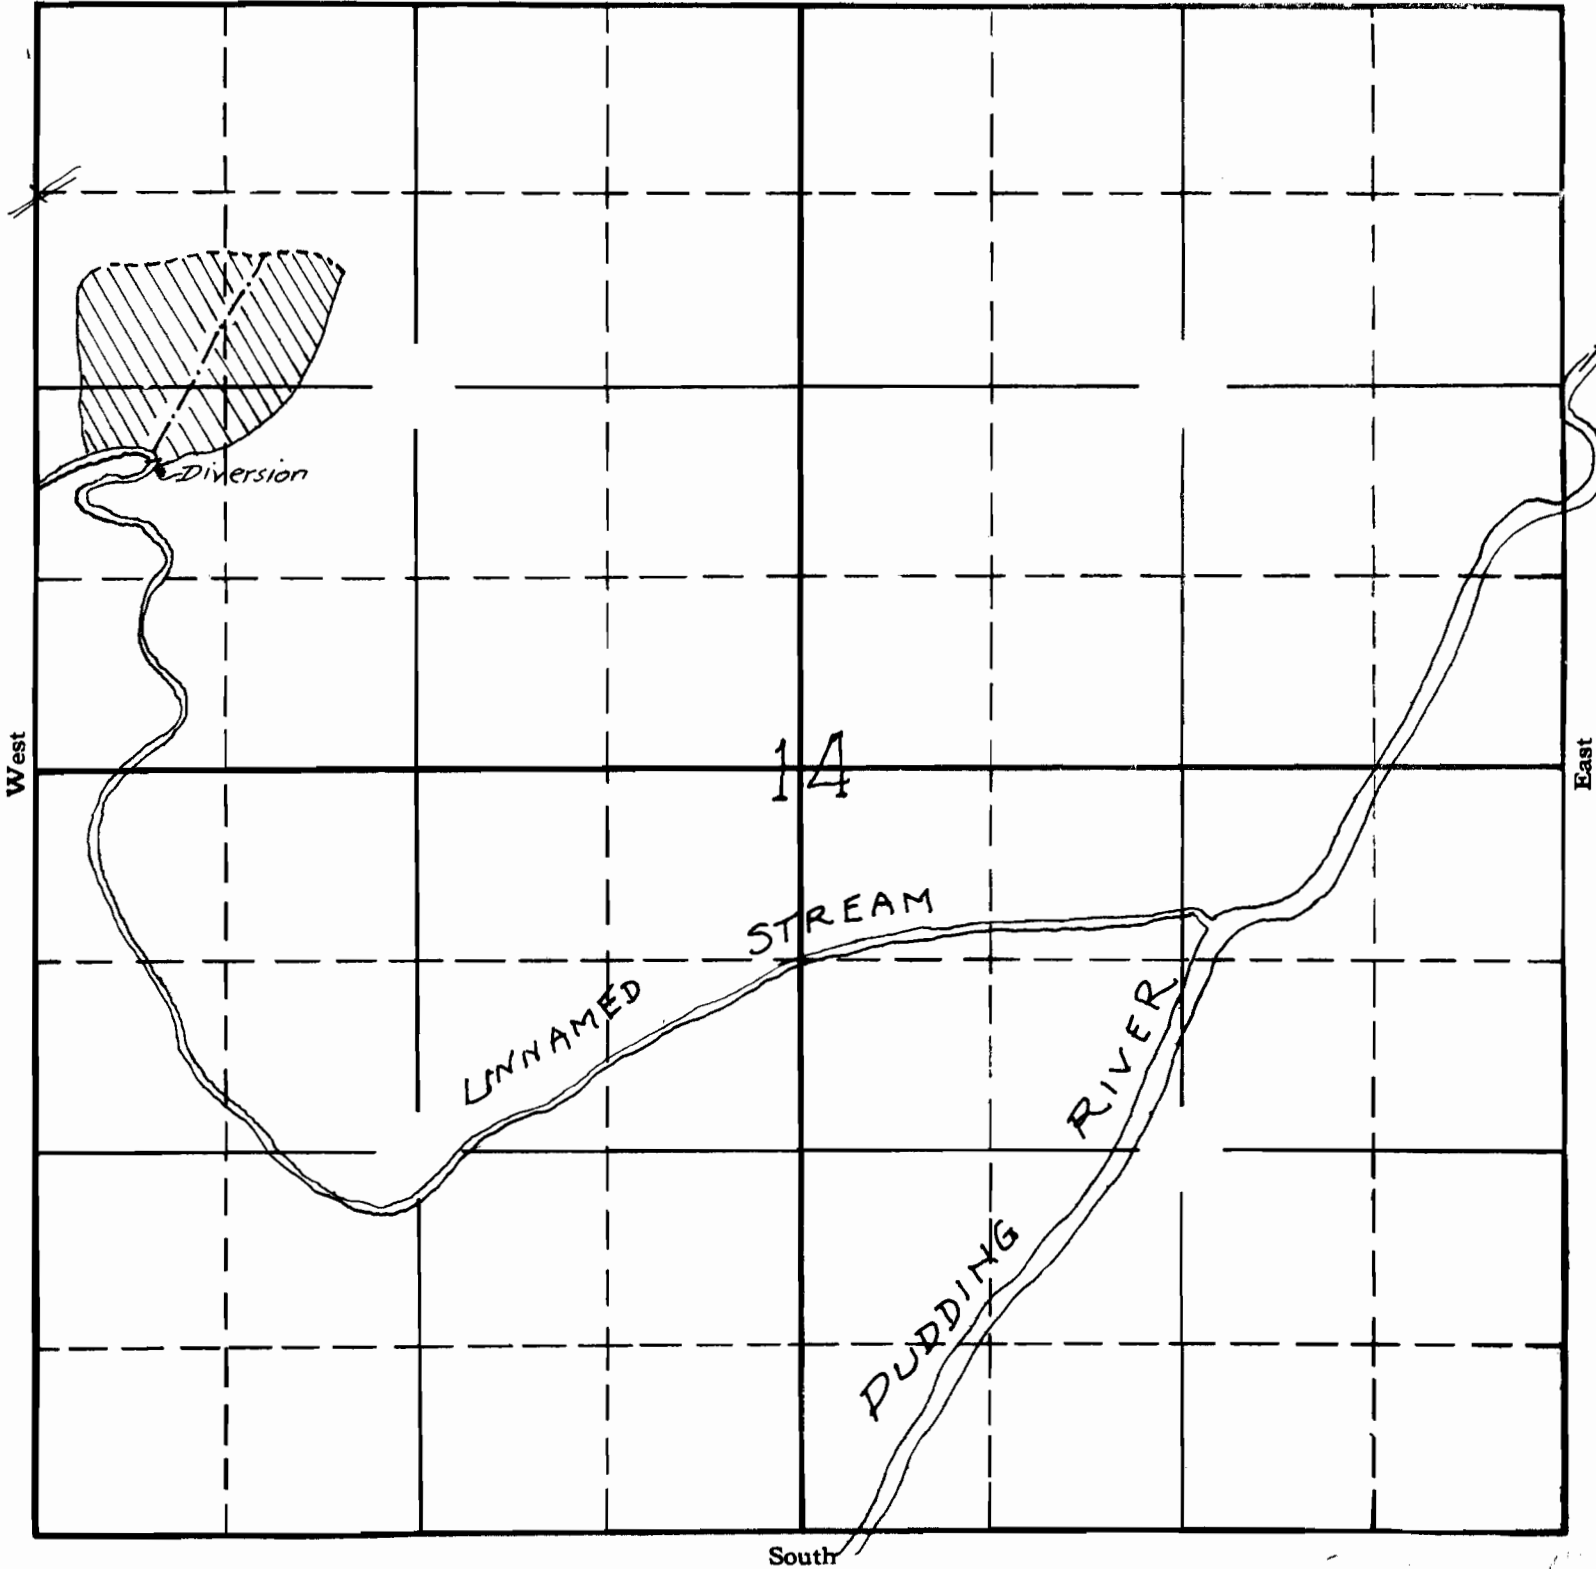

Sketch made from information  
furnished by applicant.

Humphrey


APPLICATION No. 16306

PERMIT No. 12106

SECTION

TOWNSHIP 45, RANGE 1W, W. M.

North

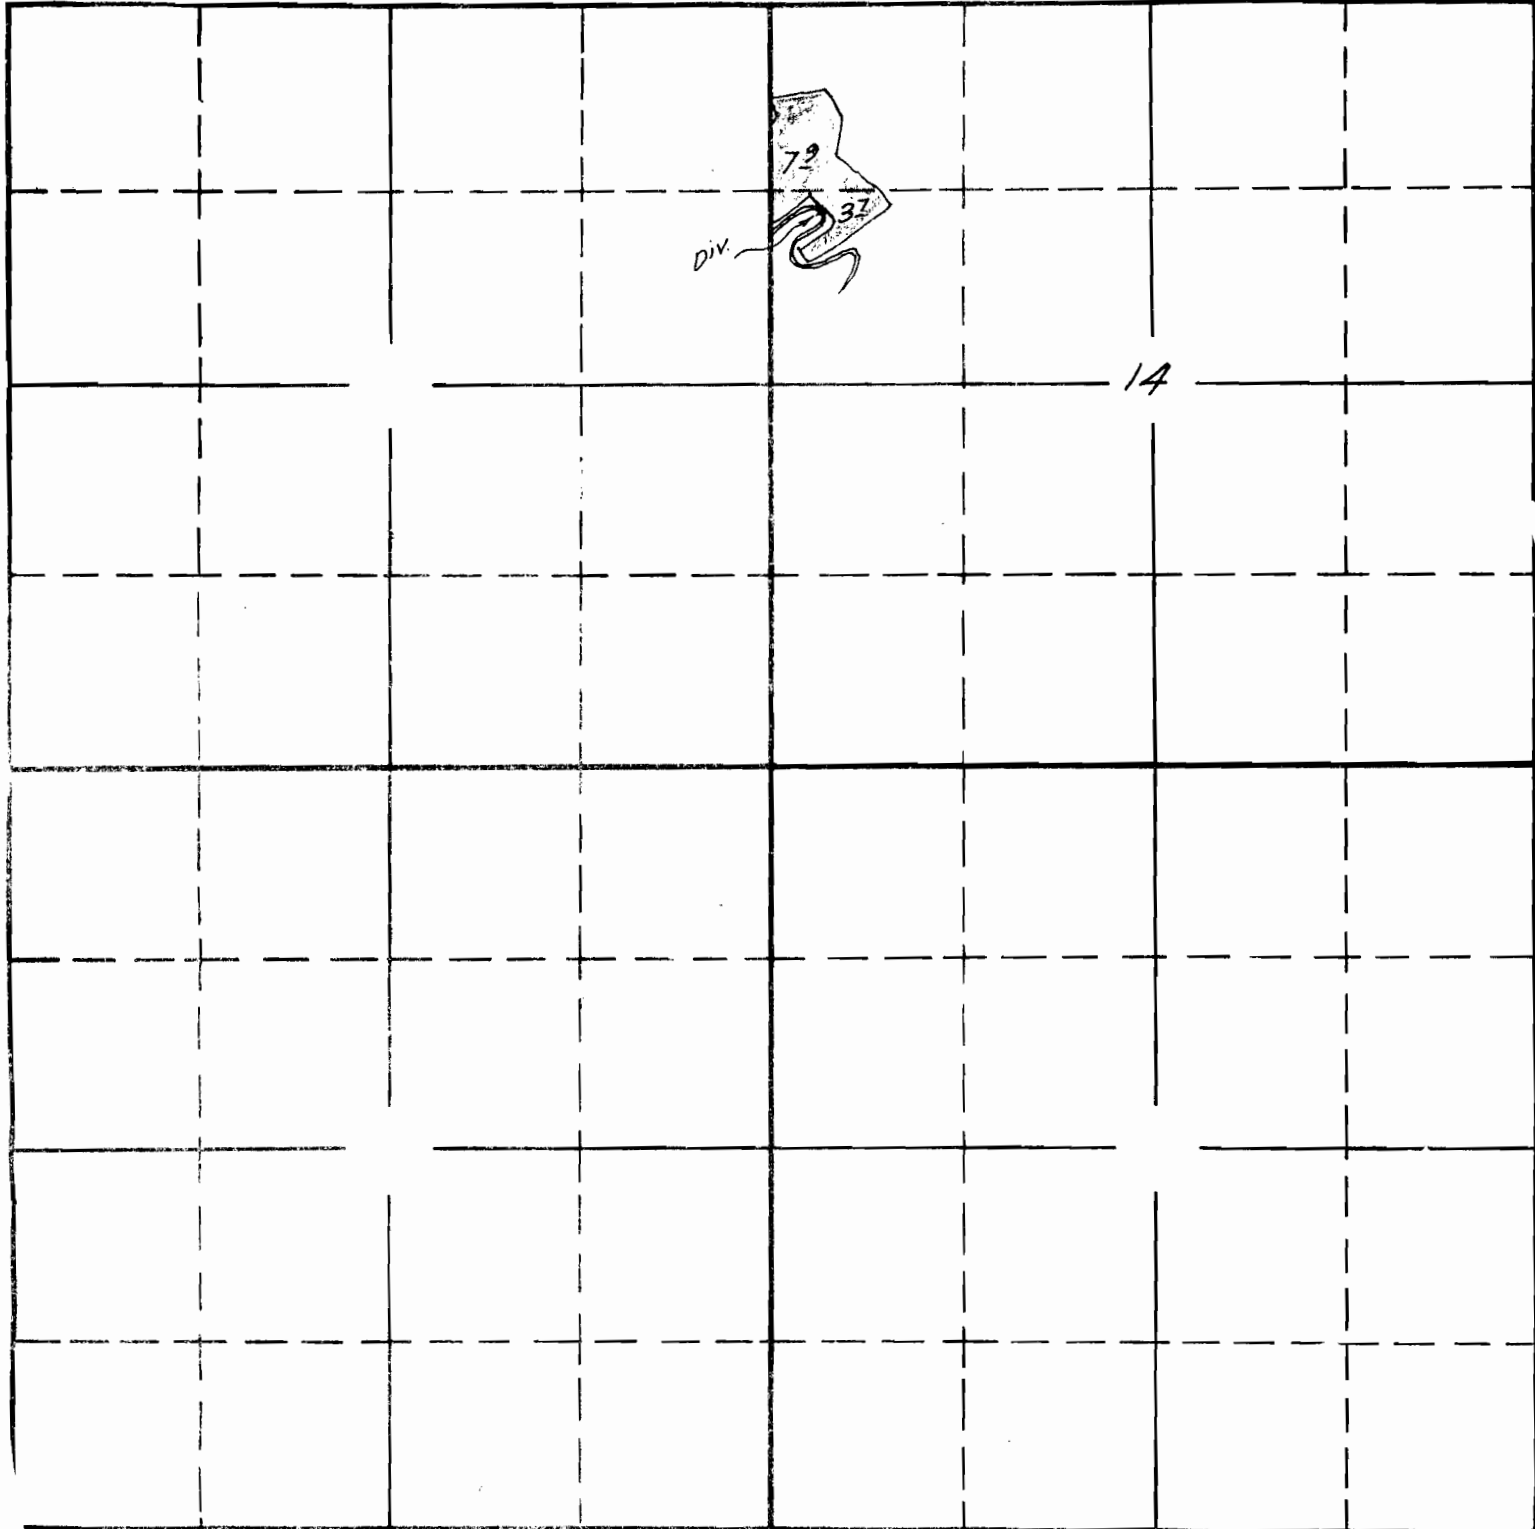

Surveyed May 29 1920 C.L.B.

South

APPLICATION No. 16306  
PERMIT No. 12106