


SECTION

TOWNSHIP 34 S., RANGE 708 W. W. M.

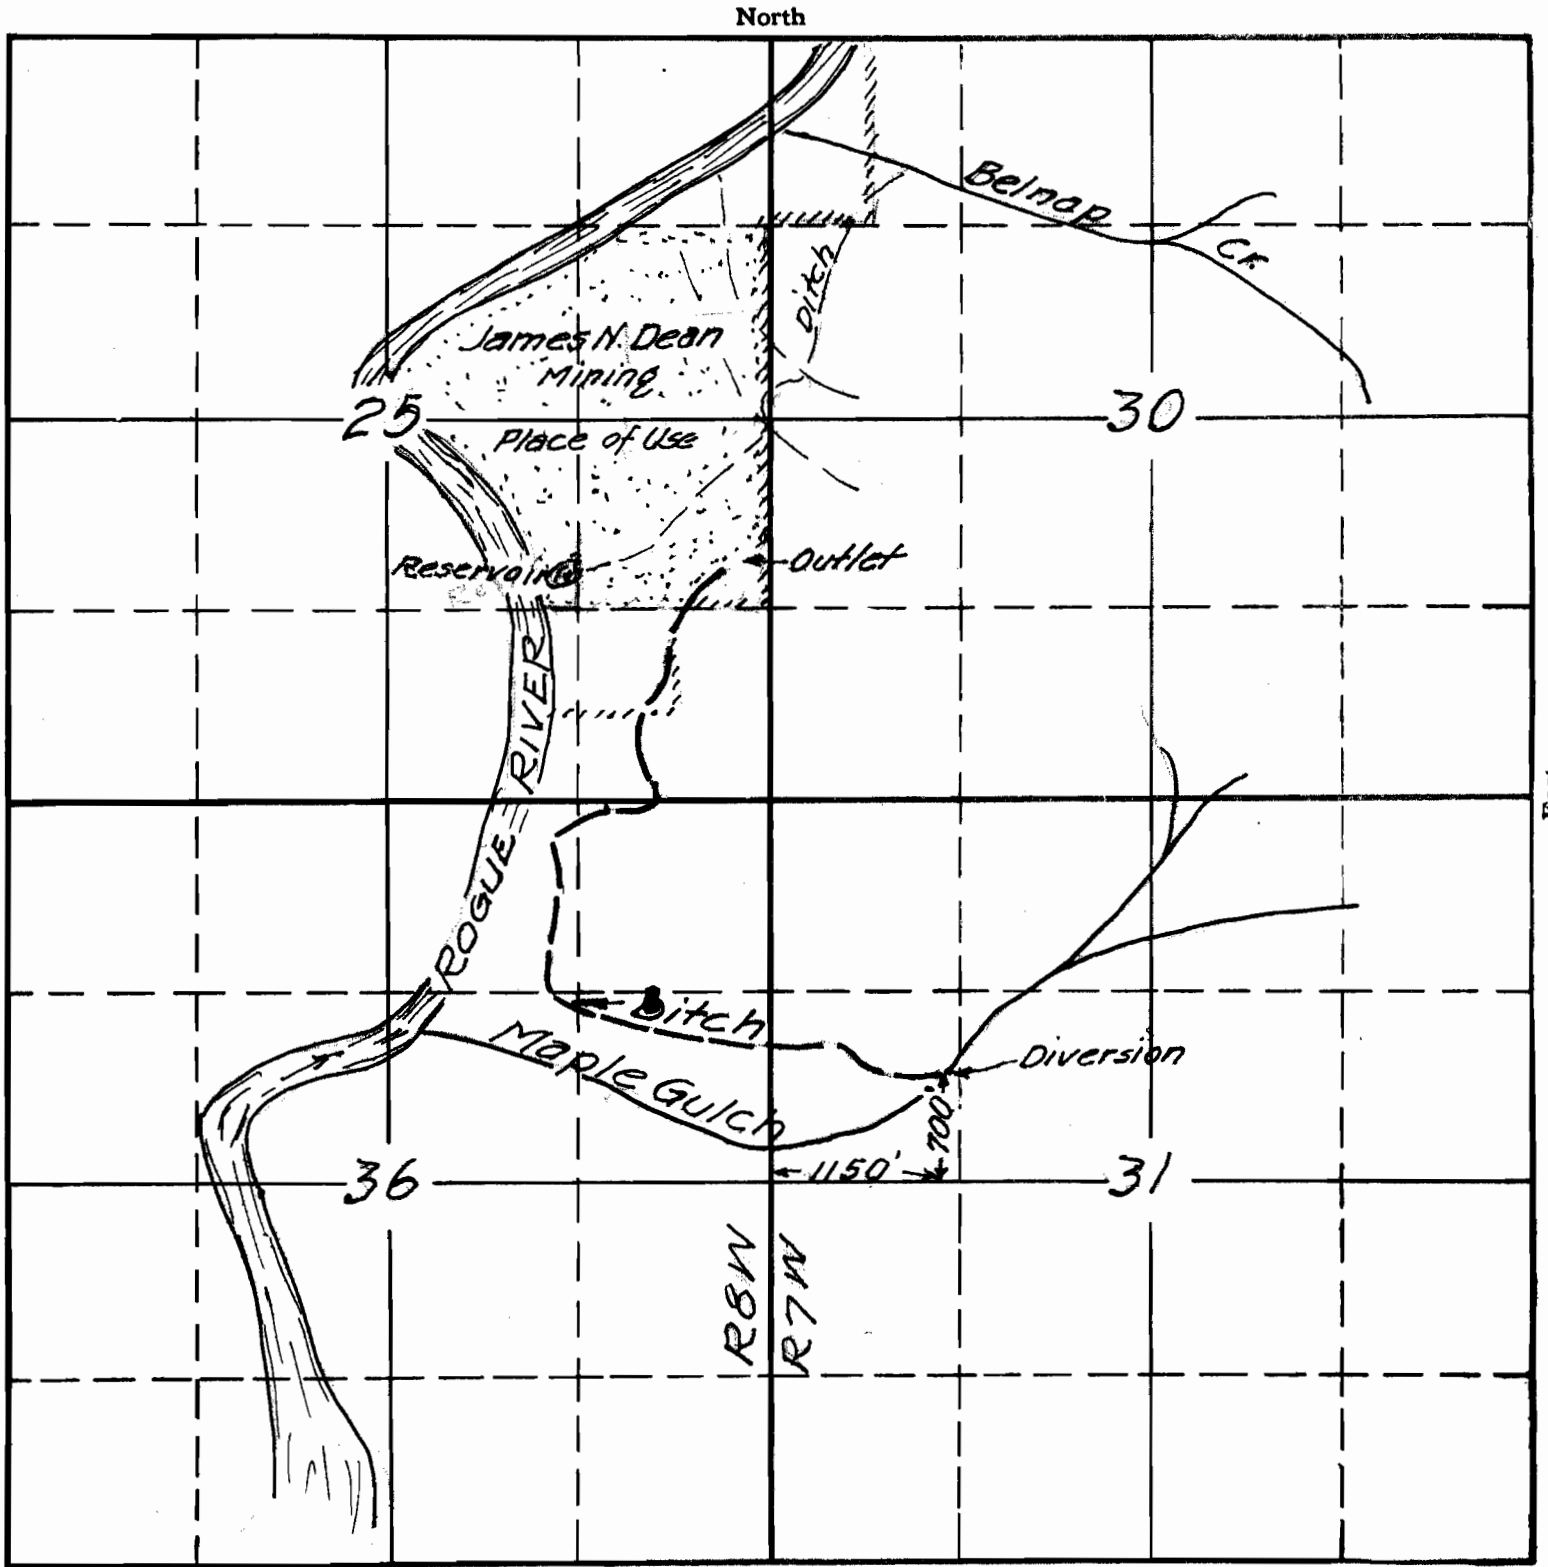

APPLICATION No. 16320  
 PERMIT No. 12126