


SECTION

TOWNSHIP 1N, RANGE 42E, W. M.

North

West

East

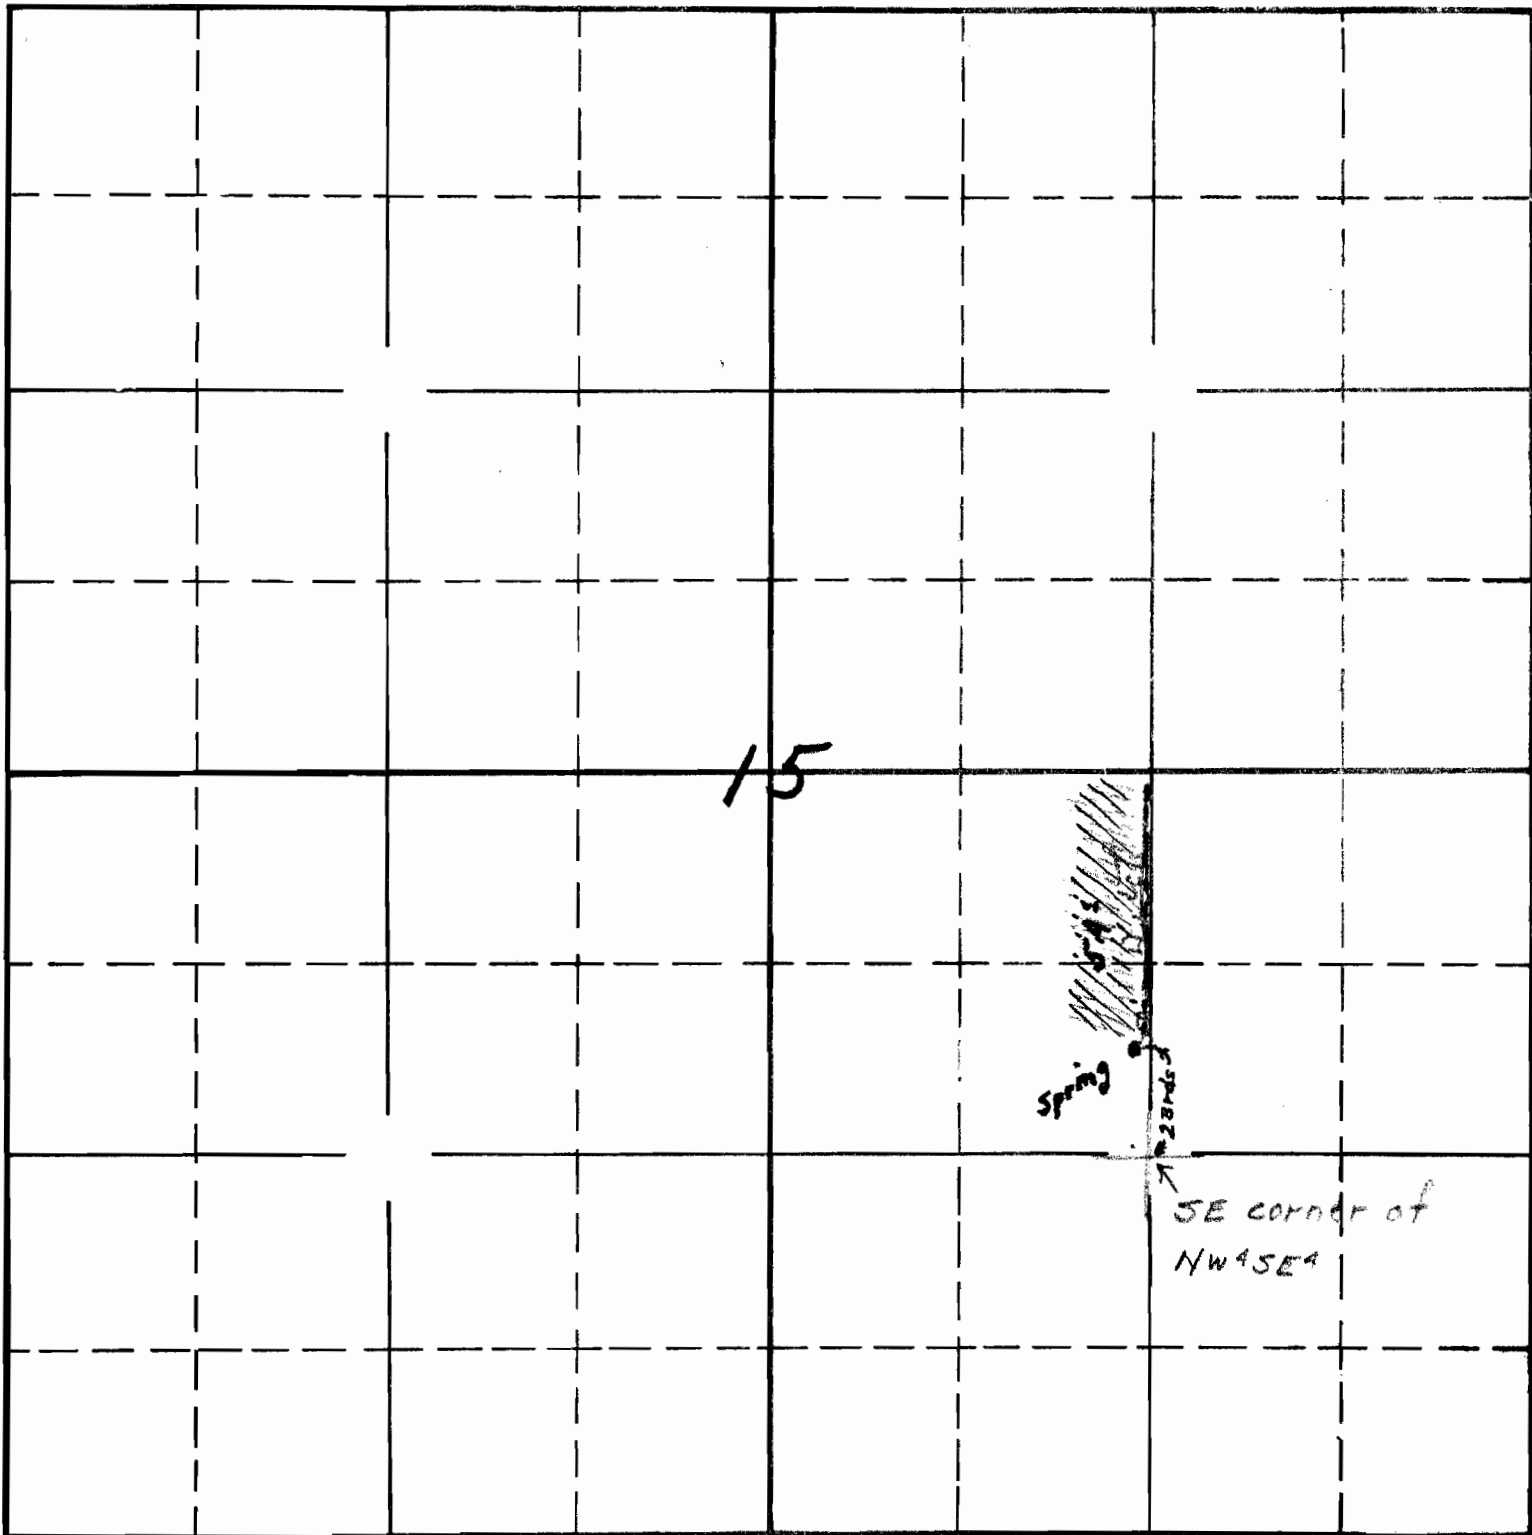

South

8-35-16021-6
APPLICATION No. 16221
PERMIT No. 12127